


KOLB LAND CONSULTING, INC.

LAND SURVEYING • SUBDIVIDING • LAND PLANNING

929 WILLIAMS STREET

LAKE GENEVA, WISCONSIN 53147


414-248-3697

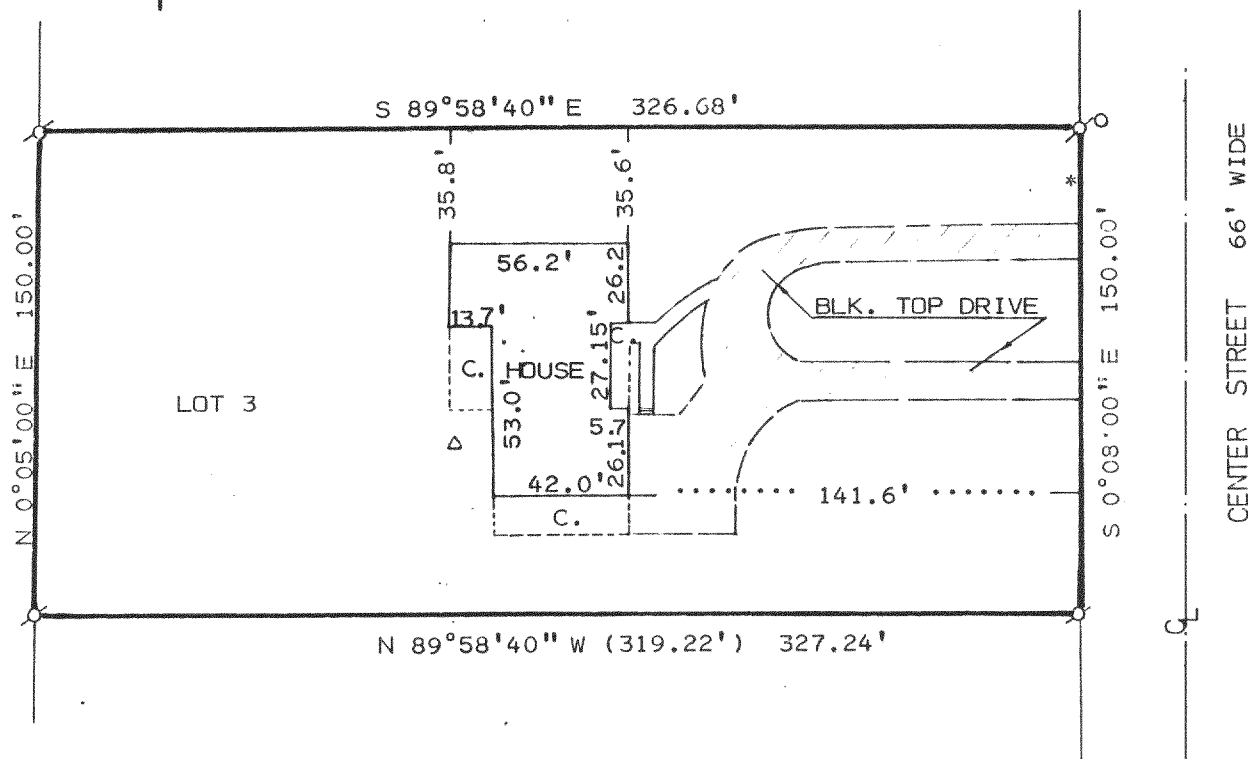

PLAT OF SURVEY OF

LOT 3 OF THOMPSON MEADOWS SUBDIVISION LOCATED IN THE
NORTHEAST 1/4 OF SECTION 25, T2N, R17E, TOWN OF GENEVA,
WALWORTH COUNTY, WISCONSIN.

ORDERED BY: RICHARD THOMPSON %
REALTY WORLD
838 W. MAIN
LAKE GENEVA, WI. 53147

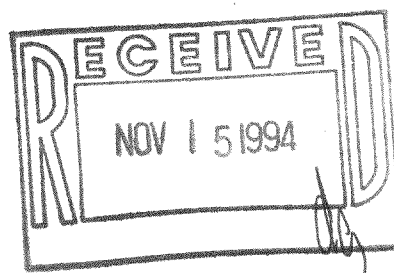

NOTE: THE EAST LINE OF THE NORTHEAST
1/4 OF SECTION 25-2-17 IS
ASSUMED TO BEAR N 0°18'10\" E.



SCALE: 1" = 60'

LEGEND

- ⌀ - IRON PIPE FOUND
- 319.22) - AS RECORDED
- Δ - WELL
- C. - CONCRETE
- * - UTILITY ANCHOR
- O - UTILITY POLE

I HEREBY CERTIFY THAT I HAVE SURVEYED THE
ABOVE DESCRIBED PROPERTY AND THAT THE ABOVE
MAP IS A TRUE REPRESENTATION THEREOF AND
SHOWS THE SIZE AND LOCATION OF THE PROPERTY,
ITS EXTERIOR BOUNDARIES, THE LOCATION OF ALL
VISIBLE STRUCTURES AND DIMENSION OF ALL
PRINCIPAL BUILDINGS THEREON, BOUNDARY FENCES,
APPARENT EASEMENTS, ROADWAYS AND VISIBLE
ENCROACHMENTS, IF ANY, TO THE BEST OF MY
KNOWLEDGE AND BELIEF.
THIS SURVEY IS MADE FOR THE USE OF THE
PRESENT OWNERS OF THE PROPERTY, AND ALSO
THOSE WHO PURCHASE, MORTGAGE, OR GUARANTEE
THE TITLE THERETO WITHIN ONE (1) YEAR FROM
DATE HEREOF. SURVEY NOT VALID UNLESS SURVEYOR'S
SIGNATURE IS IN RED.

HAROLD H. KOLB

WISCONSIN REGISTERED LAND SURVEYOR, S- 187

DATE MARCH 3, 1994

REVISED

REVISED

JTM-3

217-1265 2-17-112A