


Plat of Survey



of
Lots 5820 thru 5827, Block 103 of Lake Como Beach,
located in Section 28, Town 2 North, Range 17 East,
Town of Geneva, Walworth County, Wisconsin.

Surveyed for: **Edward Schenk**
N3287 Hickory Road
Lake Geneva, Wisconsin. 53147

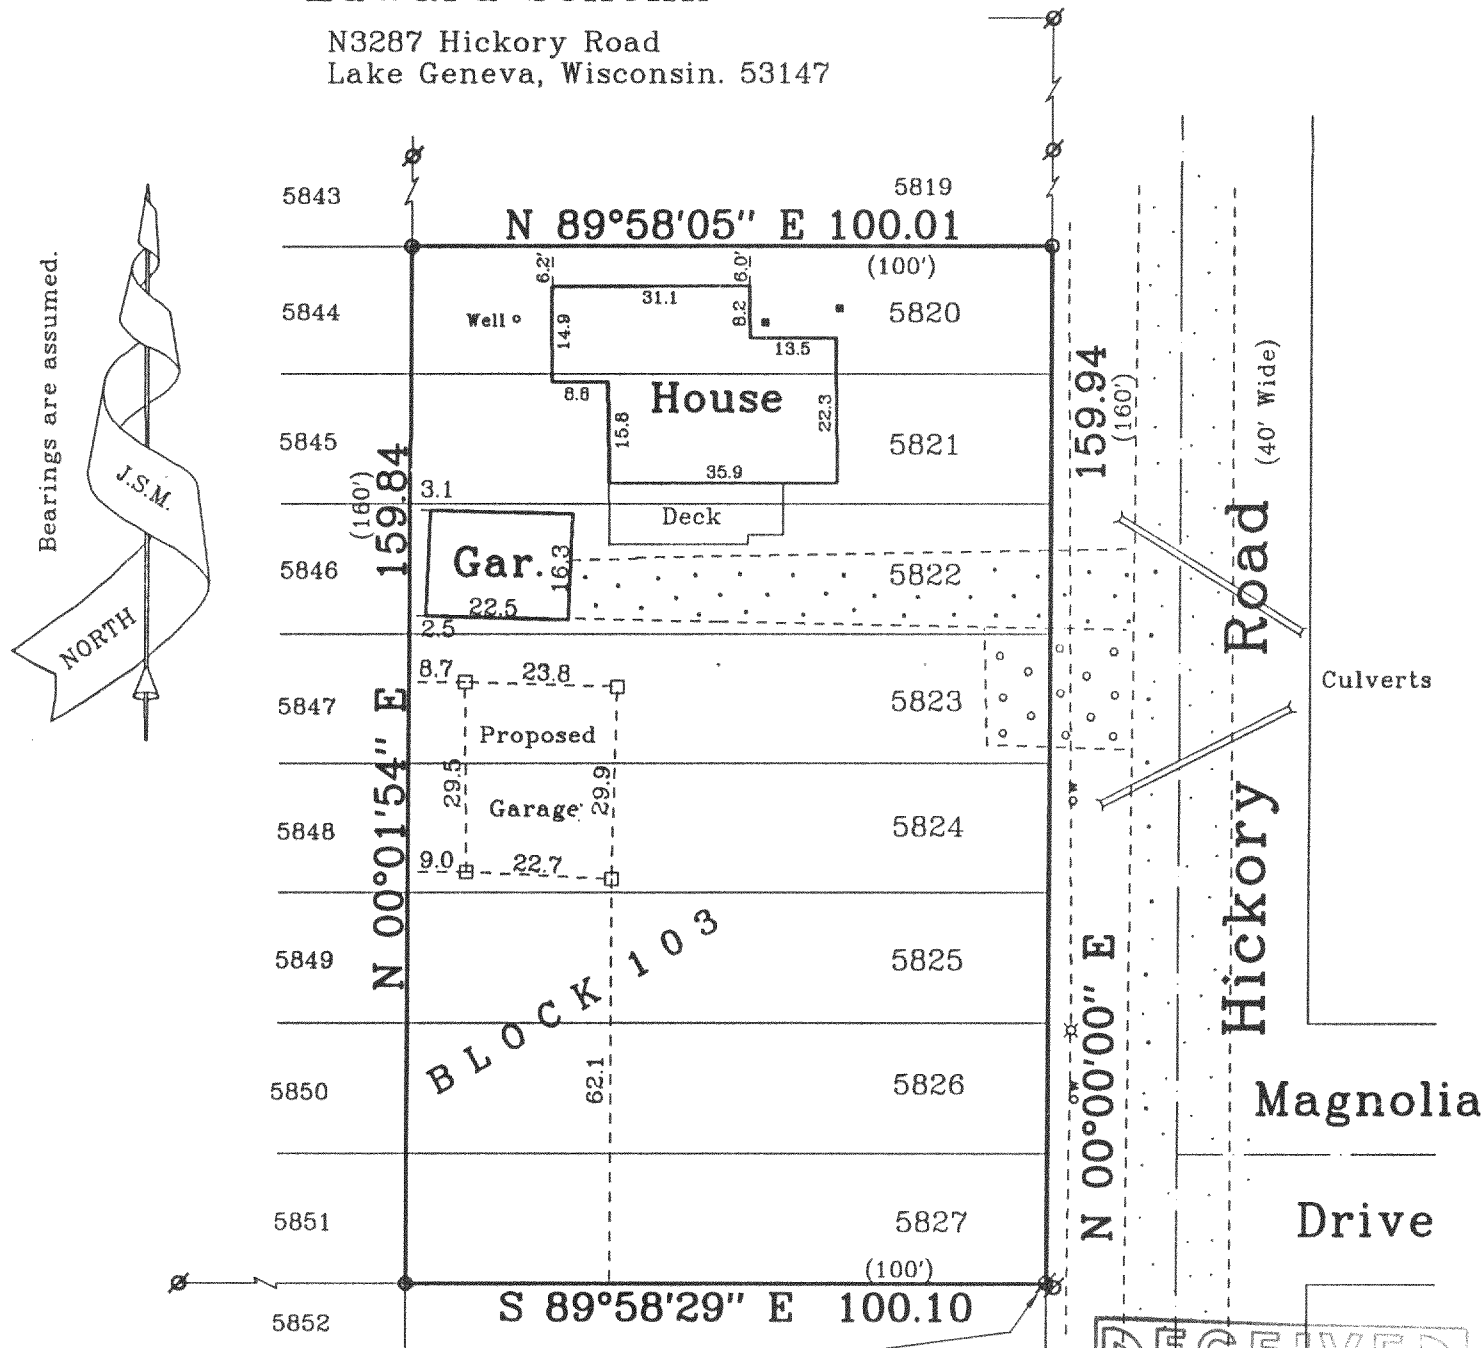

Note: This survey plat is not
certified unless signed
and sealed in red ink.

Leaning pipe is 0.24
North of Corner
Second Pipe is 0.50
South & 1.18 East
of the Corner.

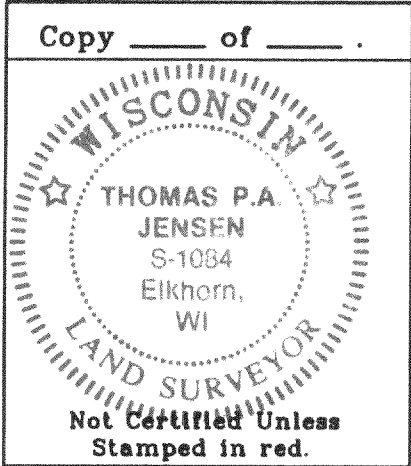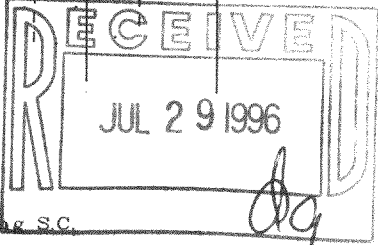


Copyright © 1995 by Jensen Surveying & Mapping S.C.
All rights reserved. No part of this survey plat may be reproduced
or transmitted in any form by any means - graphic, electronic, or
mechanical, including photocopying, tracing, or information storage
and retrieval systems - without permission in writing from Thomas
P.A. Jensen, Jensen Surveying & Mapping S.C..
I, Thomas P.A. Jensen, Wisconsin Registered Land Surveyor, do
hereby certify that this survey was performed by me, or under my
direction in full compliance with the owner's / agent's instructions
and Chapter A-E 7 of the Wisconsin Administrative Code "Minimum
Standards for Property Surveys"; and that this map is as accurate
representation thereof to the best of my knowledge and belief.
Date: Oct. 95
[Signature]
Thomas P.A. Jensen R.L.S. 1084

- Legend**
- ⊗ Found Iron Pipe
 - Set Iron Rod, 3/4" dia.
 - Found Wood Stake
 - () Recorded Information
 - Concrete Cover
 - ▨ Blacktop Surface
 - ▤ Gravel Surface
 - ⋈ Utility Pole

Jensen Surveying & Mapping S.C.
45 South Wisconsin Street P.O. Box 322
Elkhorn, Wisconsin. 53121
Telephone & Facsimile (414) 723-3434

Mapping Date: 10-30-95
Revisions:
Sheet 1 of 1 Sheets
Job Reference No.
1995.095

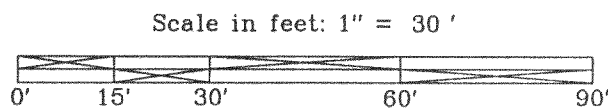

JLCB-1186
217-1391



Plat of Survey

of

Lots 5820 thru 5827, Block 103 of Lake Como Beach,
located in Section 28, Town 2 North, Range 17 East,
Town of Geneva, Walworth County, Wisconsin.


Surveyed for: **Edward Schenk**

N3287 Hickory Road
Lake Geneva, Wisconsin. 53147

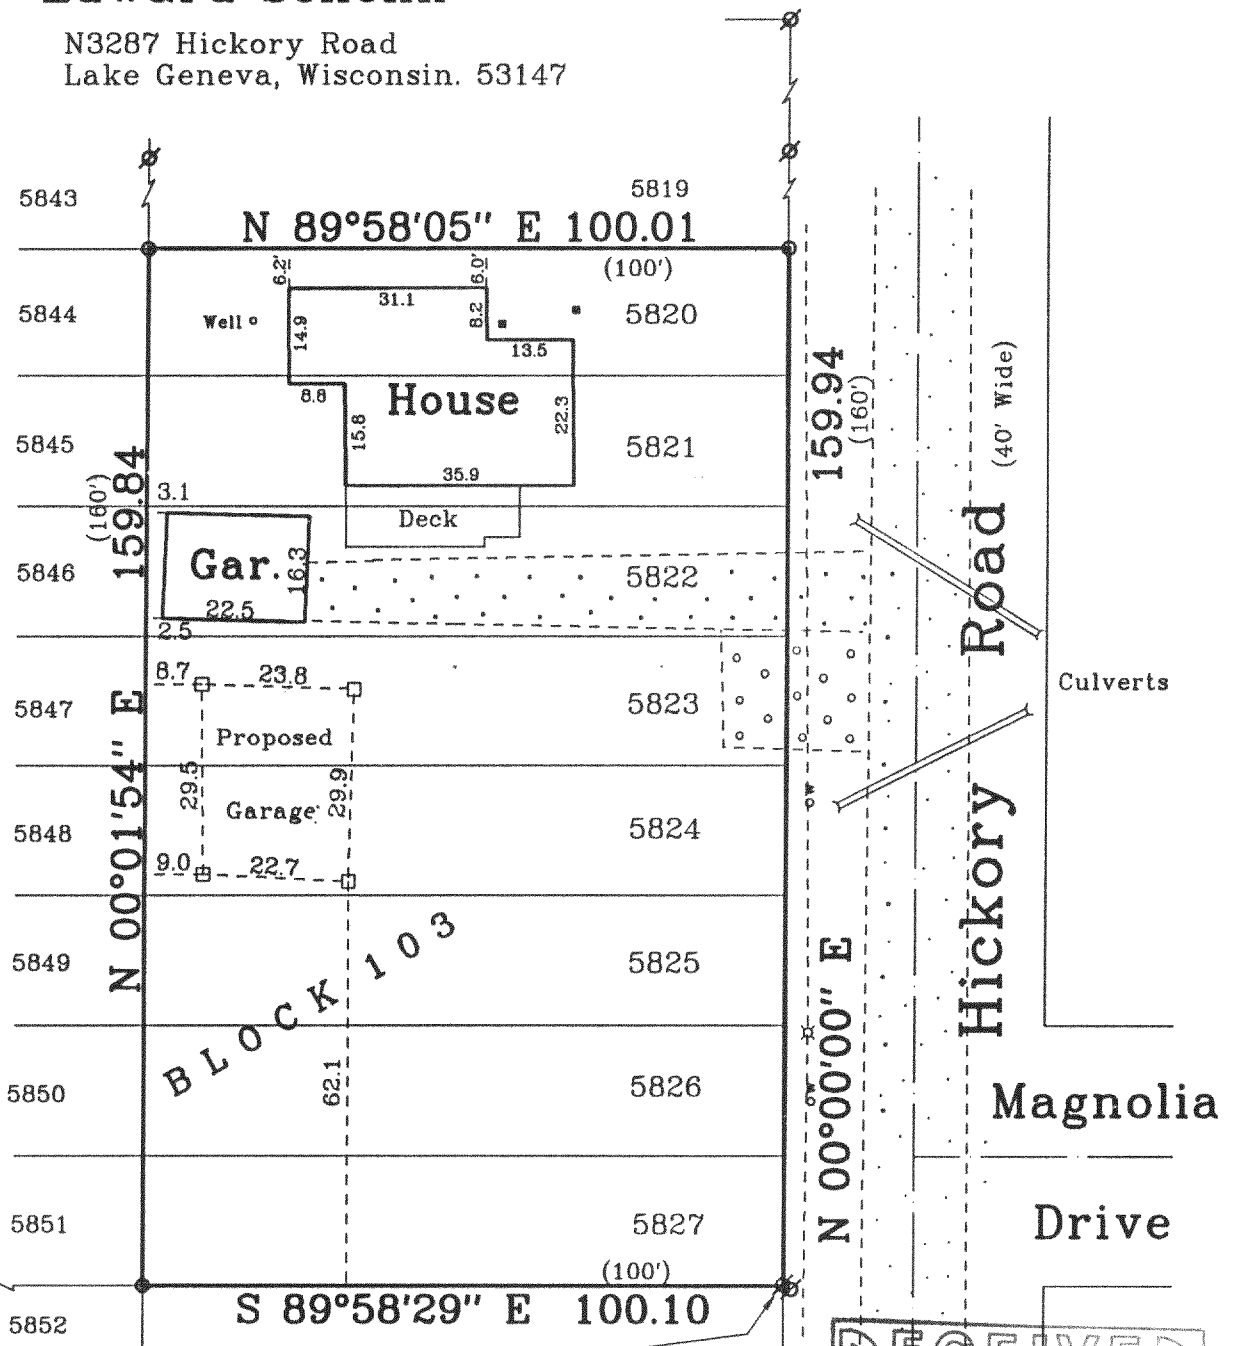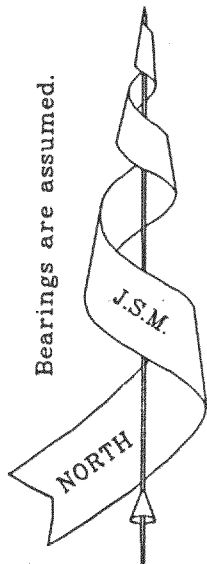

Note: This survey plat is not
certified unless signed
and sealed in red ink.

Copy _____ of _____.

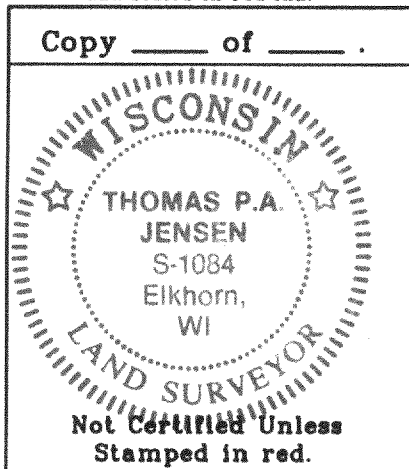

Leaning pipe is 0.24
North of Corner
Second Pipe is 0.50
South & 1.18 East
of the Corner.

Copyright © 1995 by Jensen Surveying & Mapping S.C.

All rights reserved. No part of this survey plat may be reproduced
or transmitted in any form by any means - graphic, electronic, or
mechanical, including photocopying, tracing, or information storage
and retrieval systems - without permission in writing from Thomas
P.A. Jensen, Jensen Surveying & Mapping S.C..

I, Thomas P.A. Jensen, Wisconsin Registered Land Surveyor, do
hereby certify that this survey was performed by me, or under my
direction in full compliance with the owner's / agent's instructions
and Chapter A-E 7 of the Wisconsin Administrative Code "Minimum
Standards for Property Surveys"; and that this map is an accurate
representation thereof to the best of my knowledge and belief.

Date: Oct. 95

Thomas P.A. Jensen
Thomas P.A. Jensen R.L.S. 1084

Legend

- ⊗ Found Iron Pipe
- Set Iron Rod, 3/4" dia.
- Found Wood Stake
- () Recorded Information
- Concrete Cover
- ▨ Blacktop Surface
- ▤ Gravel Surface
- ⊕ Utility Pole

Jensen Surveying & Mapping S.C.

45 South Wisconsin Street P.O. Box 322
Elkhorn, Wisconsin. 53121
Telephone & Facsimile (414) 723-3434

Scale in feet: 1" = 30'



Mapping Date: 10-30-95

Revisions:

Sheet 1 of 1 Sheets

Job Reference No.

1995.095

JLCB-1186

217-1391