


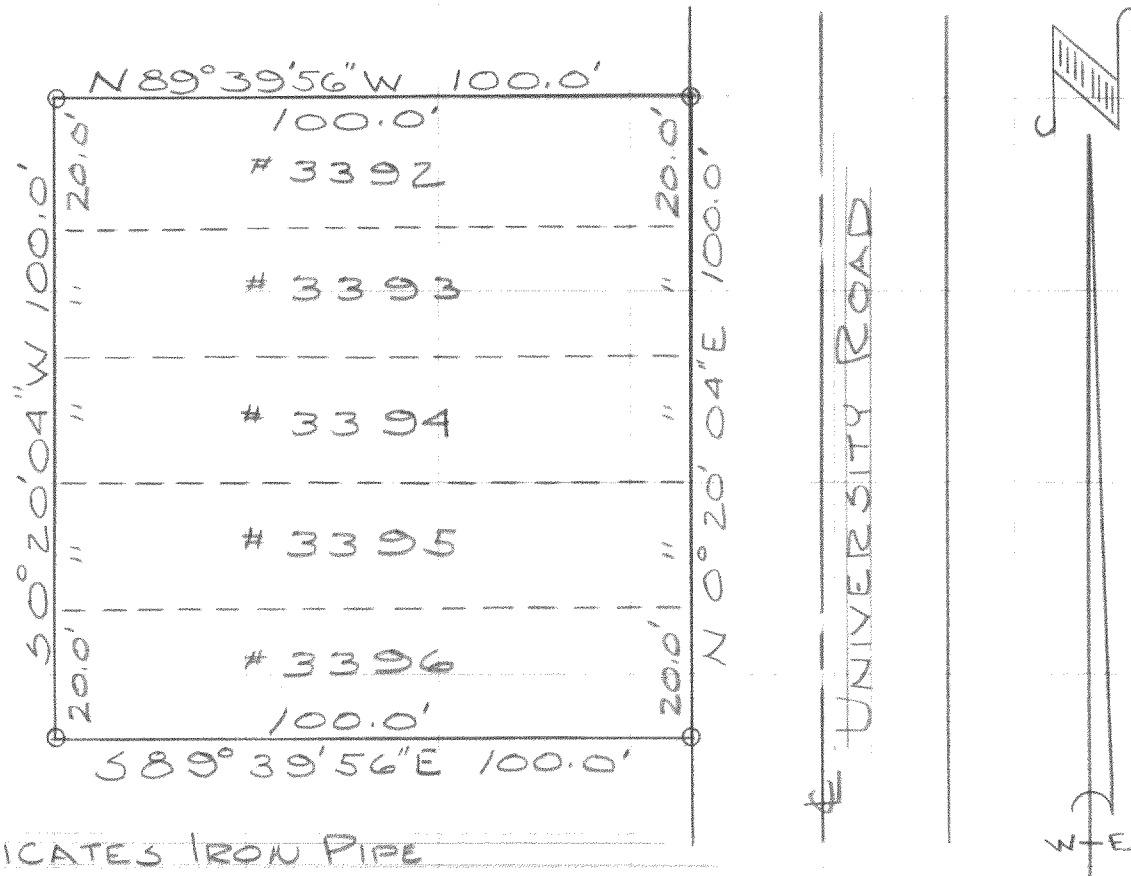

0- INDICATES IRON PIPE

DESCRIPTION: Lots 3392 through 3396, Block 60 of the Second Map of Lake Como Beach Subdivision of a portion of Section 21, Town 2 north, Range 17 east, Walworth County, Wisconsin.

CERTIFICATE: I, James F. Biagi, surveyor, do hereby certify that I have surveyed the property hereon described.

June 17th 1969.

James F. Biagi. RLS 272
Elkhorn, Wisconsin.

