

ABELL
SURVEYING & MAPPING
DELAVER, WISCONSIN 53115
414-728-6737

LINCOLN
DRIVE

S.E. CORNER
BLOCK 94

N.E. CORNER
BLOCK 99

ROAD

DAFFODIL

BLOCK

N



SCALE 1"=30'

LEGEND

- - IRON PIPE FOUND
- - IRON ROD FOUND
- - IRON BAR FOUND
- - IRON PIPE SET
- - UTILITY PEDS.
- * - WIRE FENCE
- () - RECORDED AS

FOUND IRON BAR 0.04' NORTH
AND 0.37' WEST OF CORNER

METAL COVER

SHED

HOUSE

CONCRETE COVER

FENCE CORNER 0.4' SOUTH
AND 0.4' EAST OF LINE

END OF FENCE 2.8'
SOUTH OF LINE

PLAT OF SURVEY OF


LOTS 5507-5517, BLOCK 99, LAKE COMO BEACH SUBDIVISION,
LOCATED IN T2N, R17E, WALWORTH COUNTY, WISCONSIN.

I, DAVID F. ABELL, DO HEREBY CERTIFY THAT I HAVE SURVEYED THE PROPERTY HEREON
DESCRIBED ACCORDING TO THE OFFICIAL RECORDS AND THAT THE PLAT HEREON IS A
CORRECT REPRESENTATION OF THE PROPERTY LINES TO THE BEST OF MY KNOWLEDGE AND
BELIEF.

David F. Abell

DAVID F. ABELL
WISCONSIN REGISTERED LAND SURVEYOR, S-1596

ORDERED BY: ALBERT HASENFANG
7915 W. 120th STREET
PALOS PARK, IL 60464

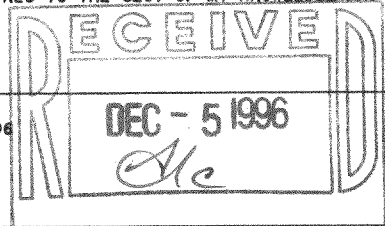

July 19, 1996

DATE JOB NUMBER - 96110
NOTE: THIS IS NOT A CERTIFIED COPY UNLESS SEALED.

JLCB-1117
217-1422