

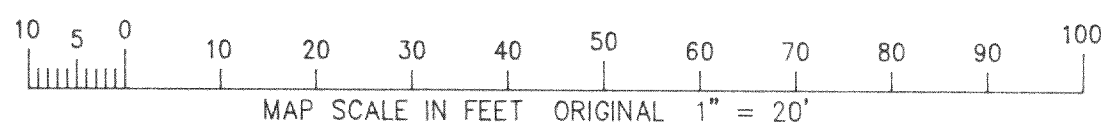


PLAT OF SURVEY

LOTS 11582 THRU 11598 AND LOTS 11617 THRU 11620
OF THE FIFTH MAP OF LAKE COMO BEACH
A SUBDIVISION LOCATED IN SEC. 29, TOWN 2 NORTH, RANGE 17 EAST
WALWORTH COUNTY, WISCONSIN

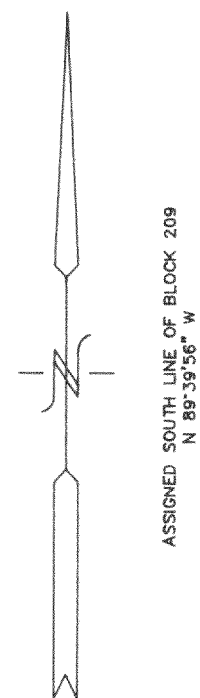

LEGEND
 • FOUND IRON REBAR
 ○ SET IRON REBAR STAKE
 — UTILITY POLE
 — OVERHEAD WIRES
 () RECORDED AS

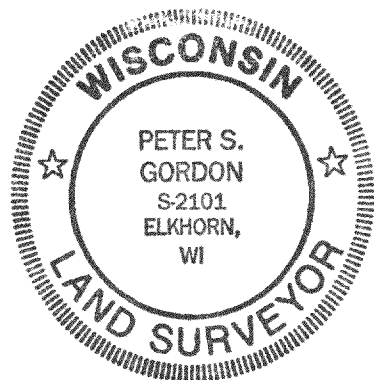


NOTE: COPIES OF THIS MAP TO WHICH THE FOLLOWING CERTIFICATE WILL APPLY ARE BLUE LINE PRINTS SHOWING SURVEYOR'S ORIGINAL SEAL AND SIGNATURE IN BLACK INK. COPIES BY ANY OTHER MEANS MAY HAVE ALTERATIONS WHICH DO NOT REPRESENT THE SURVEYOR'S WORK PRODUCT.

I HEREBY CERTIFY THAT THE ABOVE DESCRIBED PROPERTY HAS BEEN SURVEYED UNDER MY DIRECTION AND THAT THE ABOVE MAP IS A TRUE REPRESENTATION THEREOF AND SHOWS THE SIZE AND LOCATION OF THE PROPERTY AND ITS EXTERIOR BOUNDARIES. THIS SURVEY IS MADE FOR THE USE OF THE PRESENT OWNERS OF THE PROPERTY, AND ALSO THOSE WHO PURCHASE, MORTGAGE, OR GUARANTEE THE TITLE THERETO WITHIN ONE YEAR FROM THE DATE HEREOF.


DATED: 5/19/97

Peter S. Gordon
 PETER S. GORDON R.L.S. 2101

BEGONIA ROAD
 (40' WIDE)

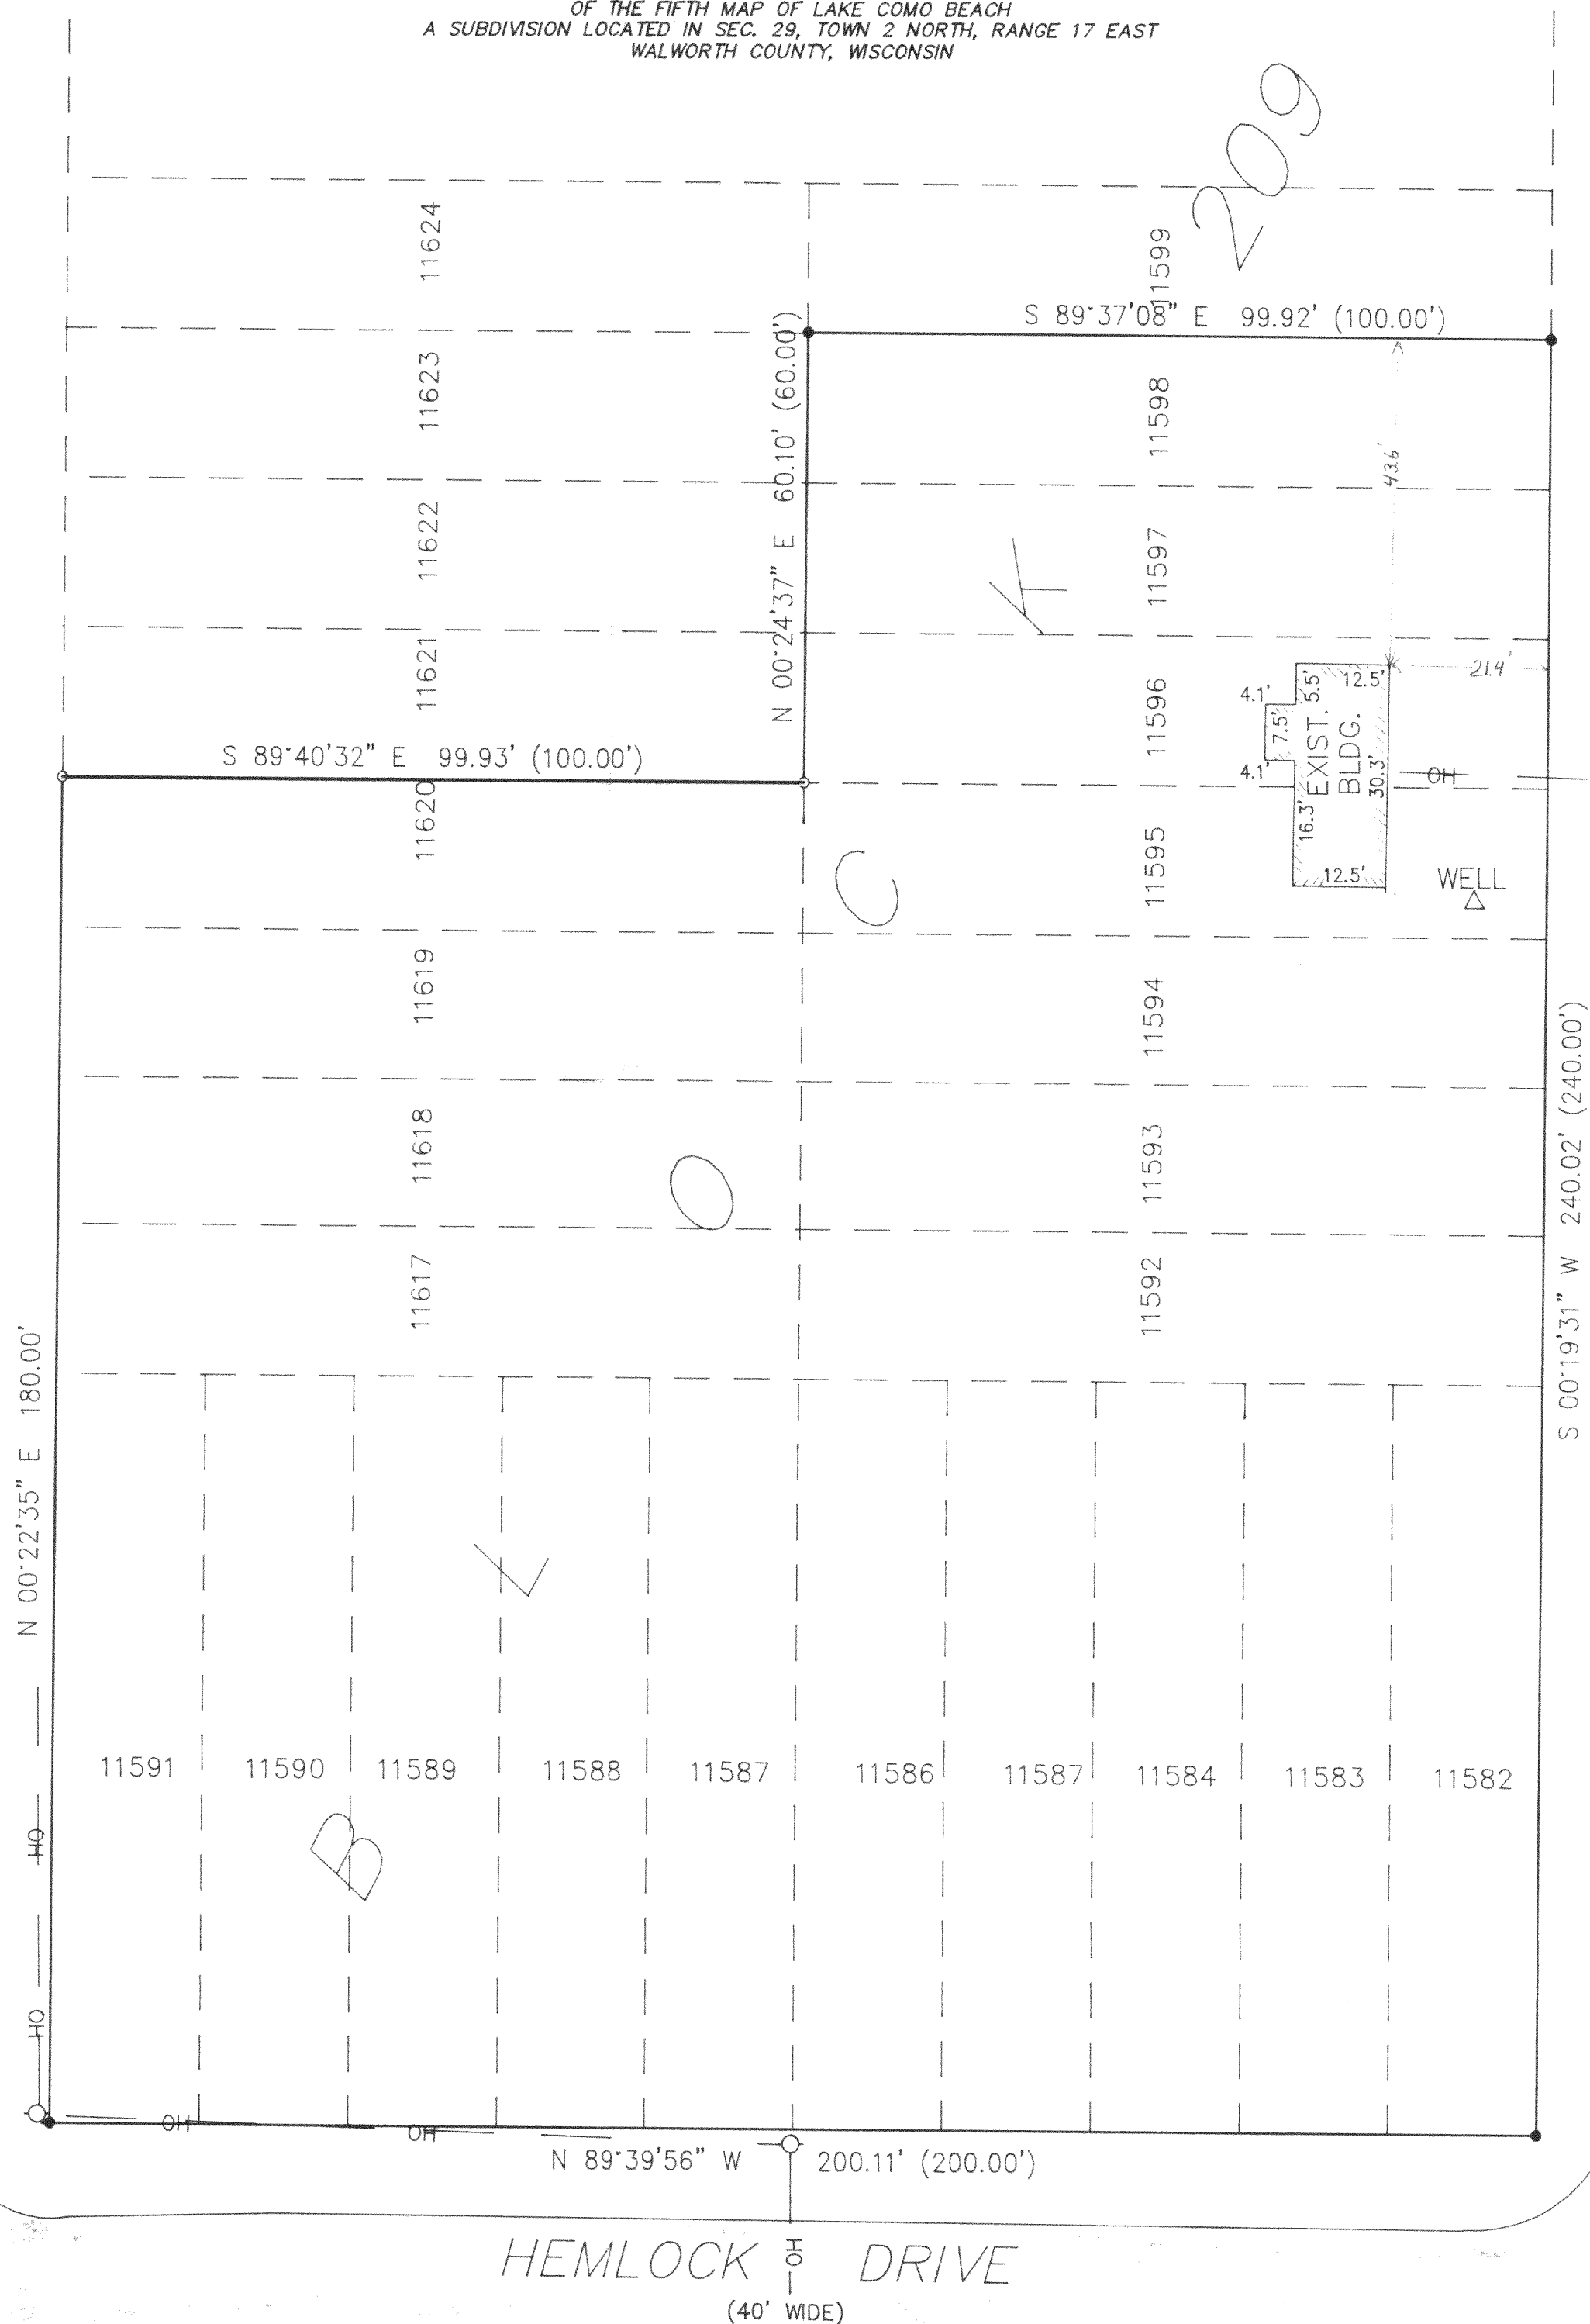

APRICOT ROAD
 (40' WIDE)

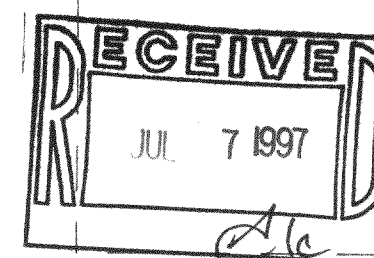

WORK ORDERED BY:
 WALLY BIEZE
 5889 NORTH ROGERS
 CHICAGO, ILLINOIS 60646

FARRIS, HANSEN & ASSOCIATES, INC.
 Engineering, Architecture, Surveying
 7 Ridgway Court P.O. Box 437
 ELKHORN, WISCONSIN 53121
 Office: (414) 723-2098
 Fax: (414) 723-5886

REVISIONS

PROJECT NO.
 4765
 DATE:
 5/19/97
 SHEET NO.
 1 OF 1