


PLAT OF SURVEY

No. 5156

DESCRIPTION: Lots 5323, 5324, 5325 & 5326, Block 95, Lake Como Beach Subdivision, a part of Section 21, Town 2 North, Range 17 East, Geneva Twp., Walworth County, Wisconsin.

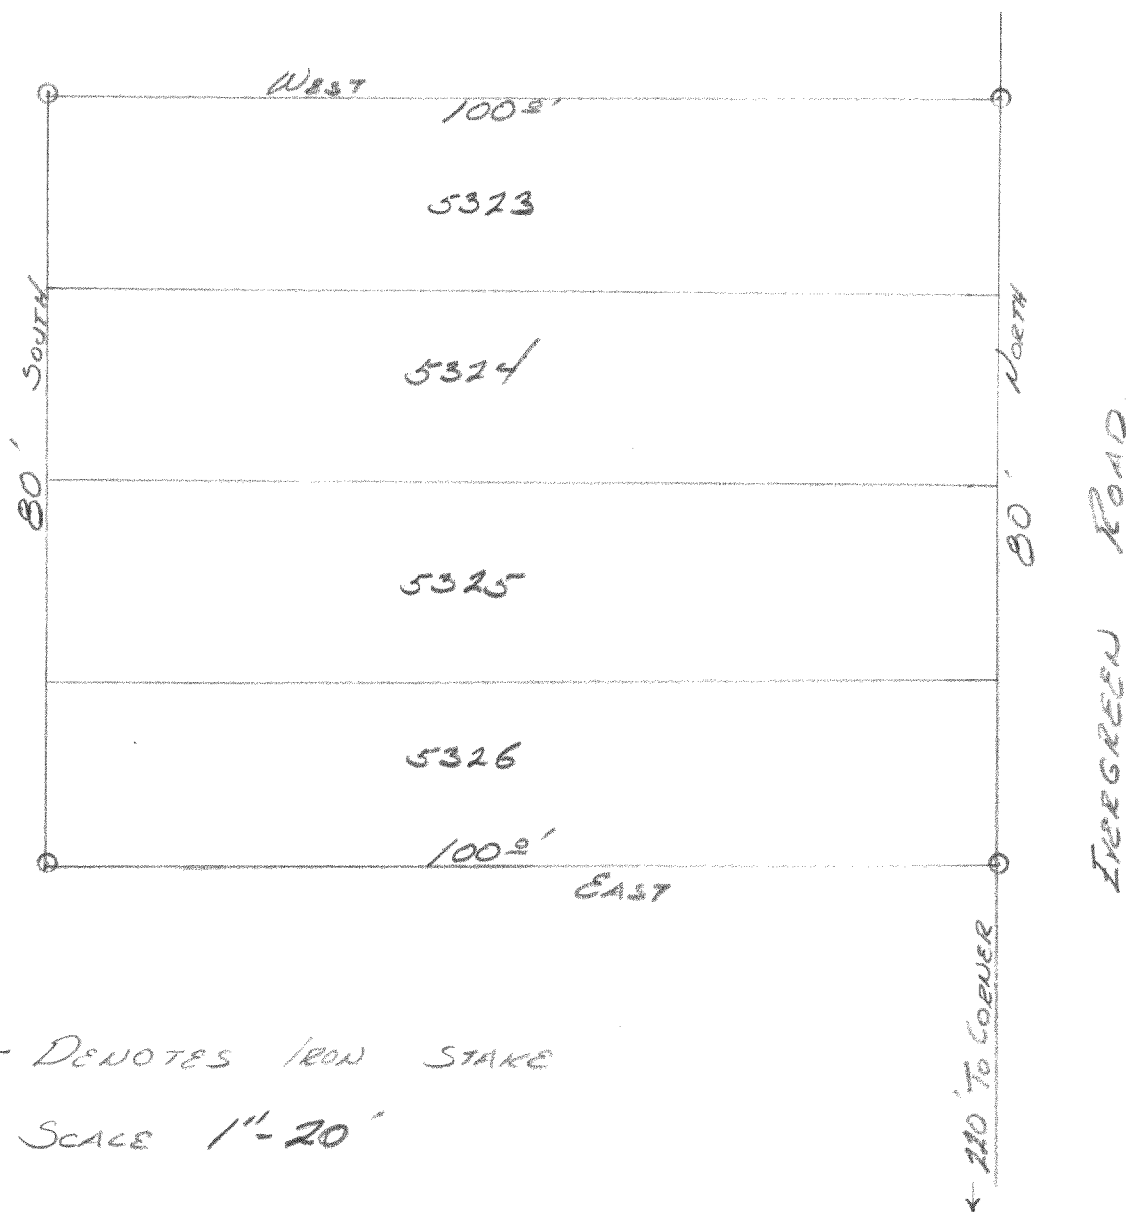

CERTIFICATE: I hereby certify that I have on this the 15th day of May, 1956 surveyed the above described property at the request of the owner, and that the above description and drawing are in accordance with the records on file in the Register of Deeds Office, Walworth County, Wisconsin.

Signed James F. B. Agi
Surveyor

Signed James F. B. Agi
Registered Land Surveyor (No. 272)

JLB-1072

217-148B