

# FARRIS, HANSEN & ASSOCIATES, INC.

7 RIDGEWAY COURT, P.O. BOX 437  
ELKHORN, WISCONSIN 53121

## PLAT OF SURVEY

PHONE  
FAX:

(414) 723 2098  
(414) 723 5886

UNIT 04 - 06

GENEVA NATIONAL GOLF CLUB

WORK ORDERED BY: BARB ROZENER

1116 ROYAL BIRKDALE CT.  
LAKE GENEVA, WI 53147

### MAP LEGEND

- = IRON PIPE STAKE FOUND
- = IRON PIPE STAKE SET
- O = IRON ROD STAKE FOUND
- = IRON ROD STAKE SET
- = CONCRETE MONUMENT FOUND
- = RECORD DIMENSION


(XXXXX)

ROYAL BIRKDALE COURT  
66' WIDE PRIVATE ROADWAY

UNIT  
04-07



WISCONSIN COORDINATE SYSTEM

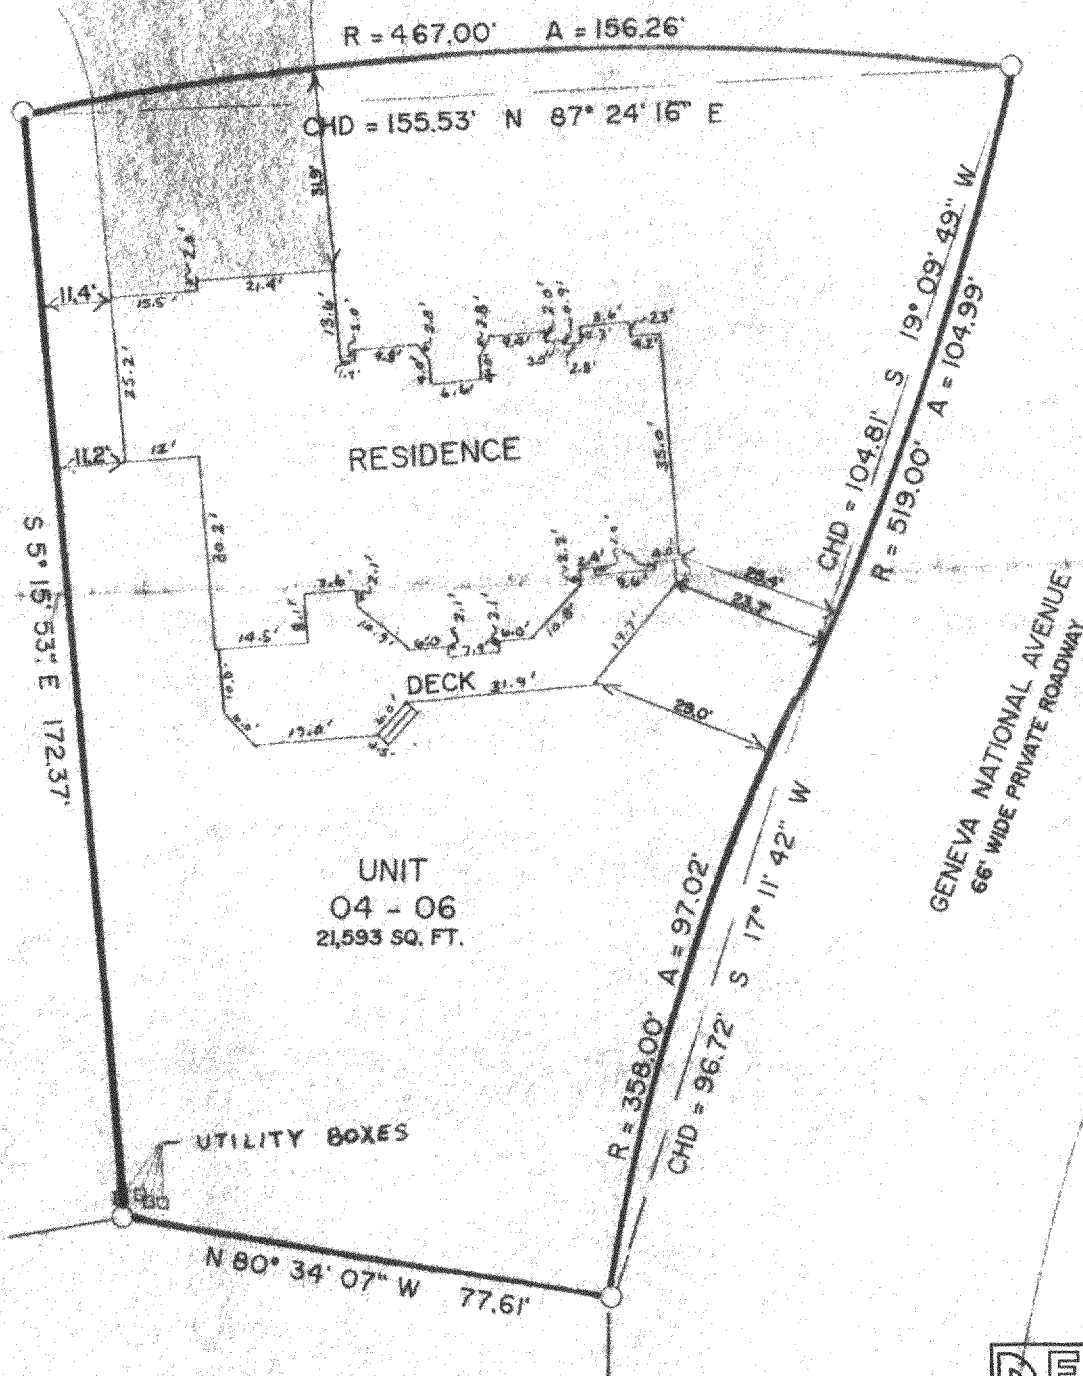

UNIT  
04 - 06  
21,593 SQ. FT.


UTILITY BOXES

N 80° 34' 07\" W 77.61'

UNIT  
04-05



MAP SCALE IN FEET  
ORIGINAL 1" = 30'

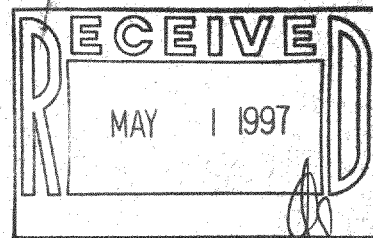


NOTE: COPIES OF THIS MAP TO WHICH THE FOLLOWING CERTIFICATE WILL APPLY ARE BLUE LINE PRINTS SHOWING SURVEYOR'S ORIGINAL SEAL AND SIGNATURE IN BLACK INK. COPIES BY ANY OTHER MEANS MAY HAVE ALTERATIONS WHICH DO NOT REPRESENT THE SURVEYOR'S WORK PRODUCT.

I HEREBY CERTIFY THAT THE ABOVE DESCRIBED PROPERTY HAS BEEN SURVEYED UNDER MY DIRECTION AND THAT THE ABOVE MAP IS A TRUE REPRESENTATION THEREOF AND SHOWS THE SIZE AND LOCATION OF THE PROPERTY AND ITS EXTERIOR BOUNDARIES. THIS SURVEY IS MADE FOR THE USE OF THE PRESENT OWNERS OF THE PROPERTY, AND ALSO THOSE WHO PURCHASE, MORTGAGE, OR GUARANTEE THE TITLE THERETO WITHIN ONE YEAR FROM THE DATE HEREOF.

DATED: 11/11/93

REVISED: 3/13/97

*Peter S. Gordon*

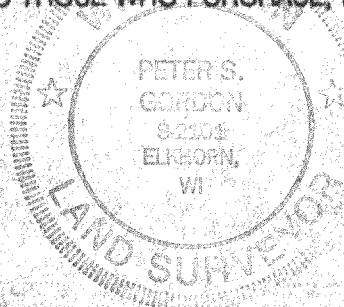

PROJECT NO. 3269 04-06

JGN-4-6  
217-1523