


ROAD.

POPLAR

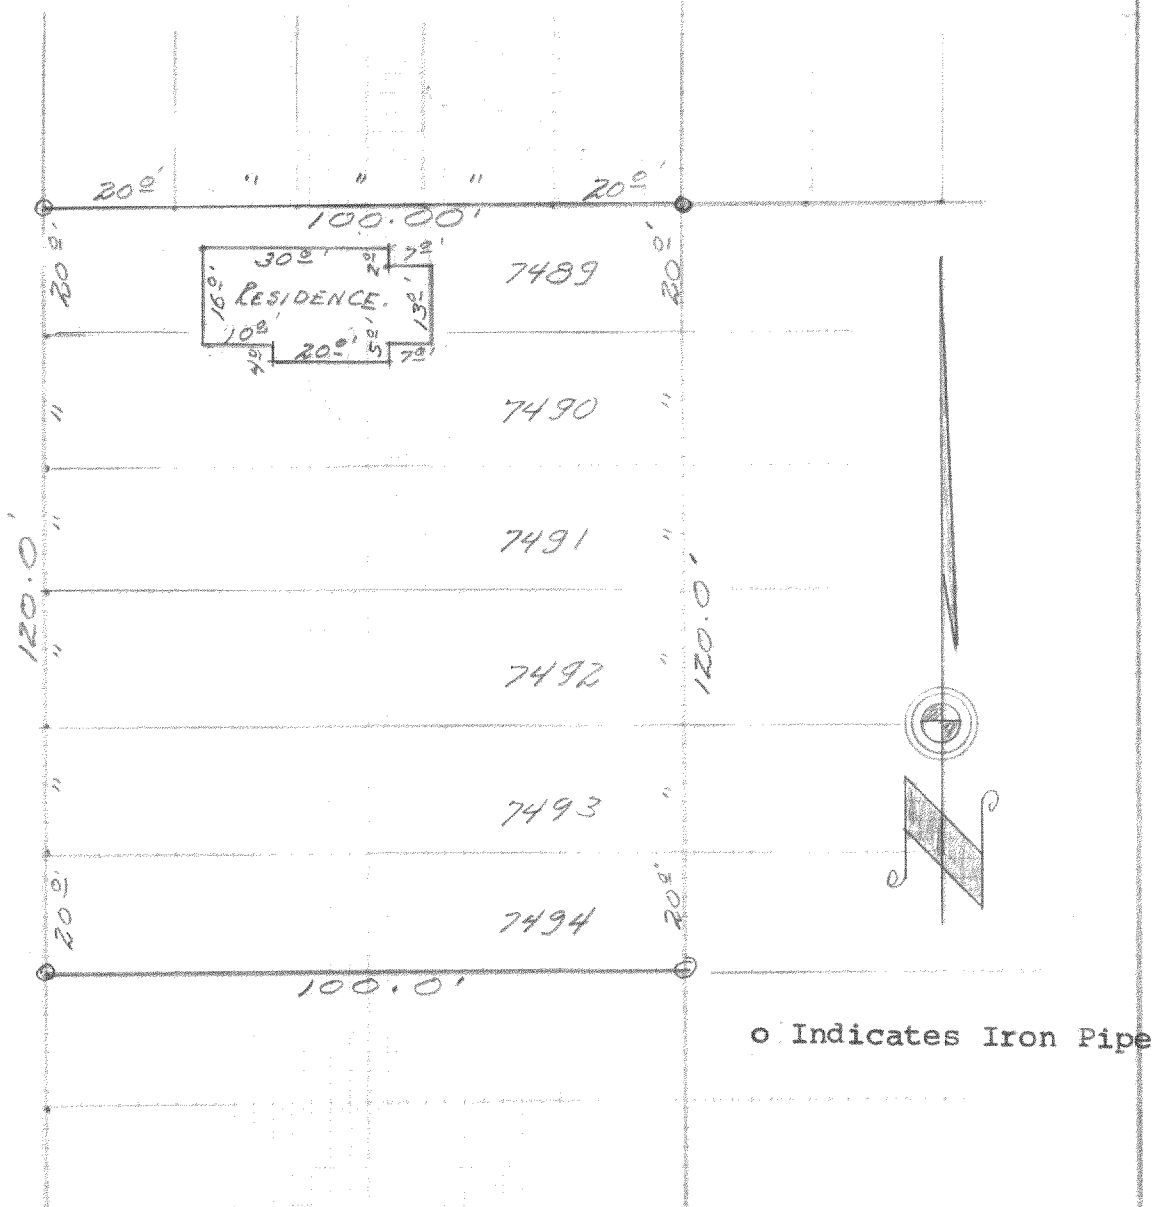

DESCRIPTION: Lots 7489 through 7494 inclusive Lake Como Beach Subdivision of a portion of Sections 21, 22, 27 and 28, Town 2 north Range 17 east Geneva Township, Walworth County, Wisconsin.

CERTIFICATE:

I, James F. Biagi, surveyor do hereby certify that I have the property hereon described.

Dated this 12th day of September 1969. James F. Biagi, RLS 217
Elkhorn, Wisconsin.

