

ABELL
SURVEYING & MAPPING
1140 SEQUOIA STREET • DELAVAN, WISCONSIN 53115
414-728-6737


3/4" DIA.
I.P. FOUND
N.W. CORNER
BLOCK 171

PLAT OF SURVEY OF

THE NORTH 1/2 OF LOT 9612 AND LOTS
9613-9619, BLOCK 173, LAKE COMO
BEACH SUBDIVISION, T2N, R17E, WALWORTH
COUNTY, WISCONSIN.

IRON PIPE FOUND 0.11'
SOUTH AND 1.85' EAST
OF CORNER

ELFIN
PLACE

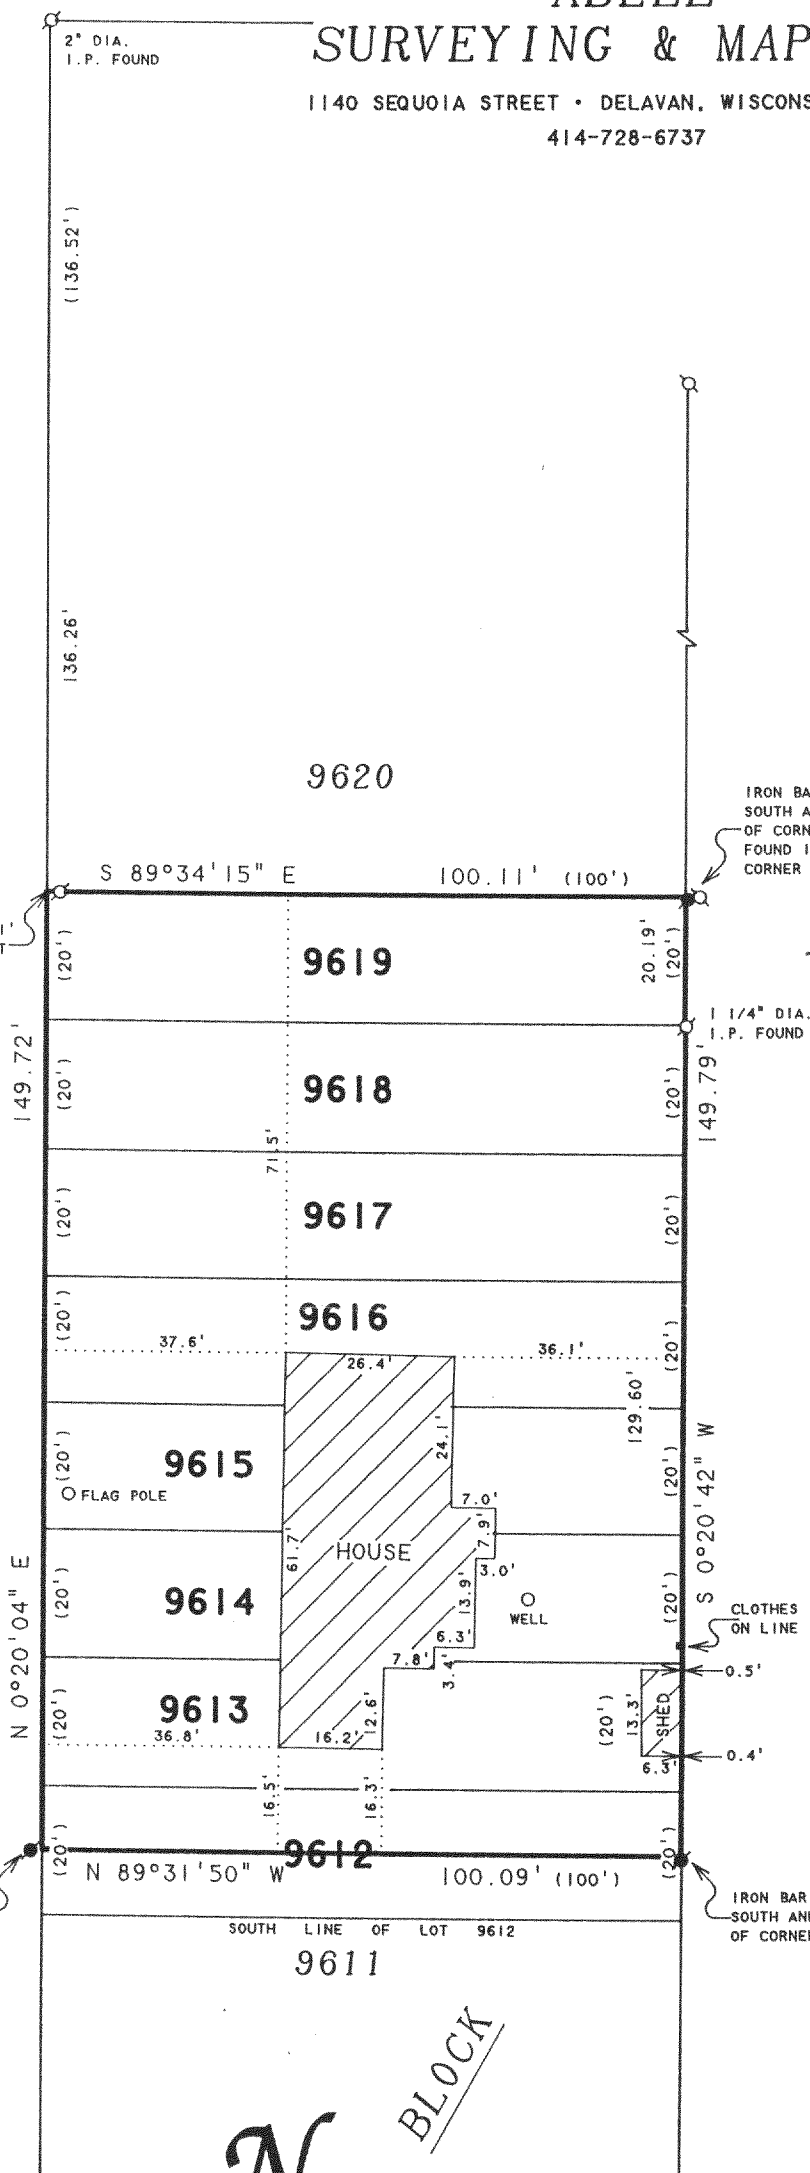

IRON BAR FOUND 0.43'
SOUTH AND 0.12' EAST
OF CORNER, IRON PIPE
FOUND 1.55' EAST OF
CORNER

1 1/4" DIA.
I.P. FOUND

173

ORDERED BY: ZELL WOODWORKING
1299 CENTER ST.
DELAVAN, WI 53115

NOTE: BEARINGS ARE REFERENCED TO THE
RECORDED SUBDIVISION PLAT.

IRON BAR FOUND 0.16'
SOUTH AND 2.08' WEST
OF CORNER

4 0'

N



SCALE 1"=30'

LEGEND

- Q - 1 1/2" DIA. IRON PIPE
FOUND UNLESS OTHERWISE
NOTED
- () - RECORDED AS


I, DAVID F. ABELL, DO HEREBY CERTIFY THAT I HAVE SURVEYED THE PROPERTY HEREON
DESCRIBED ACCORDING TO THE OFFICAL RECORDS AND THAT THE PLAT HEREON IS A
CORRECT REPRESENTATION OF THE PROPERTY LINES TO THE BEST OF MY KNOWLEDGE AND
BELIEF.

David F. Abell

DAVID F. ABELL
WISCONSIN REGISTERED LAND SURVEYOR, S-1596

February 4, 1998

DATE JOB NUMBER - 98008
NOTE: THIS IS NOT A CERTIFIED COPY UNLESS SEALED.

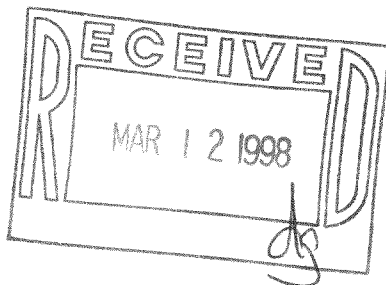

JLB-2073 217-1622