


PLAT OF SURVEY

PATHFINDER SURVEYING
FORMERLY KOLB LAND CONSULTING
929 WILLIAMS STREET LAKE GENEVA, WI. 53147
(414) 248-3697

ORDERED BY: SANDRA BANASZAK
N 3168 QUAIL ROAD
LAKE GENEVA, WI. 53147


DATE: 10/26/1998

DESCRIPTION: LOTS 7818, 7819, 7820, 7821 AND 7822
IN BLOCK 133 OF LAKE COMO BEACH
SUBDIVISION, TOWN OF GENEVA,
WALWORTH COUNTY, WISCONSIN.

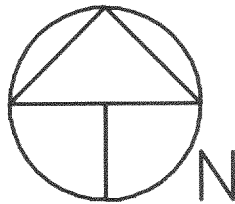

SCALE 1"=20'

BEARINGS REFERENCED TO
RECORD PLAT OF LAKE
COMO BEACH SUB.

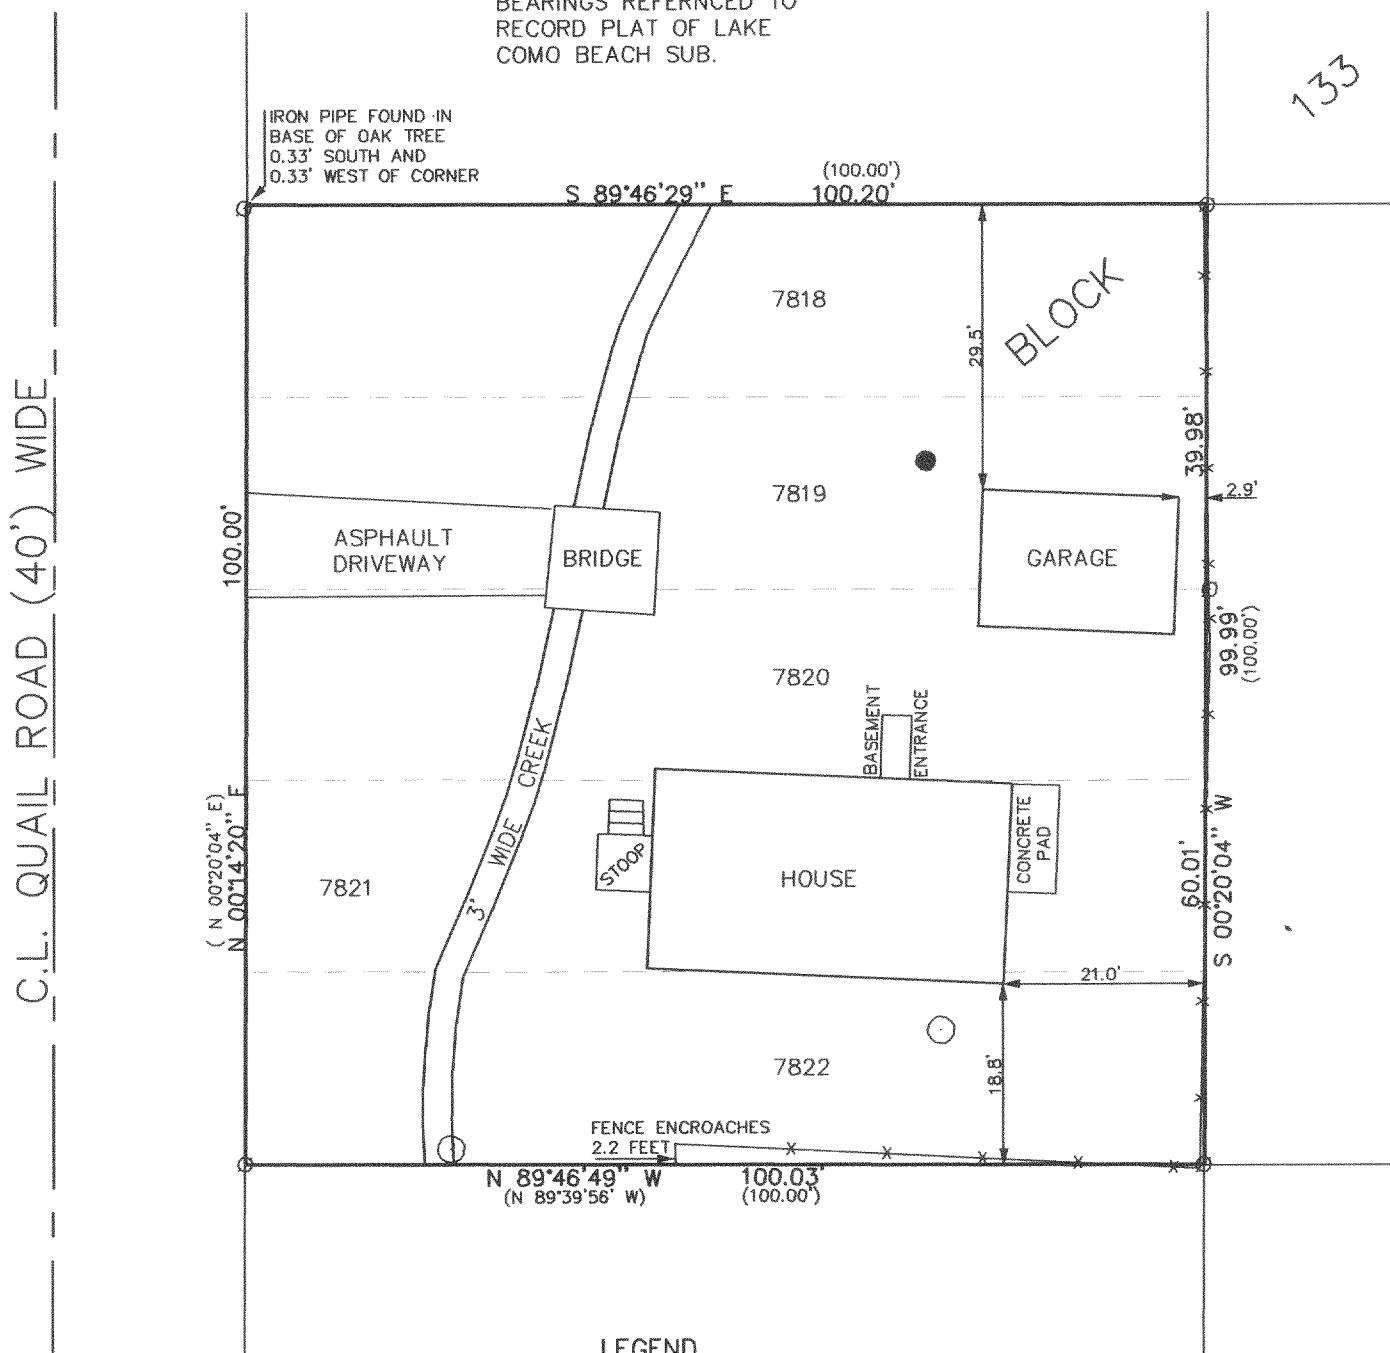


LEGEND

- FOUND IRON PIPE
- (XXX) RECORDED AS
- x— FENCE
- MANHOLE
- WELL

THE ABOVE MAP IS A TRUE REPRESENTATION THEREOF AND
SHOWS THE SIZE AND LOCATION OF ALL THE PROPERTY,
EXTERIOR BOUNDARIES, THE LOCATION OF ALL VISIBLE
BOUNDARY FENCES, APPARENT EASEMENTS, ROADWAYS
AND VISIBLE ENCROACHMENTS, IF ANY

THIS SURVEY IS MADE FOR THE USE OF THE PRESENT
OWNERS OF THE PROPERTY, AND ALSO THOSE WHO
PURCHASE, MORTGAGE OR GUARANTEE TITLE THERETO
WITHIN ONE (1) YEAR FROM DATE HERETO.

JOHN P. KROTT, R.L.S. 2258

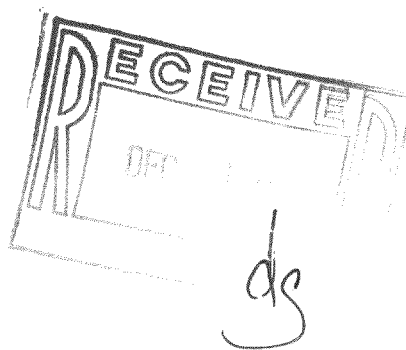

NOTE: THIS IS NOT A CERTIFIED COPY
UNLESS SEAL IS IN RED.

JOB NUMBER #98212 JLCB 01663


JLCB-1663

217-1686

PATHFINDER SURVEYING
FORMERLY KOLB LAND CONSULTING
929 WILLIAMS STREET LAKE GENEVA, WI. 53147
(414) 248-3697


DATE: 10/26/1998

DESCRIPTION: LOTS 7818, 7819, 7820, 7821 AND 7822
IN BLOCK 133 OF LAKE COMO BEACH
SUBDIVISION, TOWN OF GENEVA,
WALWORTH COUNTY, WISCONSIN.

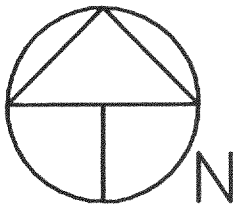

SCALE 1"=20'

BEARINGS REFERENCED TO
RECORD PLAT OF LAKE
COMO BEACH SUB.

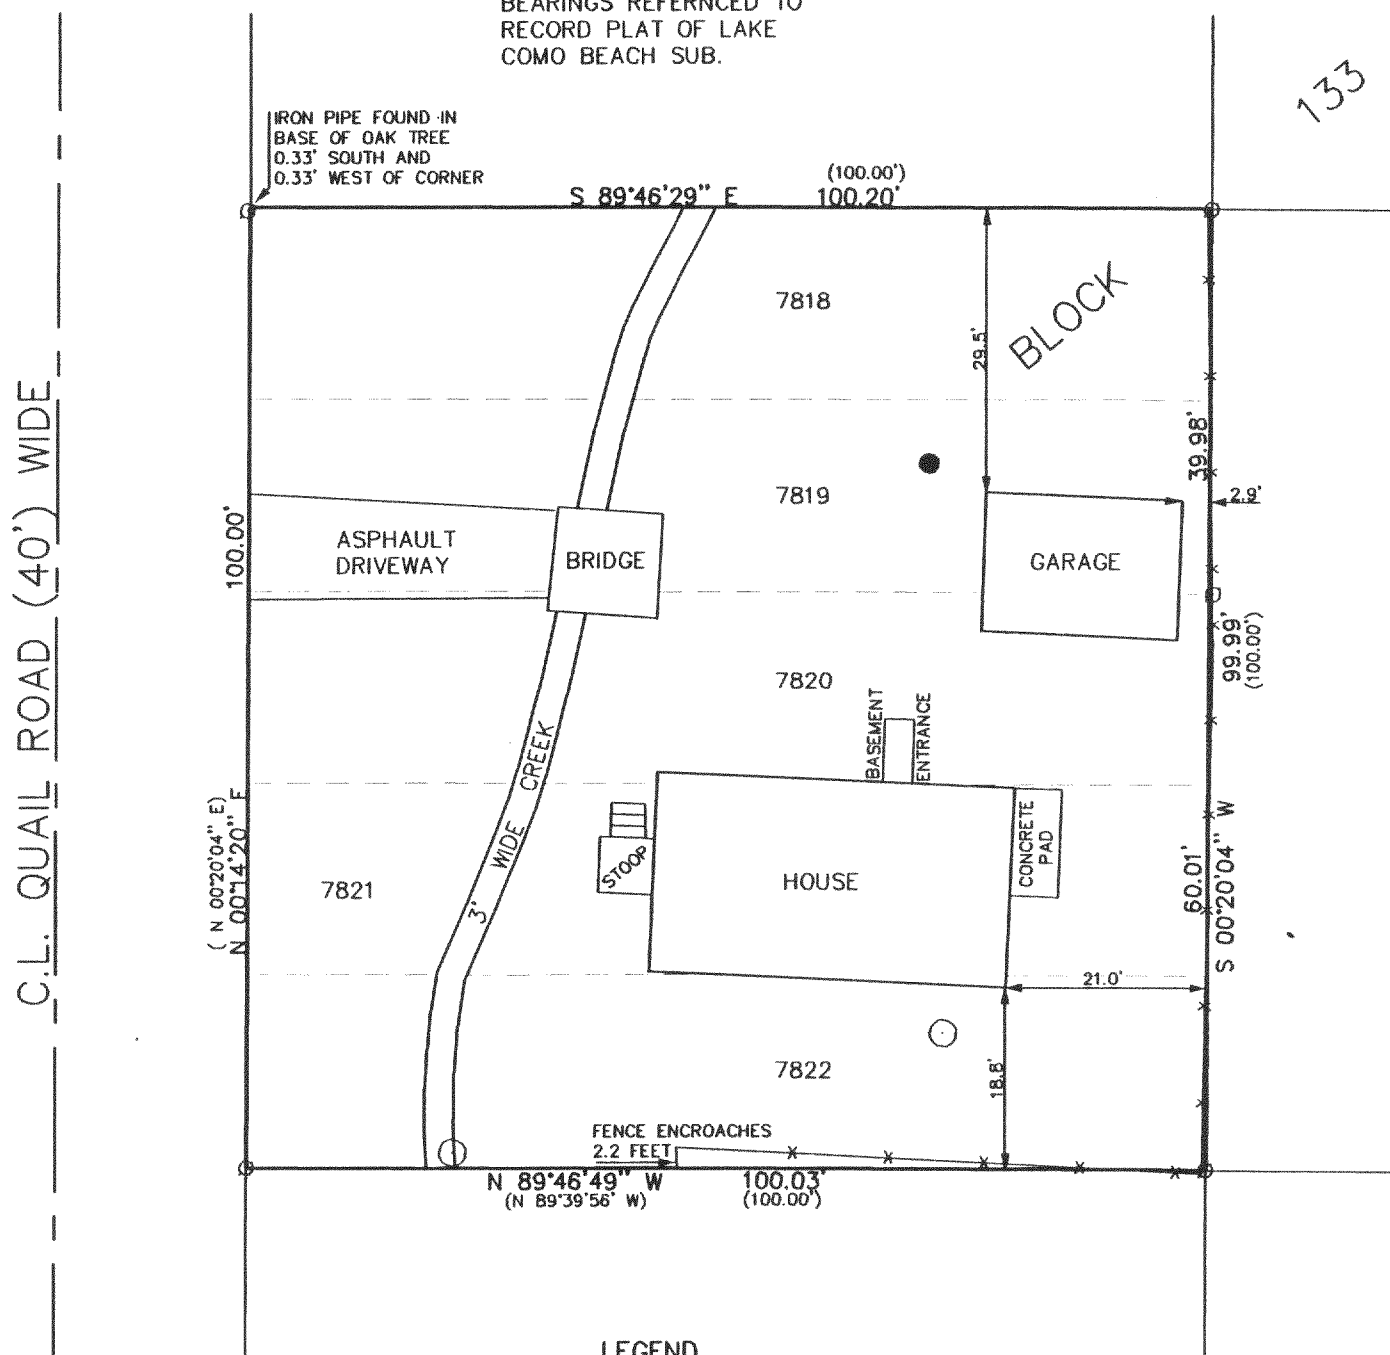



LEGEND

- FOUND IRON PIPE
 (XXX) RECORDED AS
 —*— FENCE
 ○ MANHOLE
 ● WELL

THE ABOVE MAP IS A TRUE REPRESENTATION THEREOF AND SHOWS THE SIZE AND LOCATION OF ALL THE PROPERTY, EXTERIOR BOUNDARIES, THE LOCATION OF ALL VISIBLE BOUNDARY FENCES , APPARENT EASEMENTS , ROADWAYS AND VISIBLE ENCROACHMENTS , IF ANY

THIS SURVEY IS MADE FOR THE USE OF THE PRESENT OWNERS OF THE PROPERTY, AND ALSO THOSE WHO PURCHASE, MORTGAGE OR GURANTEE TITLE THERETO WITHIN ONE (1) YEAR FROM DATE HERETO.

John P. Krott
JOHN P. KROTT, R.L.S. 2258

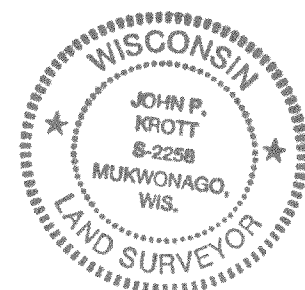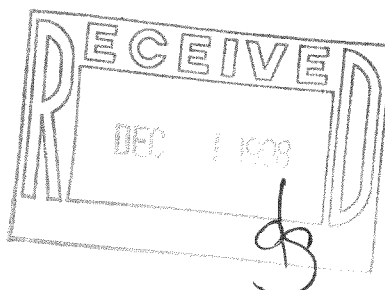

NOTE: THIS IS NOT A CERTIFIED COPY
UNLESS SEAL IS IN RED.

JOB NUMBER #98212 JLCB 01663

JLAB-1663