


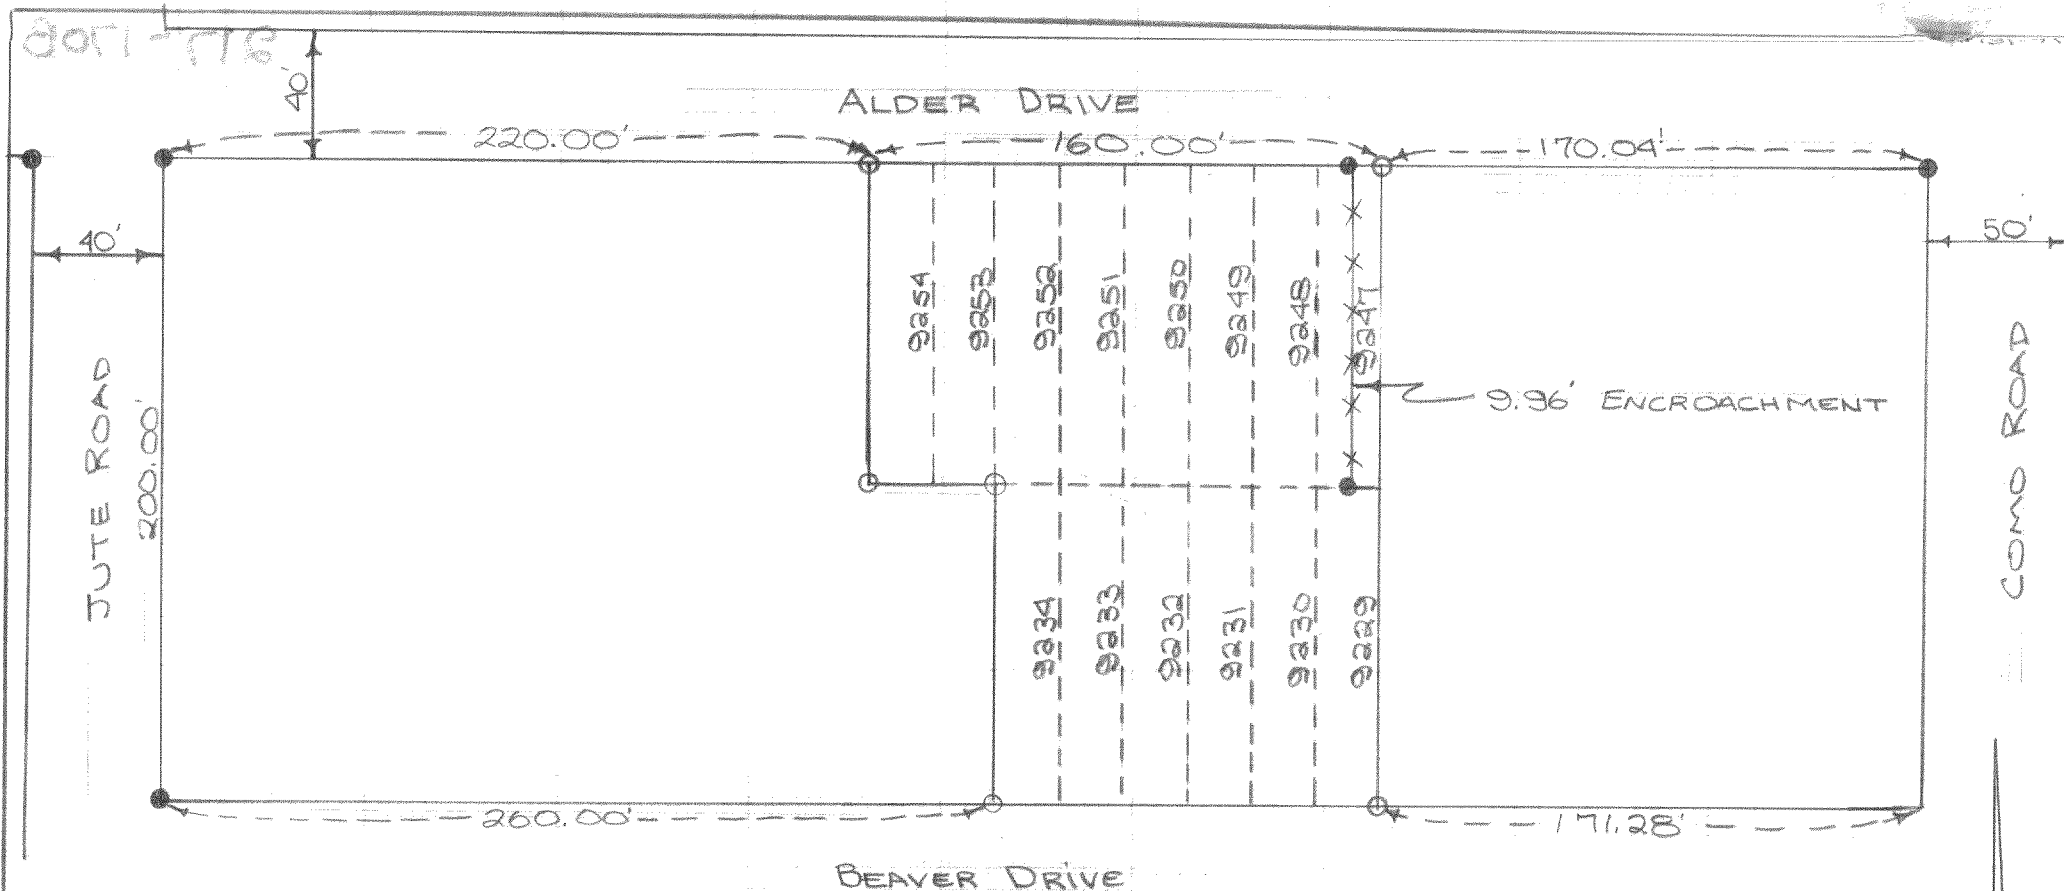

○ INDICATES PIPE SET
● INDICATES PIPE FOUND
* * INDICATES FENCE

DESCRIPTION:

Lots 9229 thru 9234 and Lots 9247 thru 9254 of Lake Como Beach Plats Section 21, T2N, R17E, Walworth County, Wisconsin.

CERTIFICATE:


I, James F. Biagi, surveyor, do hereby certify that I have surveyed the lands hereon described.

DATE:

June 15, 1971

James F. Biagi
Elkhorn, Wis.


RLS 272

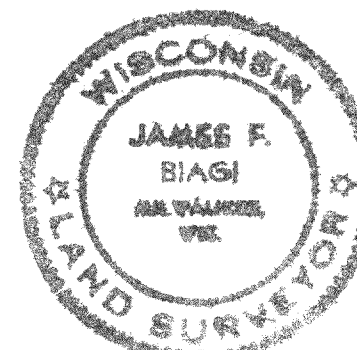

Sub-1990

217-170.B

7/31-71

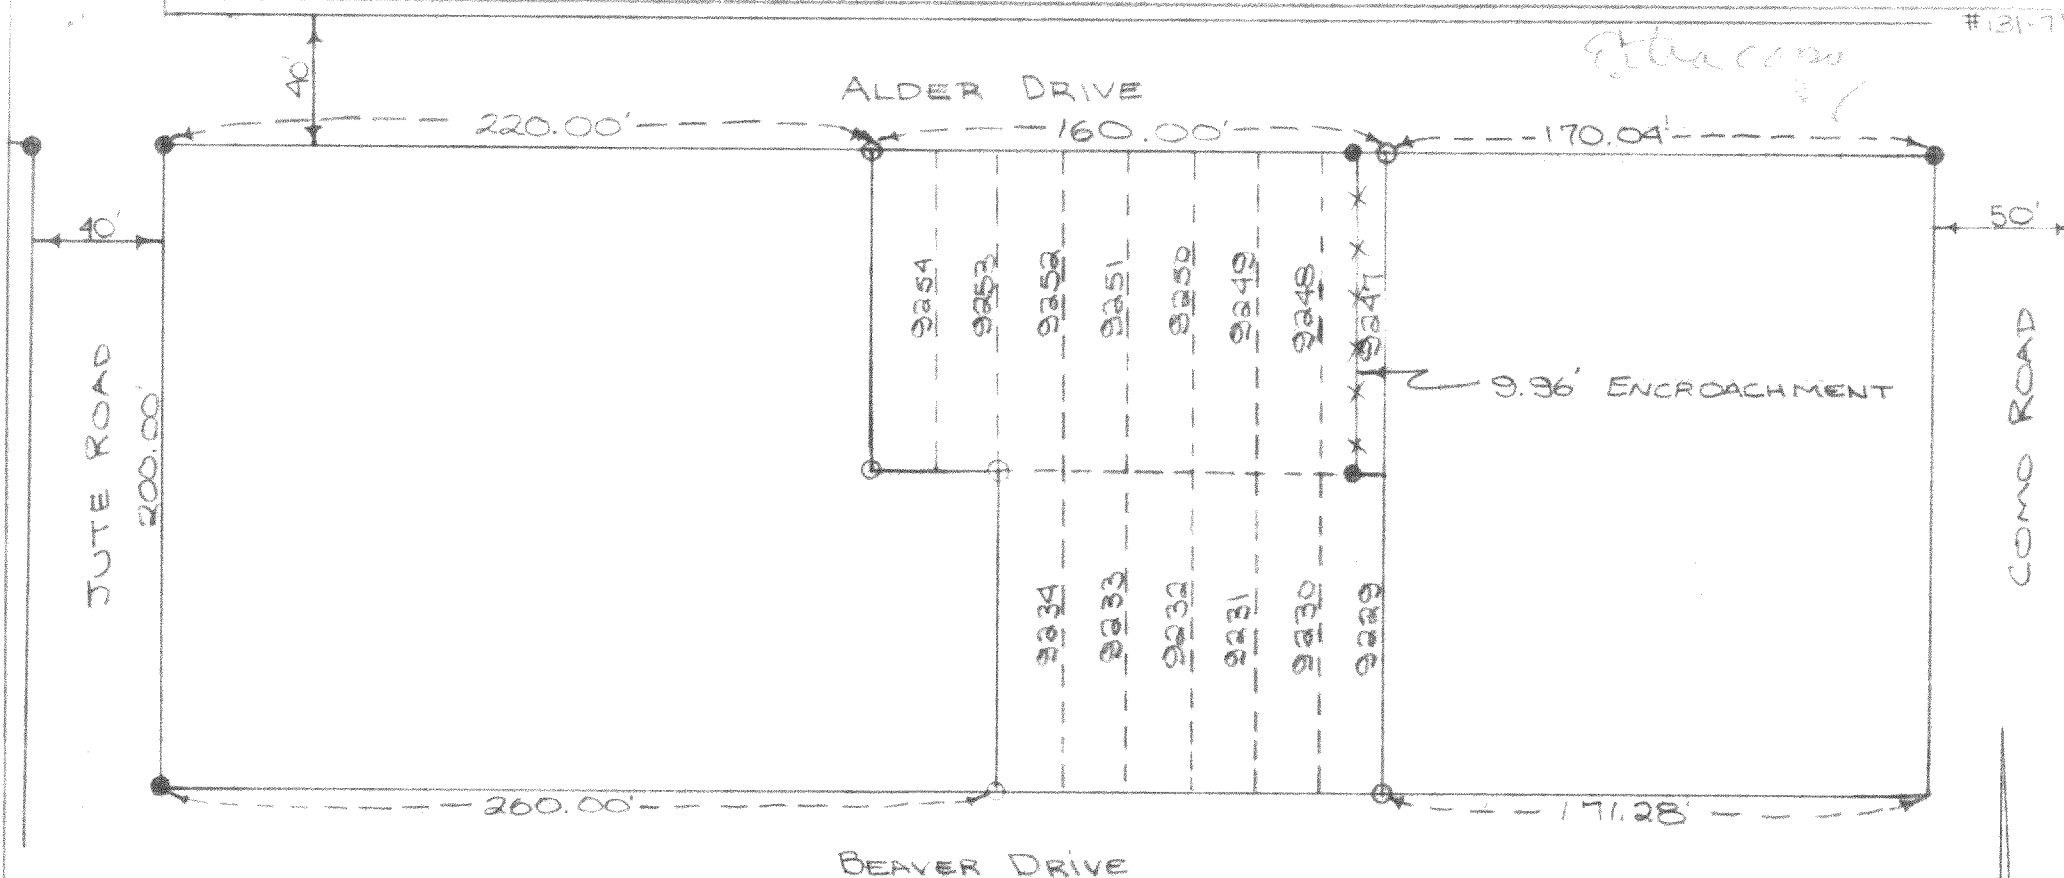

○ INDICATES PIPE SET
 ● INDICATES PIPE FOUND
 * * * INDICATES FENCE

DESCRIPTION:

Lots 9229 thru 9234 and Lots 9247 thru 9254 of Lake Como Beach Plats Section 21, T2N, R17E, Walworth County, Wisconsin.

CERTIFICATE:


I, James F. Biagi, surveyor, do hereby certify that I have surveyed the lands hereon described.

DATE:

June 15, 1971

James F. Biagi
 Elkhorn, Wis.

RLS 272

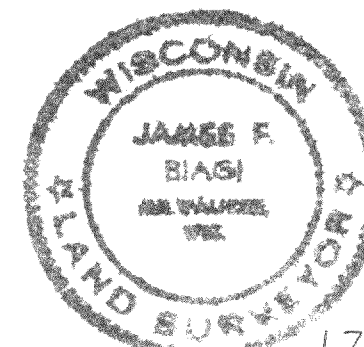

217-~~170B~~ 170B