


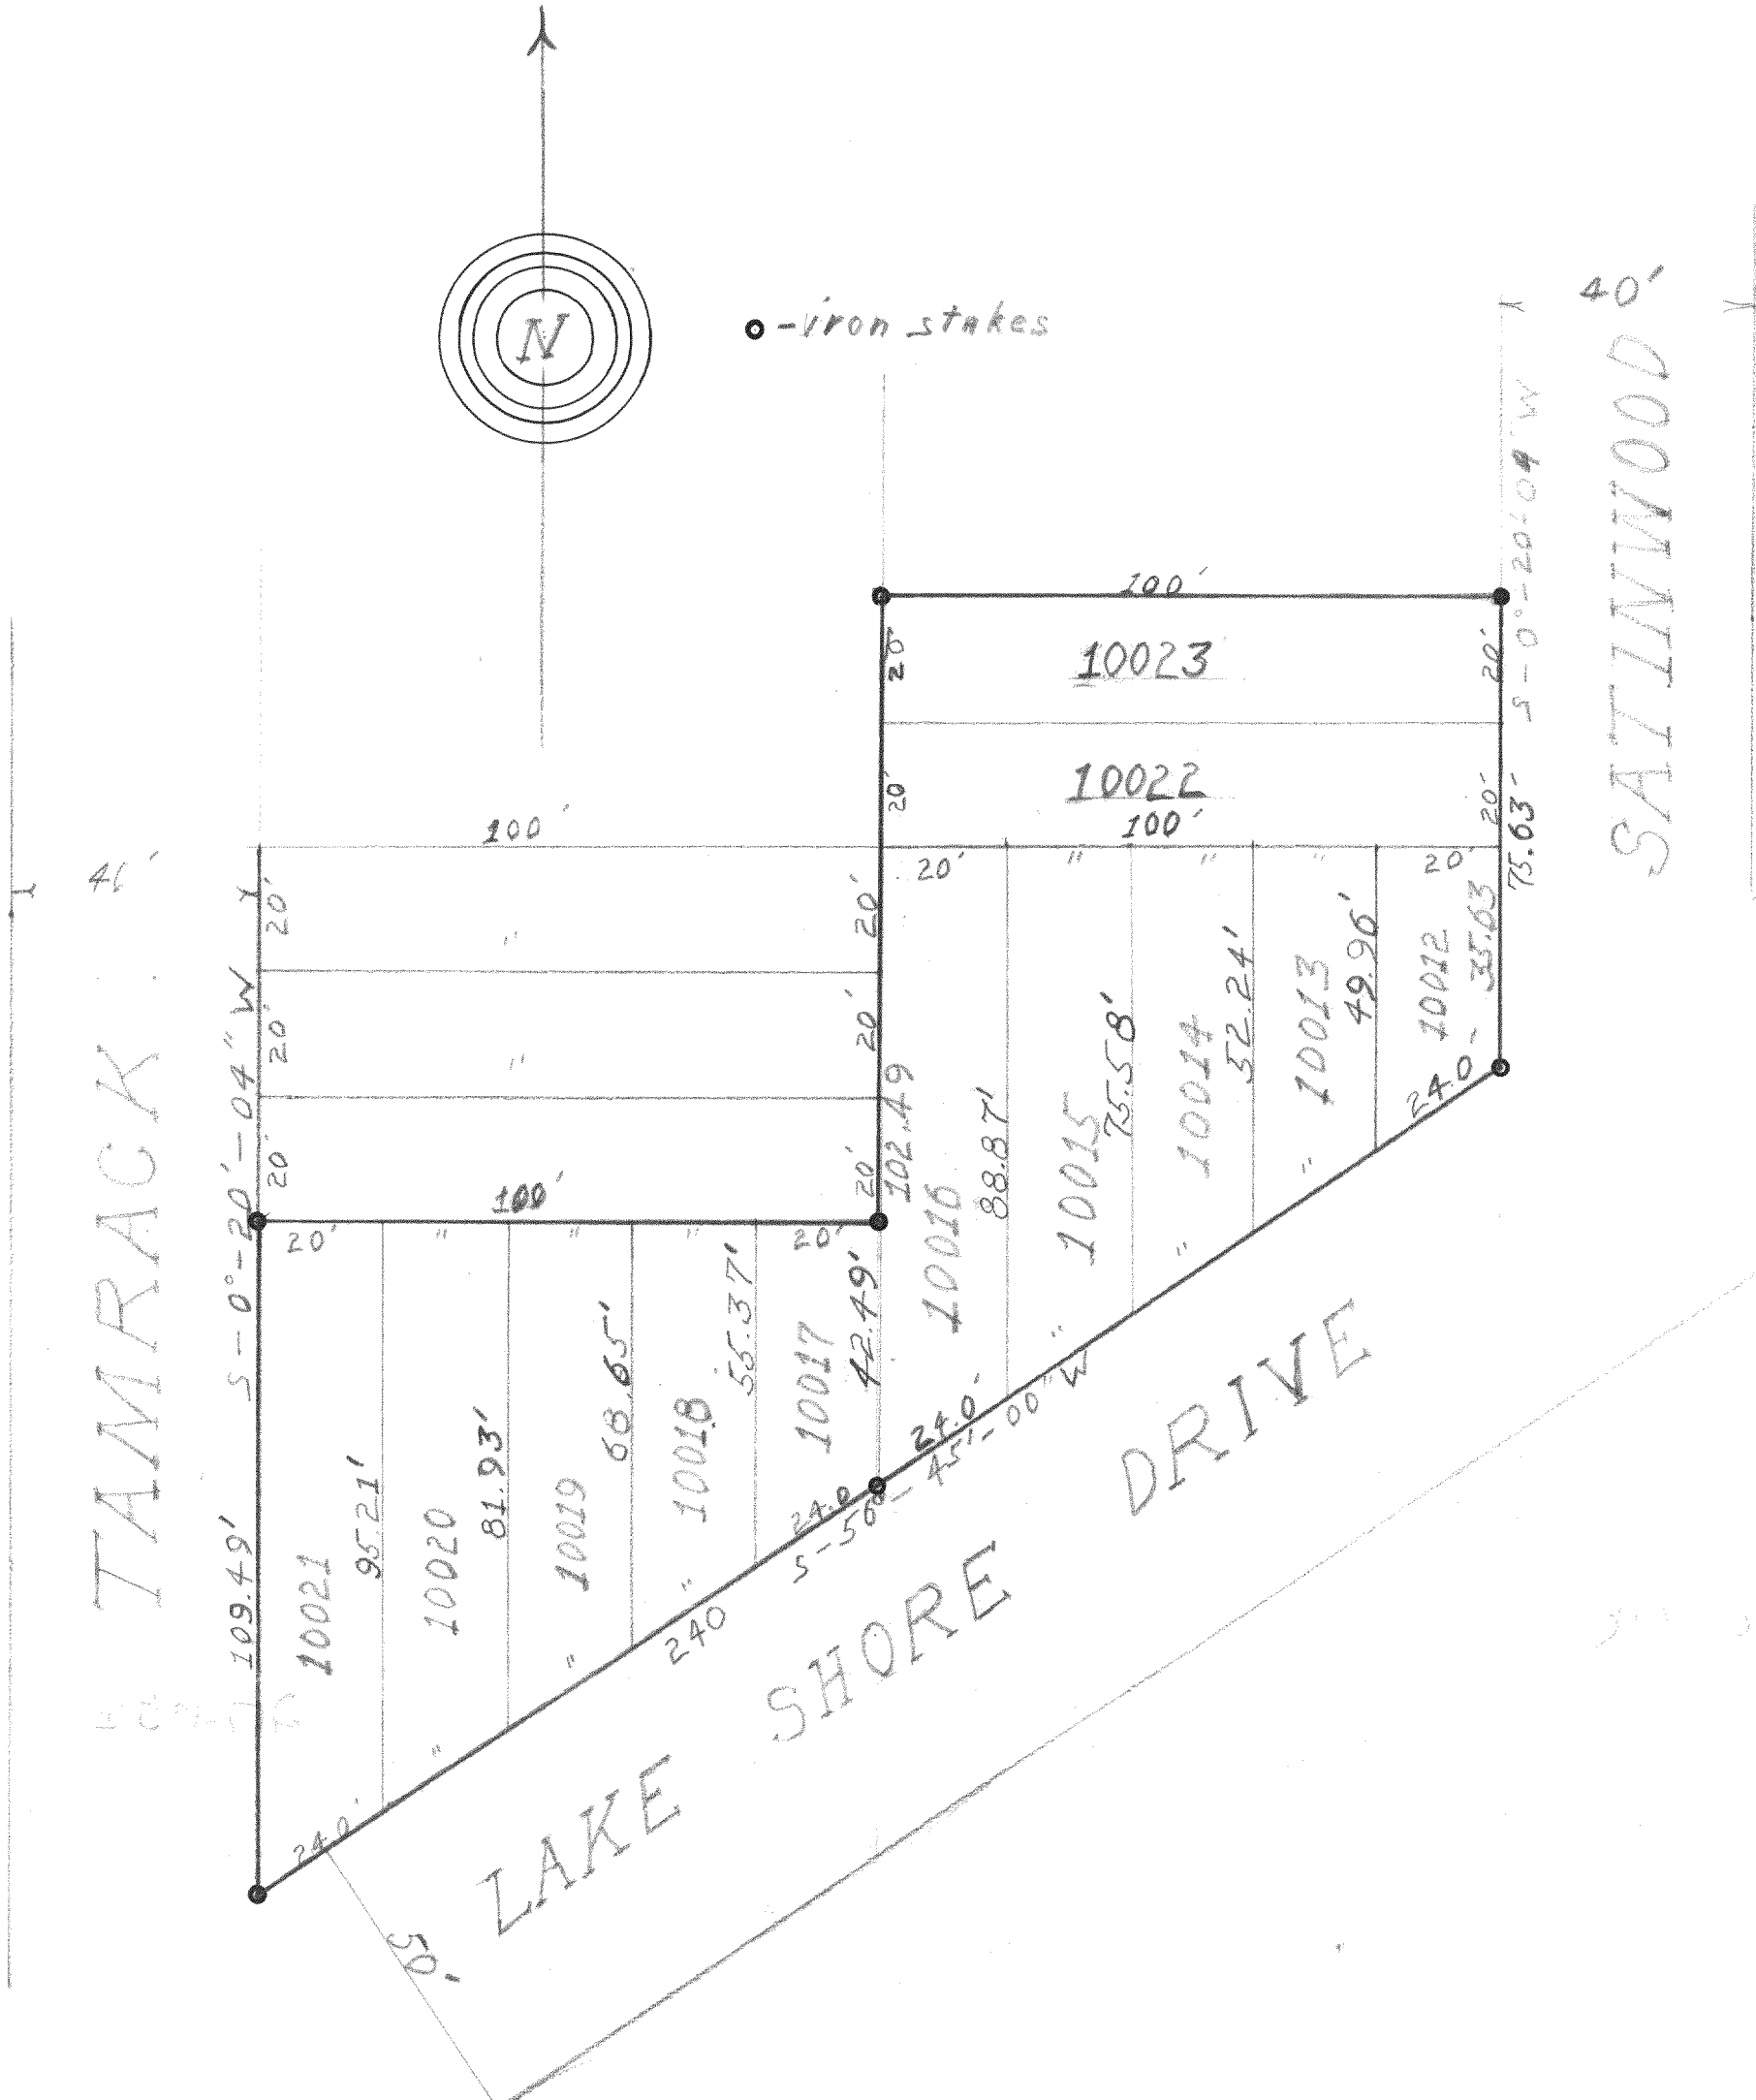

DESCRIPTION: Lots 10012 to 10023 inclusive Lake Como Beach Subdivision, of a portion of Section 28, Town 2 north, Range 17 east of the 4th Principal Meridian, Walworth County, Wisconsin.
CERTIFICATE: I, hereby certify that I have on this the 23rd day of April, 1949; surveyed the above described property according to the official record on file in the office of the Recorder of Deeds in and for Walworth County, Wisconsin, and find that the measurements and bearings of the boundary lines of said property as taken at the site on this day substantially agree with those in said official record and that no encroachments exist.
SIGNED AND SEALED THIS 2ND DAY OF MAY 1949.

JLCB. 2140, 2161 A

Joseph M. Biagi
Joseph M. Biagi Professional Engineer.
Elkhorn Wisconsin.