## PLAT OF SURVEY

## PATHFINDER SURVEYING FORMERLY KOLB LAND CONSULTING 929 WILLIAMS STREET LAKE GENEVA, WI. 53147 (414) 248-3697

ORDERED BY:

KEEFE REAL ESTATE


751 GENEVA PKY. LAKE GENEVA, WI. 53147

DESCRIPTION:

LOTS 4251 THRU 4259 BLOCK 73 LAKE COMO BEACH SUBDIVISON A SUBDIVISON LOCATED IN T2N, R17E, WALWORTH COUNTY,

WISCONSIN

DATE: 5-21-1999

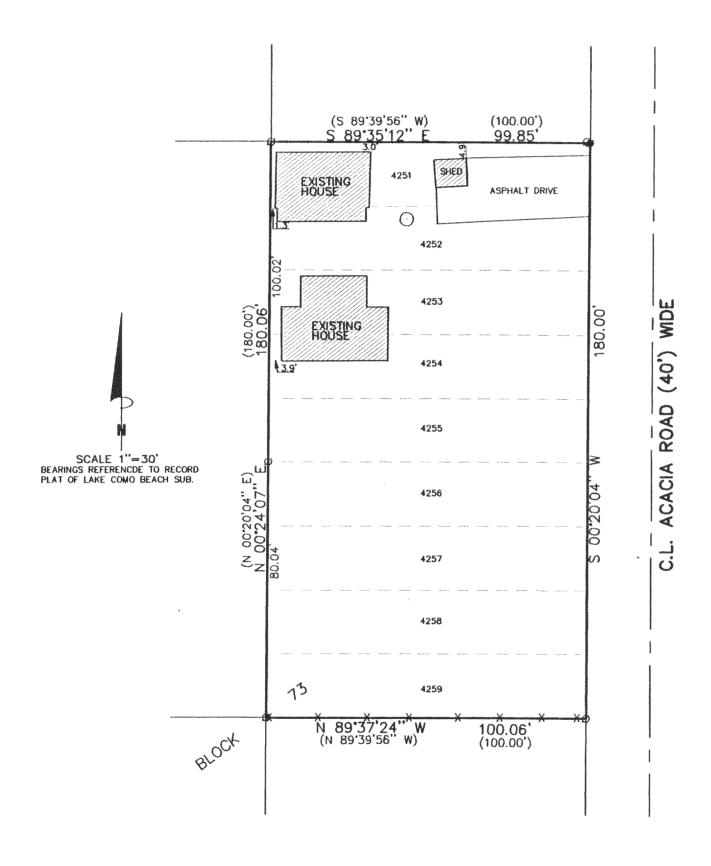

LEGEND

Ø FOUND IRON PIPE

SET IRON PIPE

MANHOLE

(XXX) RECORDED AS

<del>-X-</del> FENCE


THIS SURVEY IS MADE FOR THE USE OF THE PRESENT OWNERS OF THE PROPERTY, AND ALSO THOSE WHO PURCHASE, MORTGAGE OR GURANTEE TITLE THERETO WITHIN ONE (1) YEAR FROM DATE HERETO.

THE ABOVE MAP IS A TRUE REPRESENTATION THEREOF AND

SHOWS THE SIZE AND LOCATION OF ALL THE PROPERTY, EXTERIOR BOUNDARIES, THE LOCATION OF ALL VISIBLE BOUNDARY FENCES , APPARENT EASEMENTS , ROADWAYS

JOHN P. KROTT, R.L.S. 2258

AND VISIBLE ENCROACHMENTS, IF ANY

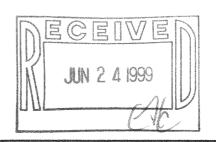



NOTE: THIS IS NOT A CERTIFIED COPY UNLESS SEAL IS IN RED.

JOB NUMBER #99111 2-17-JLCB 00827