

PLAT OF SURVEY

PATHFINDER SURVEYING
FORMERLY KOLB LAND CONSULTING
929 WILLIAMS STREET LAKE GENEVA, WI. 53147
(414) 248-3697


ORDERED BY: KEEFE REAL ESTATE
751 GENEVA PKY.
LAKE GENEVA, WI. 53147

DATE: 5-21-1999

DESCRIPTION: LOTS 6414 THRU 6418 BLOCK 111
LAKE COMO BEACH SUBDIVISION
T 2 N, R 17E, WALWORTH
COUNTY WISCONSIN.



SCALE 1"=20'
BEARINGS REFERENCED TO RECORD PLAT
OF LAKE COMO BEACH SUBDIVISION

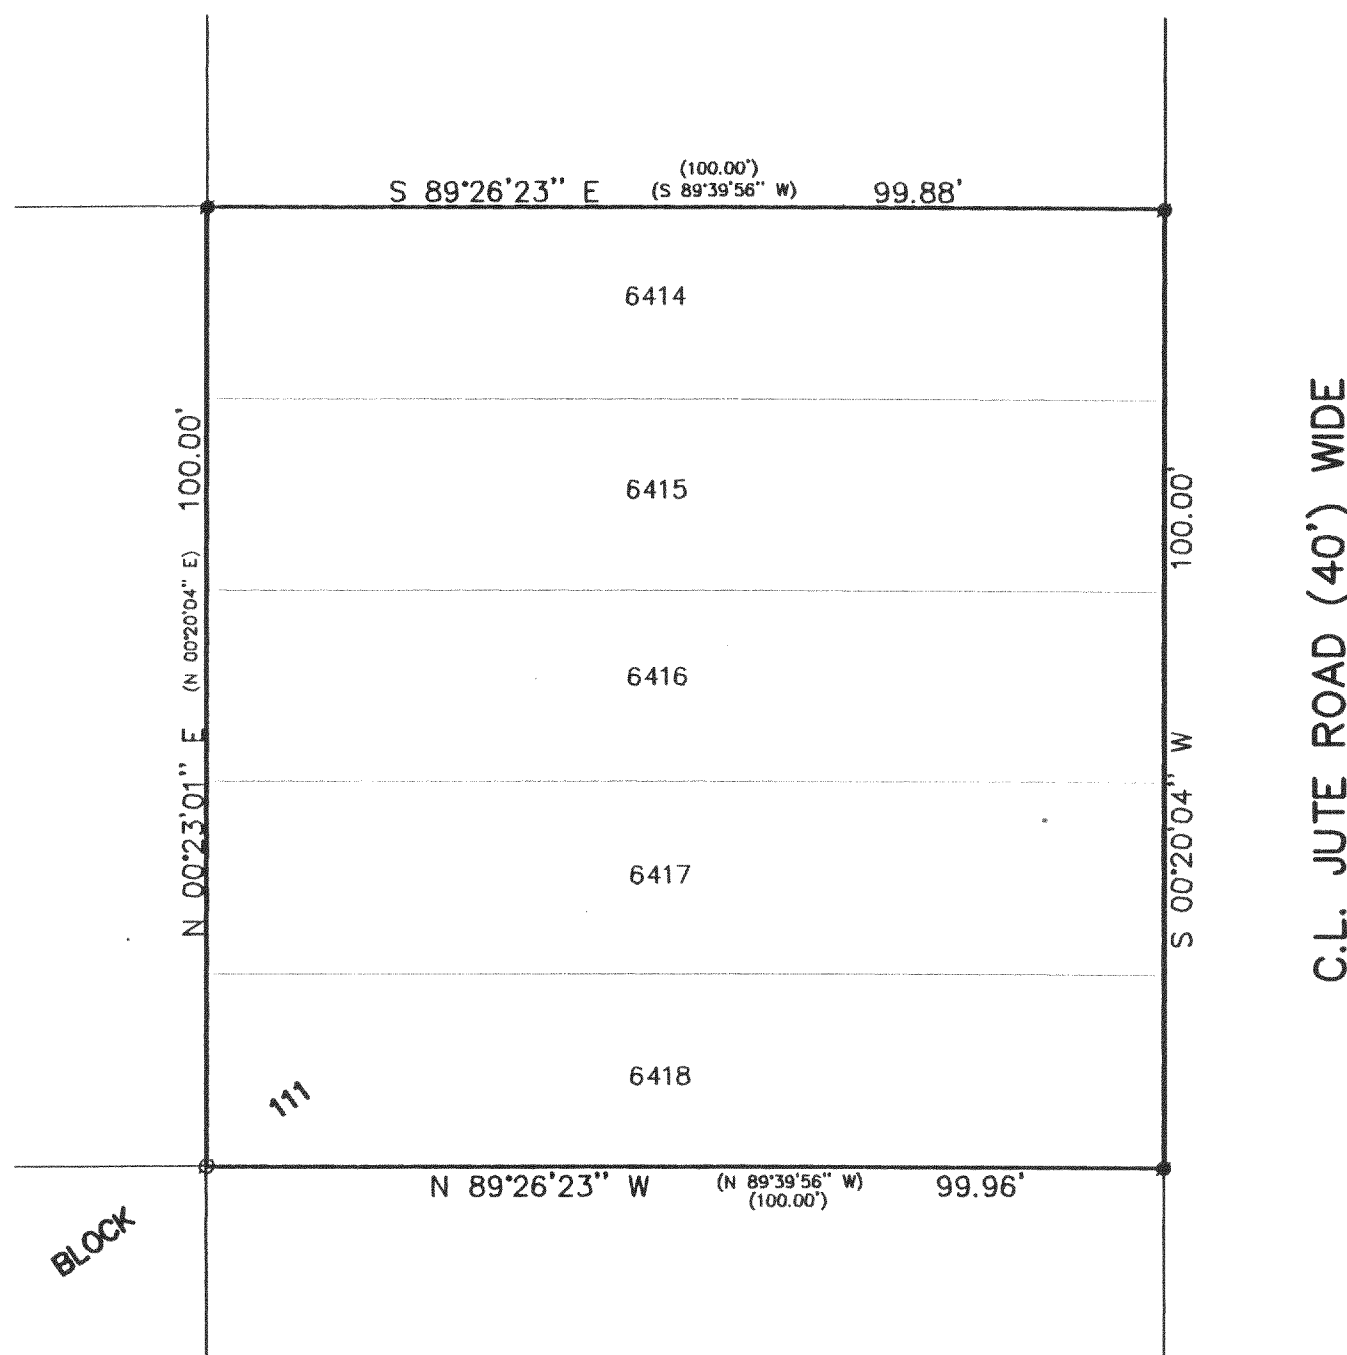

LEGEND



- FOUND IRON PIPE
- SET IRON PIPE

(XXX) RECORDED AS

THE ABOVE MAP IS A TRUE REPRESENTATION THEREOF AND
SHOWS THE SIZE AND LOCATION OF ALL THE PROPERTY,
EXTERIOR BOUNDARIES, THE LOCATION OF ALL VISIBLE
BOUNDARY FENCES, APPARENT EASEMENTS, ROADWAYS
AND VISIBLE ENCROACHMENTS, IF ANY

THIS SURVEY IS MADE FOR THE USE OF THE PRESENT
OWNERS OF THE PROPERTY, AND ALSO THOSE WHO
PURCHASE, MORTGAGE OR GUARANTEE TITLE THERETO
WITHIN ONE (1) YEAR FROM DATE HERETO.

John P. Krott
JOHN P. KROTT, R.L.S. 2258

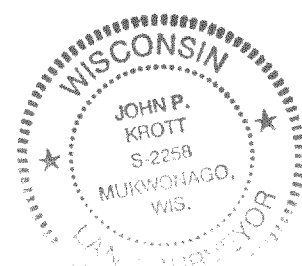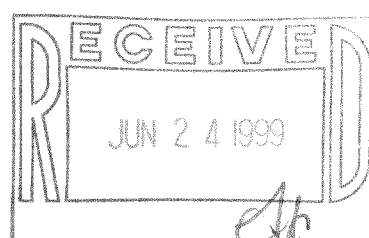

NOTE: THIS IS NOT A CERTIFIED COPY
UNLESS SEAL IS IN RED.

JOB NUMBER 99112 2-17-JLCB 01330

217-1766

JLCB-1330