

PLAT OF SURVEY

PARCEL "A"

LOTS 8289 - 8293 INCLUSIVE AND
LOTS 8299 - 8302 INCLUSIVE OF
BLOCK 142 OF LAKE COMO BEACH
SUBDIVISION

PARCEL "B"

LOTS 8303 - 8312 INCLUSIVE OF
BLOCK 142 OF LAKE COMO BEACH
SUBDIVISION

PARCEL "C"

LOTS 8335 - 8339 INCLUSIVE OF
BLOCK 142 OF LAKE COMO BEACH
SUBDIVISION.

ALL BEING LOCATED IN SECTION 21,
TOWN 2 NORTH, RANGE 17 EAST,
WALWORTH COUNTY, WISCONSIN.

ORDERED BY: JUDY HOWE
COLDWELL BANKER GENEVA LAKES AREA REALTORS
838 MAIN ST.
LAKE GENEVA, WI. 53147

OWNER: ESTATE OF LORETTA PRIMUS
N3401 WALNUT RD.
LAKE GENEVA, WI. 53147

TAX KEY NUMBERS:

JLCB - 01172 LOTS 8289 - 8293 BLOCK 142


PARCEL A JLCB - 01774 LOTS 8299 - 8300 BLOCK 142

JLCB - 01775 LOTS 8301 - 8302 BLOCK 142

PARCEL B JLCB - 01776 LOTS 8303 - 8312 BLOCK 142


PARCEL C JLCB - 01784 LOTS 8335 - 8339 BLOCK 142

(UNIMPROVED) DAISEY DRIVE 40' WIDE

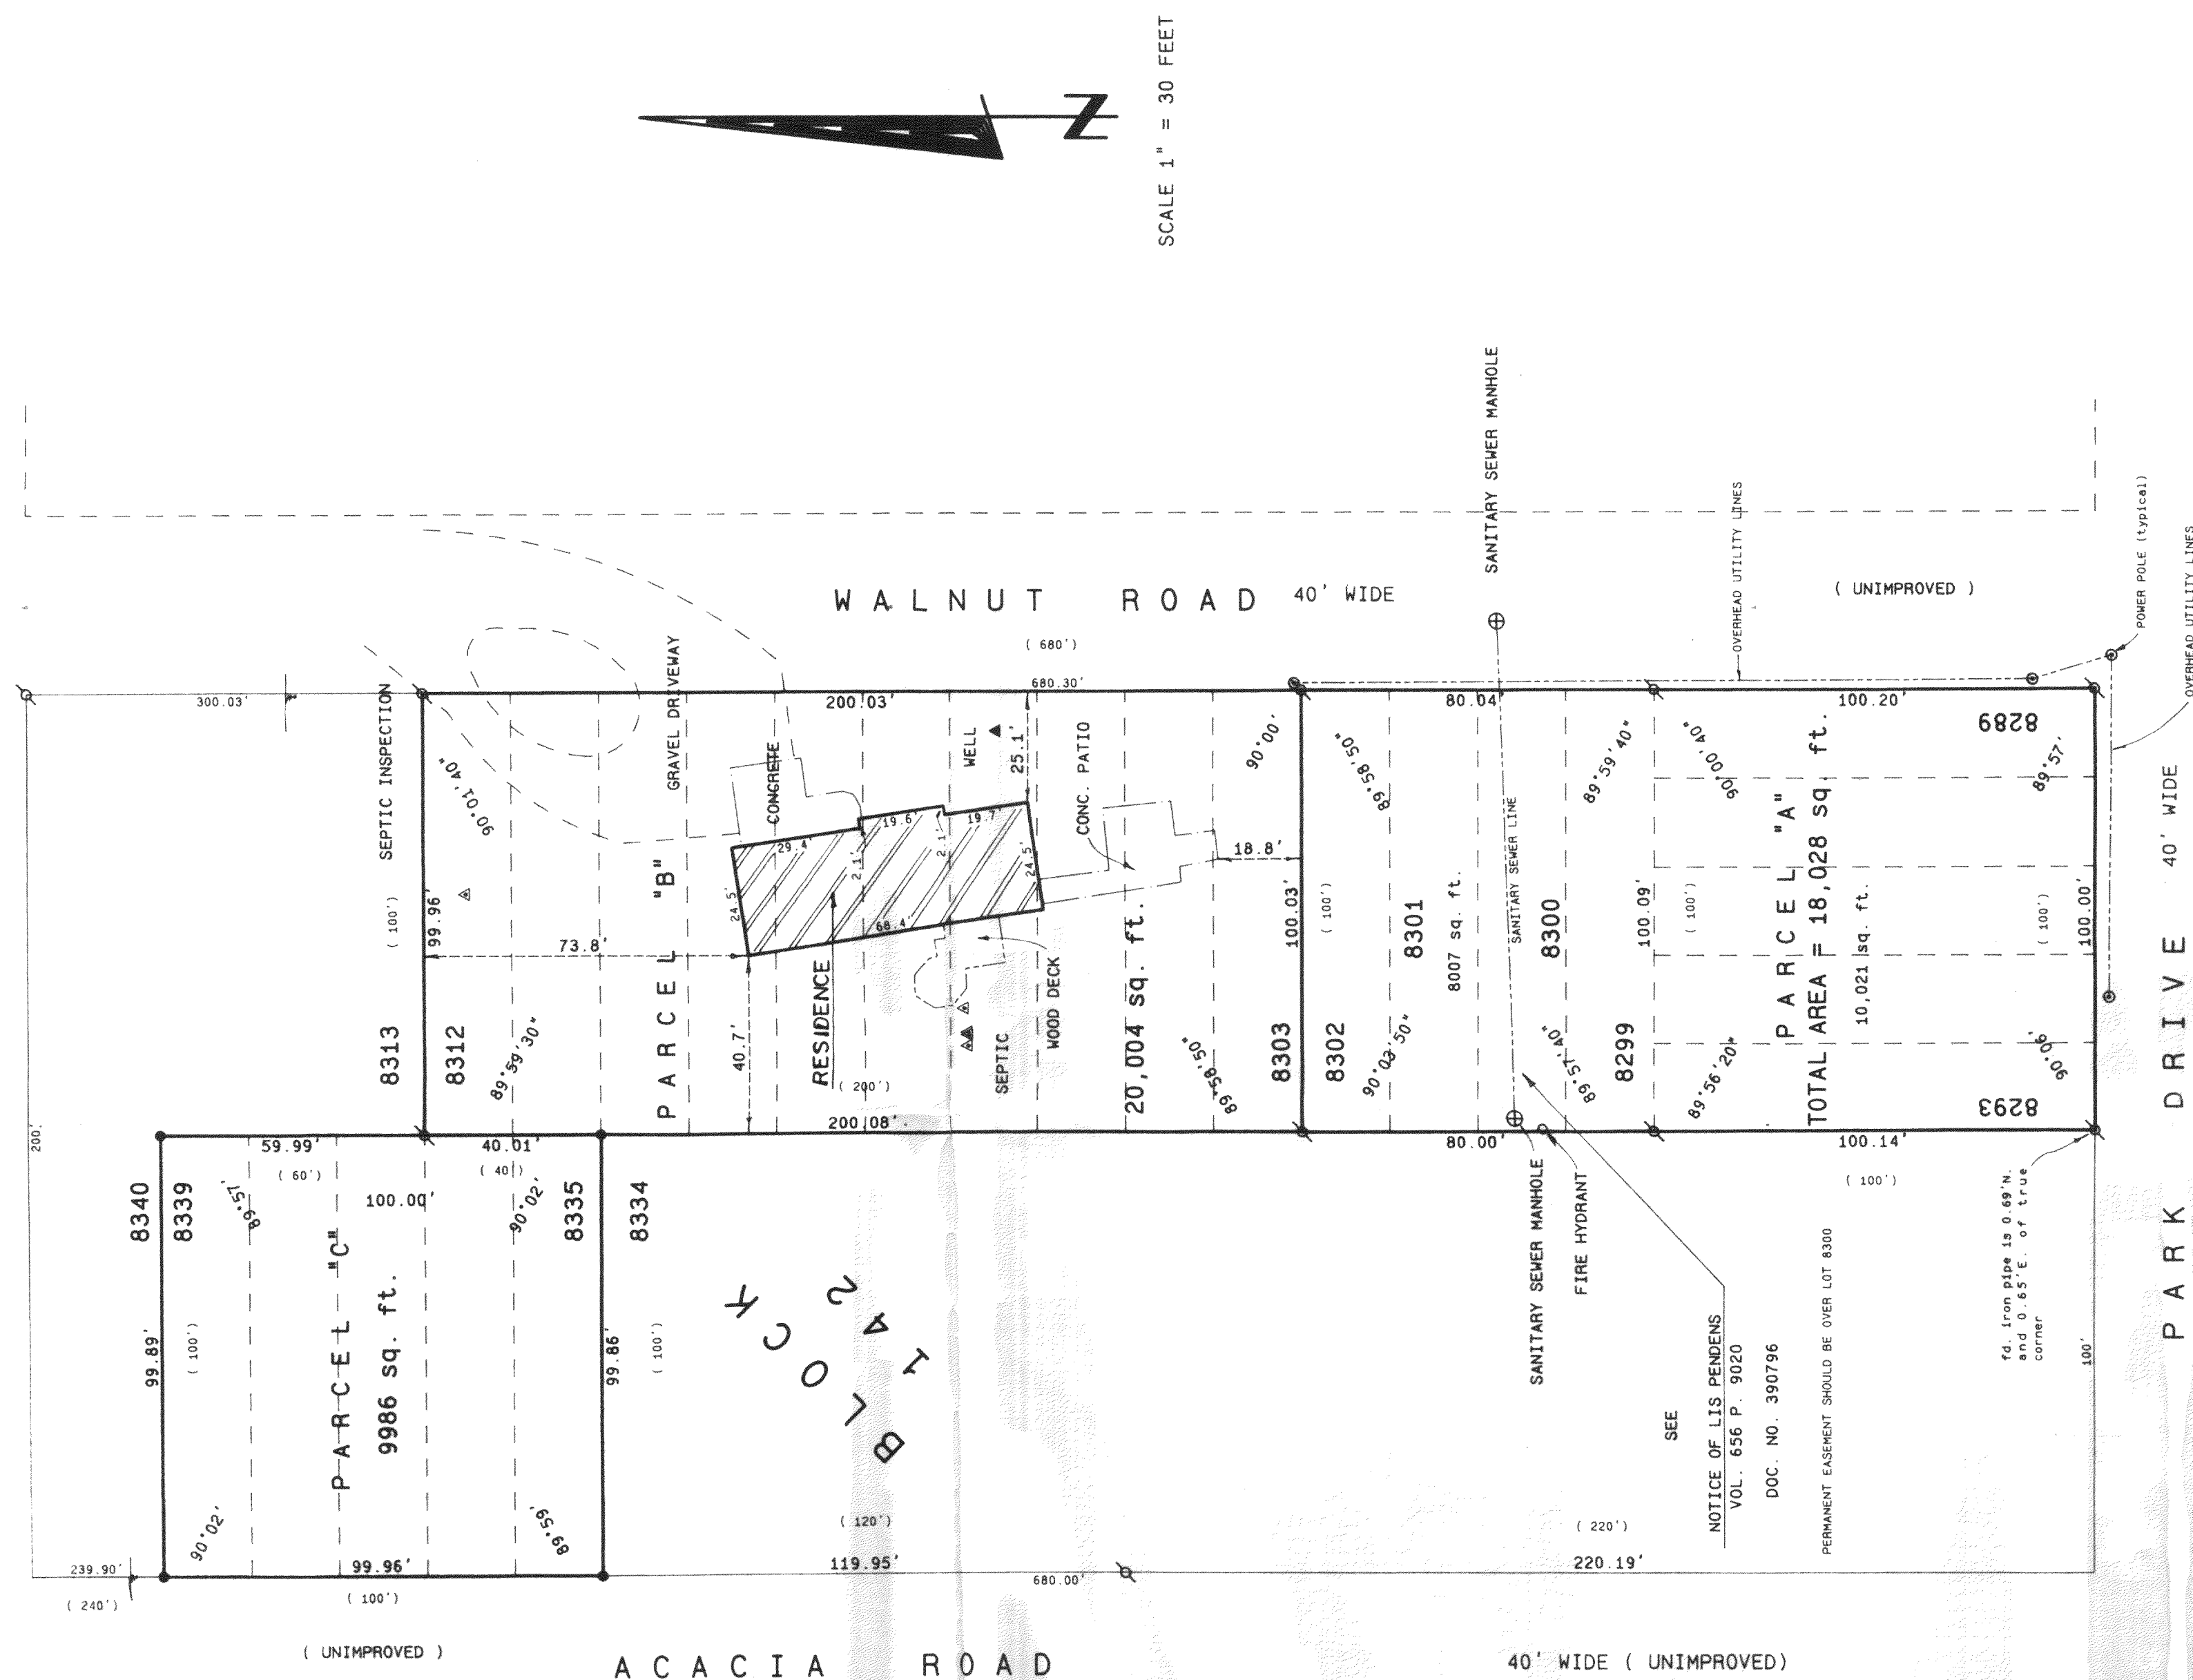


Legend

- FOUND IRON PIPE
- FOUND IRON ROD
- FOUND BRASS CAPPED MONUMENT
- FOUND CONCRETE MONUMENT
- CHISEL CUT IN CONCRETE
- SET IRON ROD, 24" LONG, WEIGHING 1.5 LBS./LINEAL FT., 3/4" DIA.
- SET IRON ROD, 30" LONG, WEIGHING 4.5 LBS./LINEAL FT., 1-1/16" DIA.
- RECORDED AS DIMENSION
- EXISTING FENCE

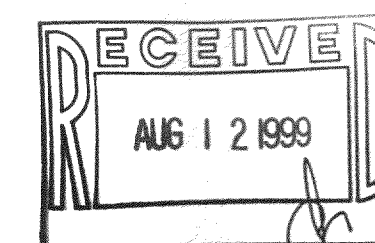

SCALE: 1" = 30 FEET

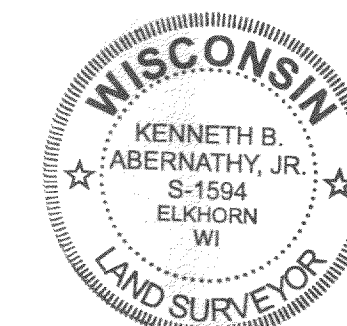

I hereby certify that the above described property has been surveyed by me or under my direction and that the above map is a true representation thereof and shows the size and location of the property, its exterior boundaries, the location of all visible structures and dimensions of all principal buildings thereon, boundary fences, apparent easements, roadways and visible encroachments, if any. This survey is made for the use of the present owners of the property, and also those who purchase, mortgage, or guarantee the title thereto within one year from date hereof.

Kenneth B. Abernathy, Jr.
KENNETH B. ABERNATHY, JR.
WISCONSIN REGISTERED LAND SURVEYOR,
S-1594

Date: AUGUST 6, 1999 Job No. 99715

JLCB - 1172
JLCB - 1174
JLCB - 1175
JLCB - 1176
JLCB - 11784

217-1176