

ABERNATHY and ASSOCIATES

Kenneth B. Abernathy Jr.

Wisconsin Registered Land Surveyor S-1594

Rt. 1, Box 273
Elkhorn, Wisconsin 53121
Phone (414) 723 4260 (office)
(414) 723 7209 (FAX)

PLAT OF SURVEY

THE NORTH FIVE FEET OF LOT
10339 AND LOTS 10340 - 10345
AND THE SOUTH 1/2 OF
LOT 10346 OF BLOCK 188 OF
LAKE COMO BEACH SUBDIVISION,
TOWN 2 NORTH, RANGE 17 EAST,
WALWORTH COUNTY, WISCONSIN.

LOT LINE ADJUSTMENT
SOUTH 1/2 LOT 10346

977 S.F.

ADJUSTED TO PARCEL TO THE NORTH



NORTH 5' OF LOT 10339
AND LOTS 10340-10345 INCLUSIVE

12,487 S.F.

REMAINING PARCEL


OWNER: DONALD S. DANE JR.
N9296 TAMARACK RD.
WHITEWATER, WI. 53190

BLOCK
188

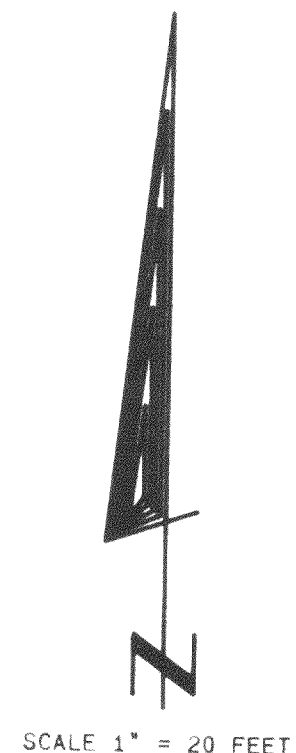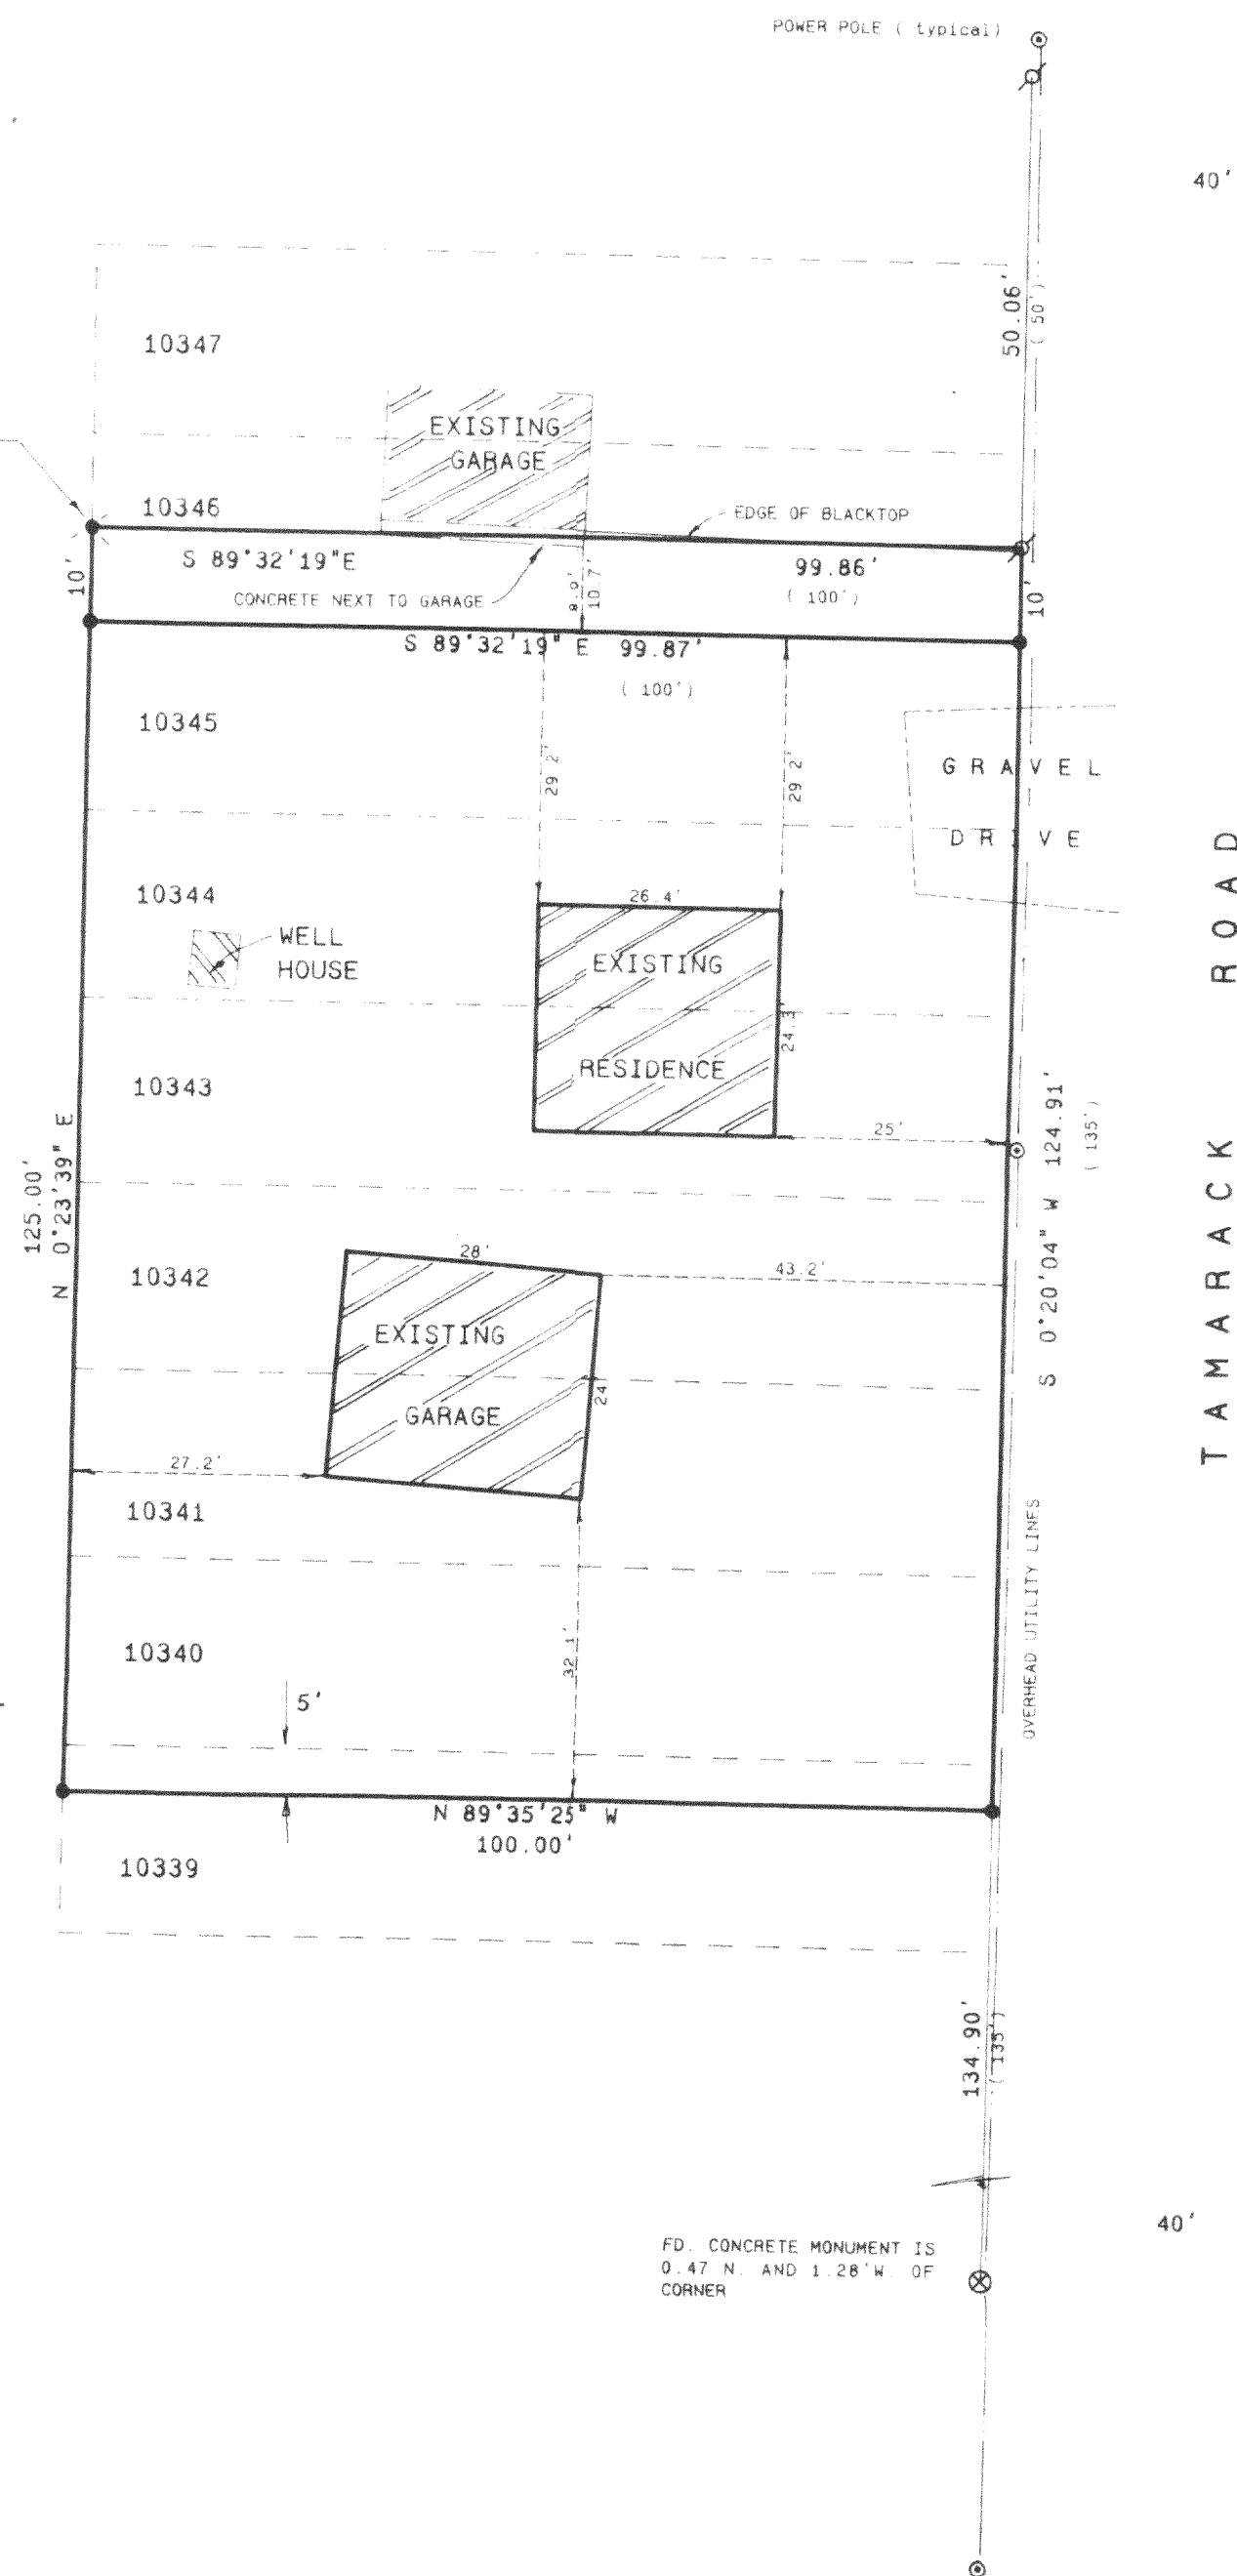


Legend

- FOUND IRON PIPE
- FOUND IRON ROD
- FOUND BRASS CAPPED MONUMENT
- * FOUND CONCRETE MONUMENT
- + CHISEL CUT IN CONCRETE
- SET IRON ROD, 24" LONG, WEIGHING 1.5 LBS. LINEAL FT., 3/4" DIA.
- SET IRON ROD, 30" LONG, WEIGHING 4.5 LBS. LINEAL FT., 1-11/16" DIA.
- (XX) RECORDED AS DIMENSION
- - - - - EXISTING FENCE

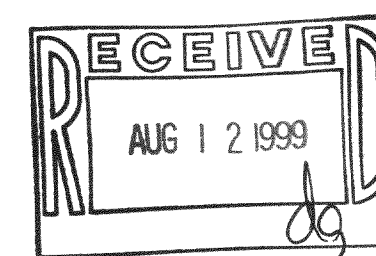

SCALE: 1" = 20 FEET

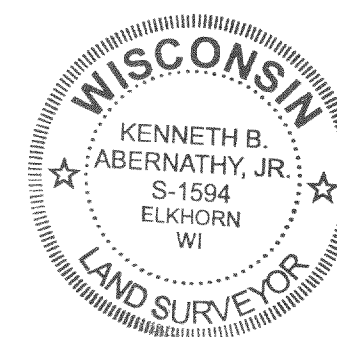

"I hereby certify that the above described property has been surveyed by me or under my direction and that the above map is a true representation thereof and shows the size and location of the property, its exterior boundaries, the location of all visible structures and dimensions of all principal buildings thereon, boundary fences, apparent easements, roadways and visible encroachments, if any."

"This survey is made for the use of the present owners of the property, and also those who purchase, mortgage, or guarantee the title thereto within one year from date hereof."

Kenneth B. Abernathy, Jr.
KENNETH B. ABERNATHY, JR.
WISCONSIN REGISTERED LAND SURVEYOR,
S-1594

Date: 8-10-99 Job No. 99.712

217-1778

JLCB-2236