



AMBIT LAND SURVEYING
P.O. Box 42
Racine, WI 53101

PLAT OF SURVEY

DATE 4-14-53
PAGE 1-4-53

OF

Lots 8961 through 8970, Block 161 of LAKE COMO BEACH, a subdivision located in part of the Southeast Quarter of Section 21, part of the South Half of Section 22, part of the North Half of Section 27, the North Half and part of the Southwest Quarter of Section 28 and part of the East Half of Section 29, all in Township 2 North, Range 17 East of the 4th Principal Meridian, Town of Geneva, Walworth County, Wisconsin.

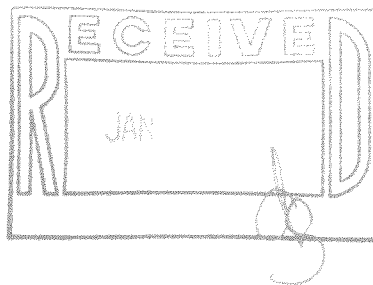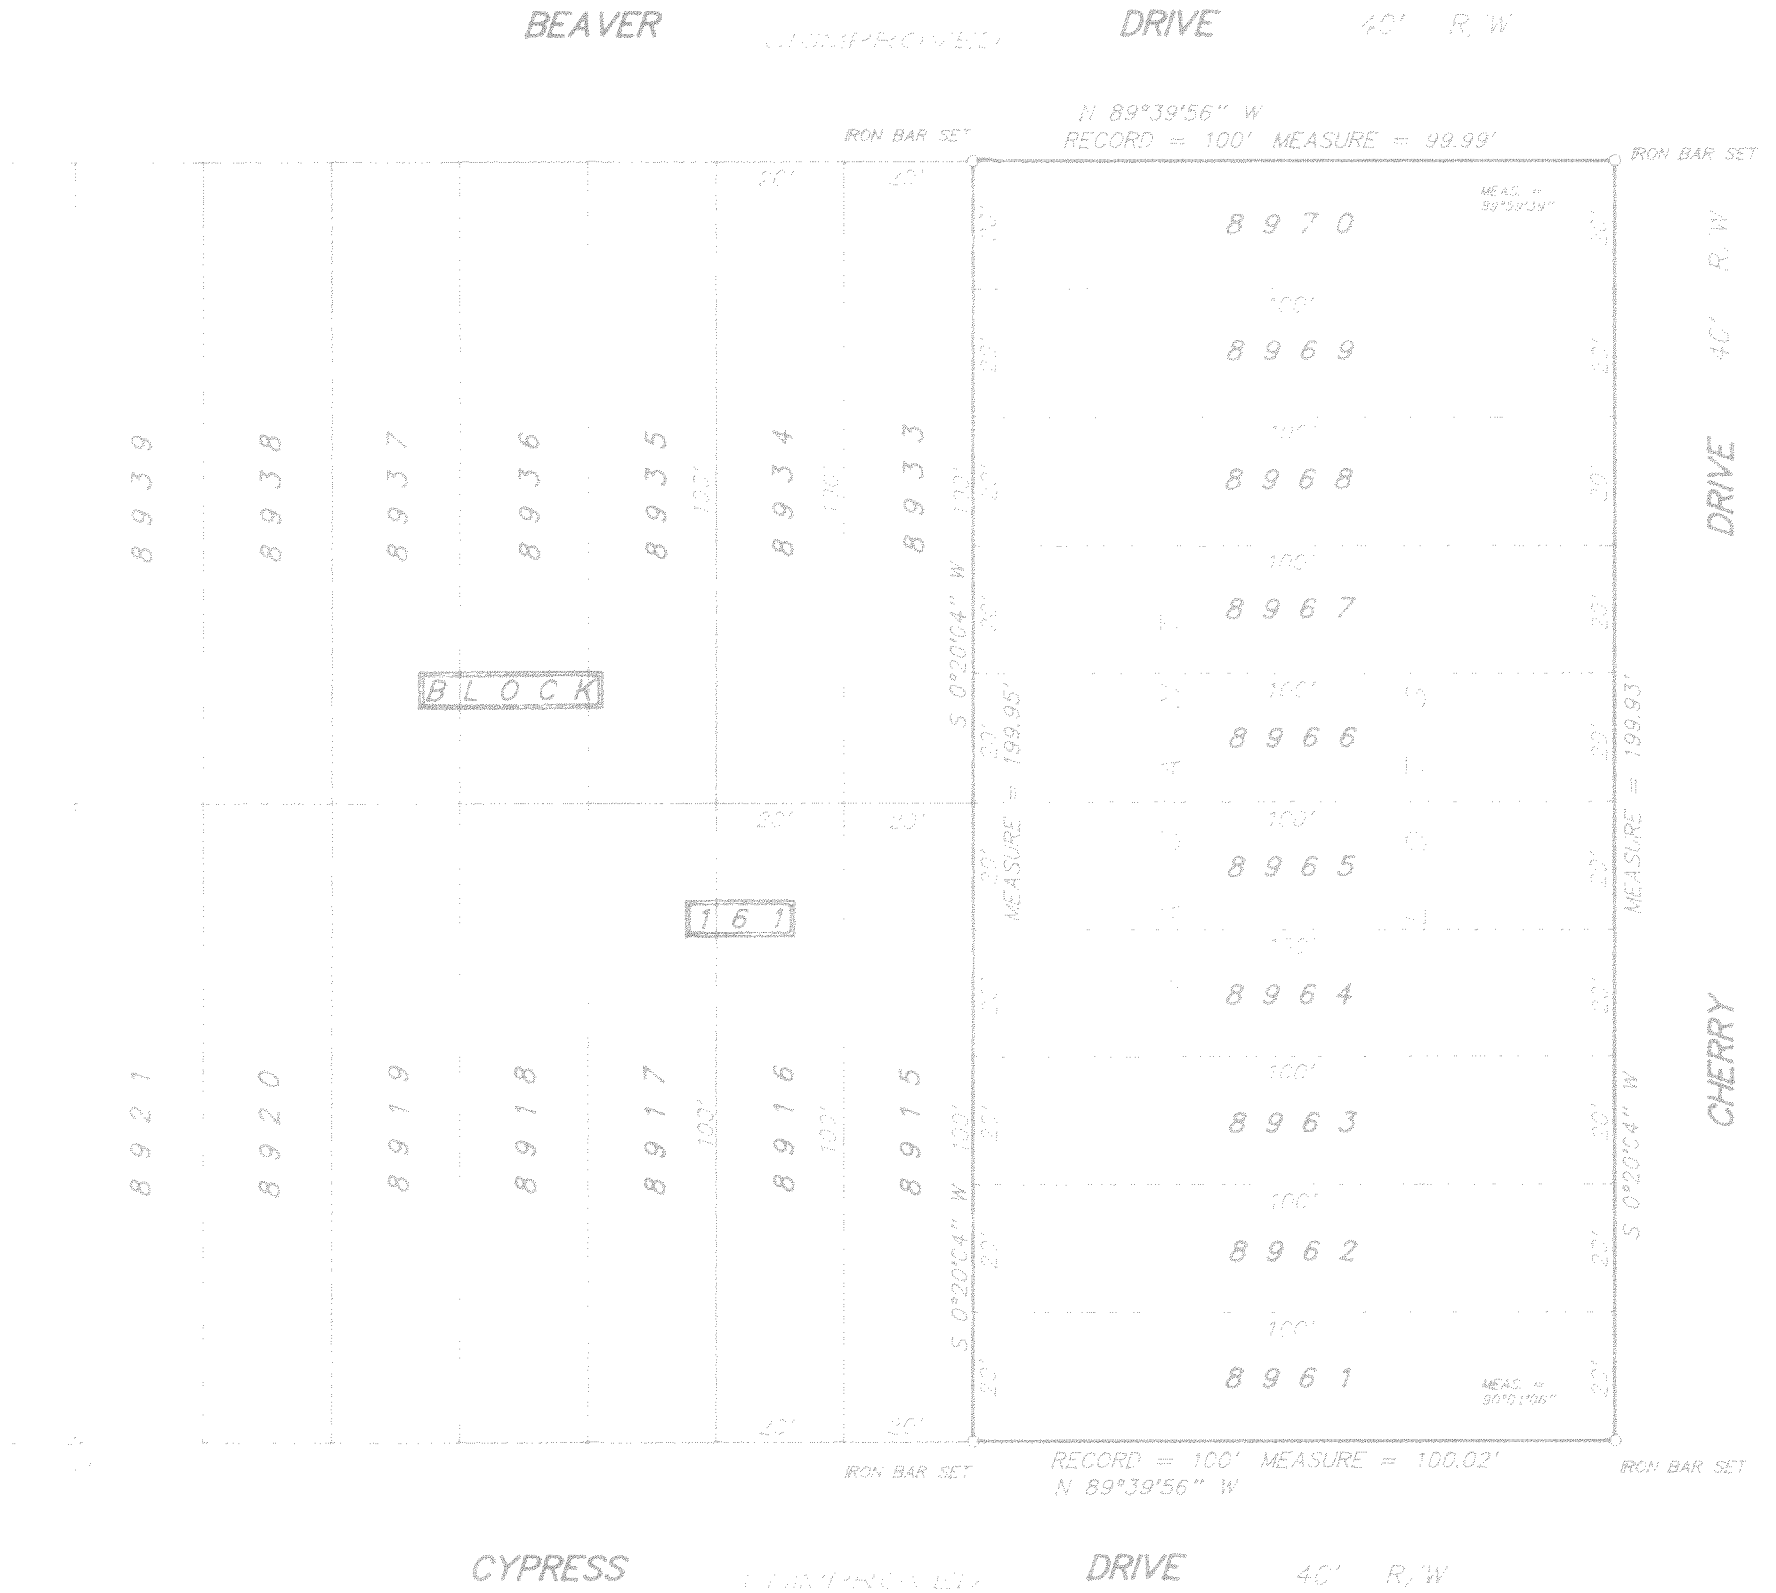

SCALE 1 inch = 30 feet

ORDERED BY P. Heller, Hornstead Lake Realty

JOB NO. 29141

I hereby certify that I have surveyed the above described property and the above plat is a true representation thereof and shows the size and location of the property, its exterior boundaries, the location and dimensions of all visible structures thereon, boundary lines, apparent easements and roadways and visible encroachments, if any.

This survey is made for the exclusive use of the present owners of the property, and those who purchase, mortgage, or guarantee the title therein within the year from the date hereof.

Dated at Beaver, Wisconsin this 11th day of January, 1953.

Mark A. Bolender
Wisconsin Registered Land Surveyor No. 1784

217-1843
JLCB-1925