



PLAT OF SURVEY

PATHFINDER SURVEYING
FORMERLY KOLB LAND CONSULTING
929 WILLIAMS STREET LAKE GENEVA, WI. 53147
(262) 248-3697

ORDERED BY: KEEFE REAL INC.
751 GENEVA PARKWAY
LAKE GENEVA, WI. 53147

DATE: 12-7-1999

DESCRIPTION: LOTS 11727 THRU 11731, BLOCK 211, LAKE COMO BEACH
SUBDIVISION, LOCATED IN T2N, R17E, WALWORTH COUNTY,
WISCONSIN.

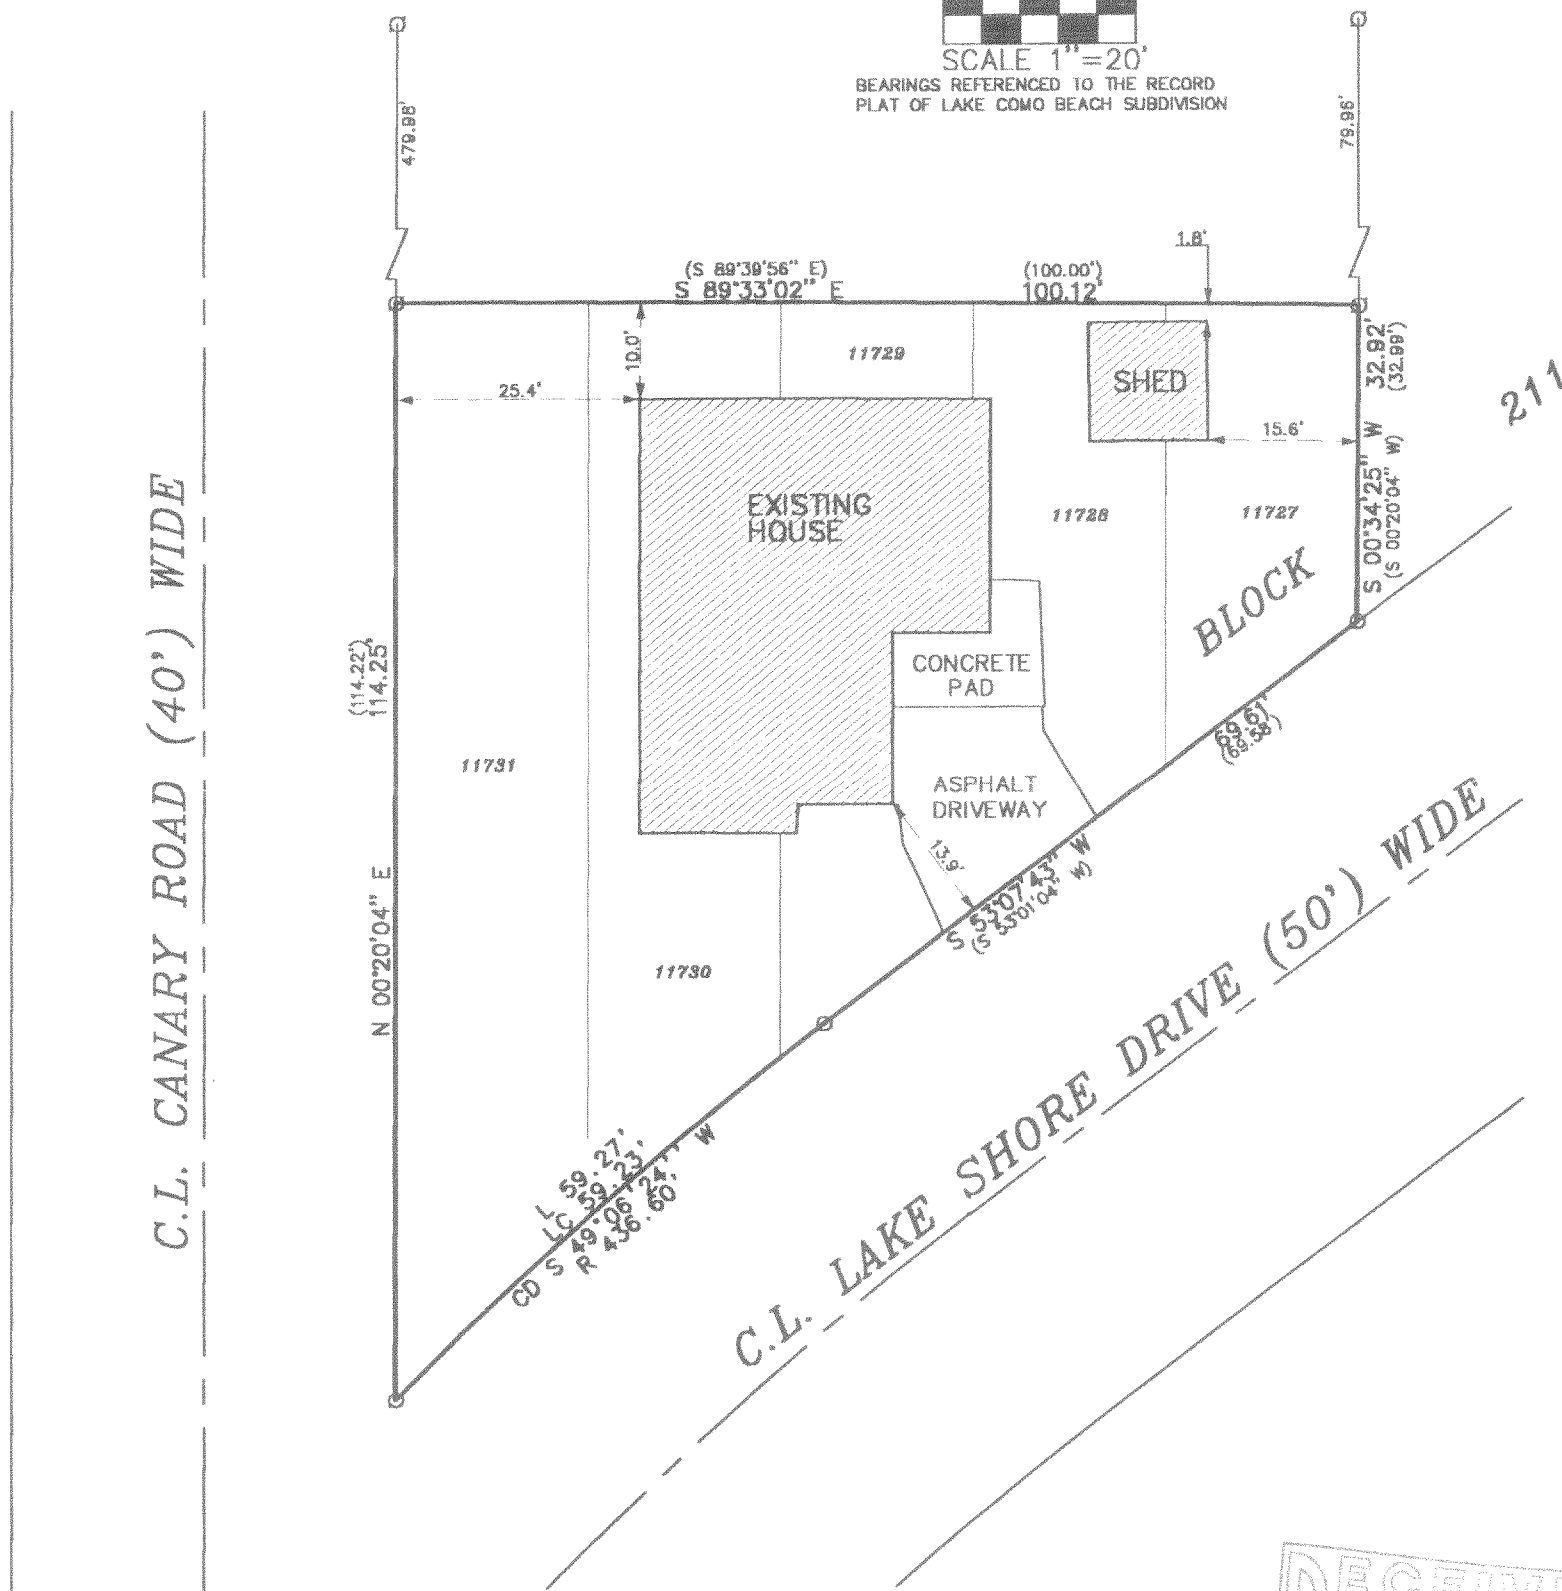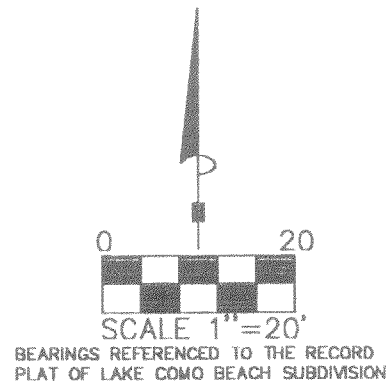


THE ABOVE MAP IS A TRUE REPRESENTATION THEREOF AND
SHOWS THE SIZE AND LOCATION OF ALL THE PROPERTY,
EXTERIOR BOUNDARIES, THE LOCATION OF ALL VISIBLE
BOUNDARY FENCES, APPARENT EASEMENTS, ROADWAYS
AND VISIBLE ENCROACHMENTS, IF ANY

THIS SURVEY IS MADE FOR THE USE OF THE PRESENT
OWNERS OF THE PROPERTY, AND ALSO THOSE WHO
PURCHASE, MORTGAGE OR GUARANTEE TITLE THERETO
WITHIN ONE (1) YEAR FROM DATE HERETO.


JOHN P. KROTT, R.L.S. 2258

LEGEND
○ FOUND IRON PIPE
(XXXX) RECORDED AS

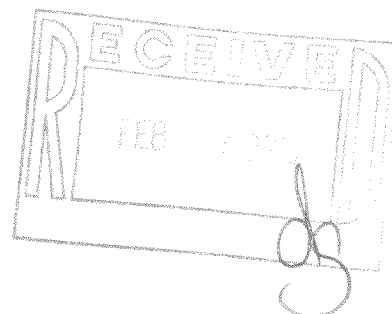

NOTE: THIS IS NOT A CERTIFIED COPY
UNLESS SEAL IS IN RED.

JOB NUMBER #89285 2-17-JLCB 2551

JLCB-2551

217-1860