
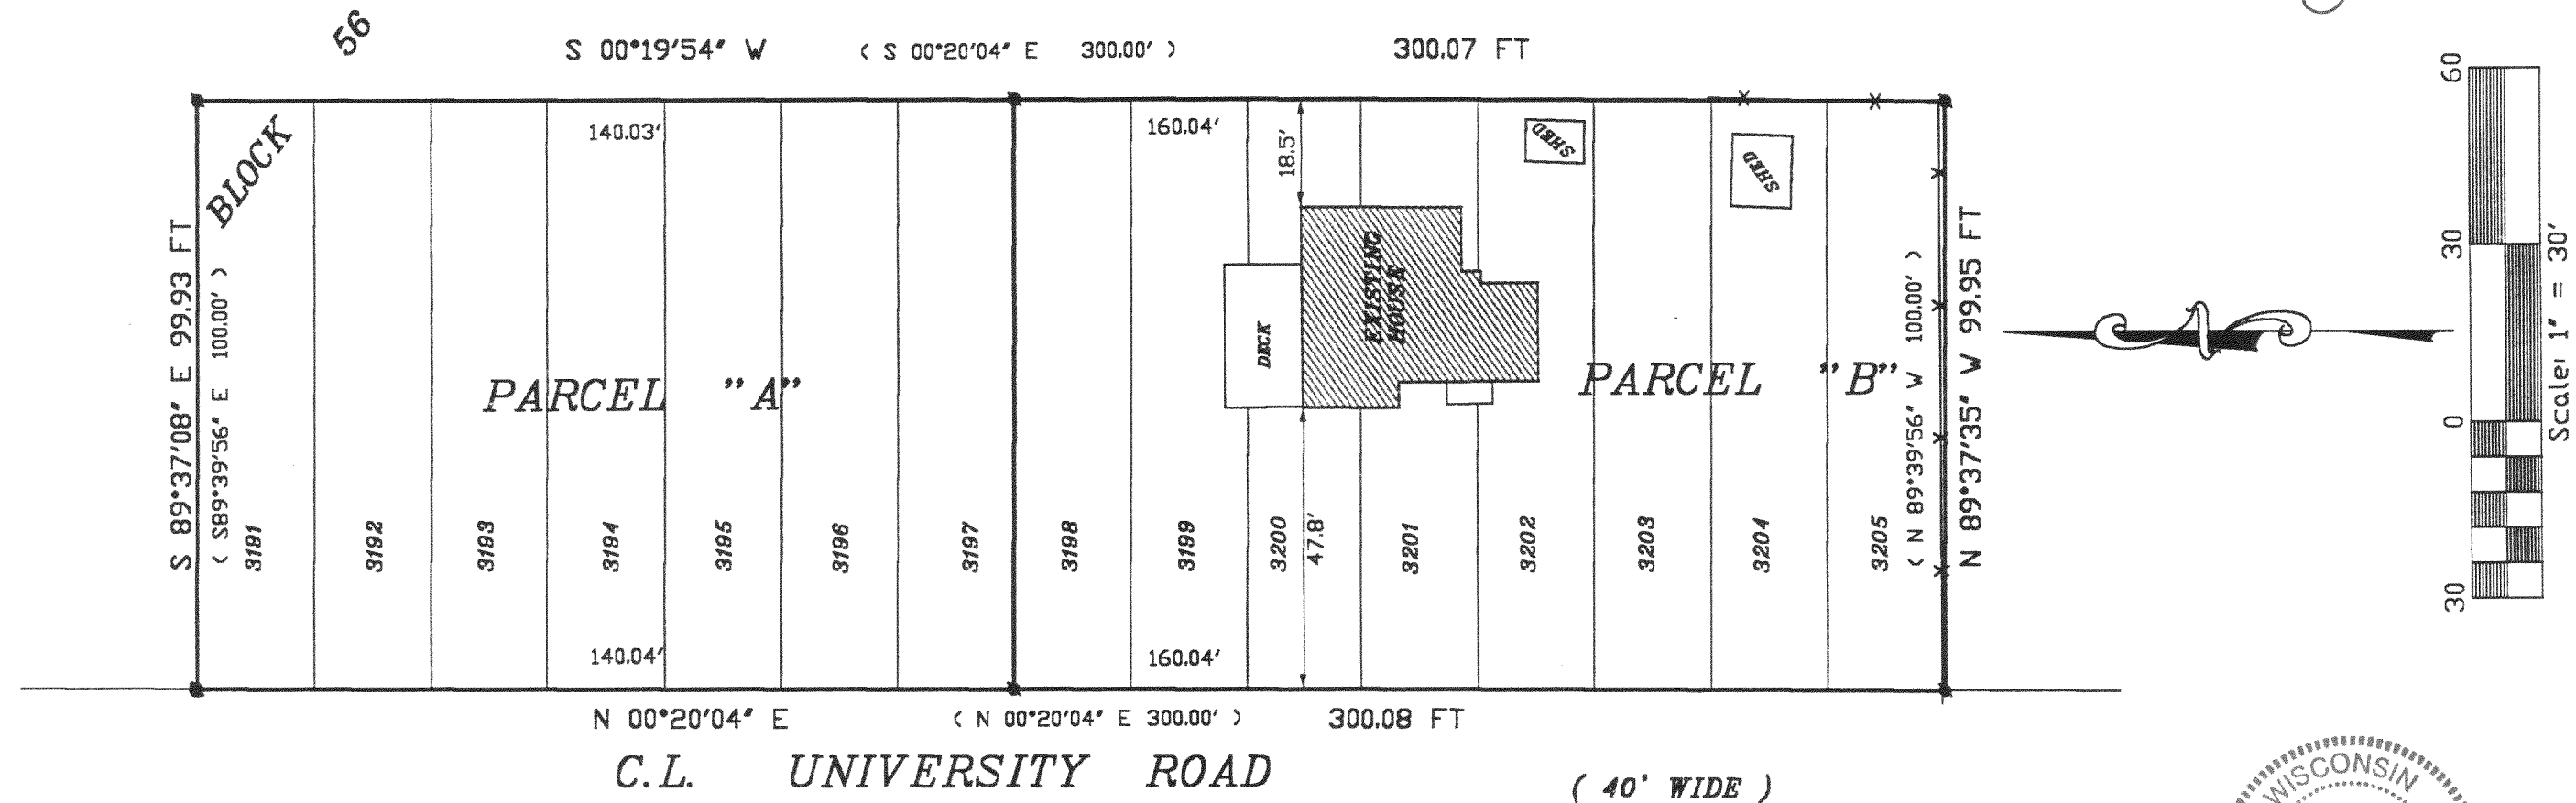


PLAT OF SURVEY

NOTE: THIS IS A PARCEL SPLIT OF TAX KEY # JLCB 00581
DESCRIPTION:

PARCEL "A" LOTS 3191 THRU 3197 ALL INCLUSIVE BLOCK 56
LAKE COMO BEACH SUBDIVISION. LOCATED IN T.2N. , R.17.E. ,
WALWORTH COUNTY , WISCONSIN.

PARCEL "B" LOTS 3198 THRU 3205 ALL INCLUSIVE BLOCK 56
LAKE COMO BEACH SUBDIVISION. LOCATED IN T.2N. , R.17.E. ,
WALWORTH COUNTY , WISCONSIN.

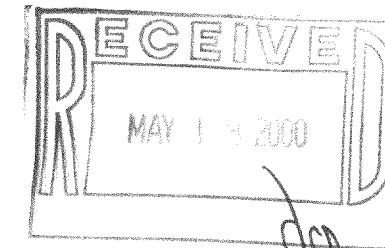

ORDERED BY:
JULIA KESLINKE
873 MADELYN DR.
DES PLAINES, IL 60016

LEGEND

- FOUND IRON PIPE
- SET IRON PIPE
- X— FENCE
- (XXXX) RECORDED AS

PATHFINDER SURVEYING
FORMERLY KOLB LAND CONSULTING
929 WILLIAMS STREET LAKE GENEVA, WI. 53147
(262)- 248-3697

THE ABOVE MAP IS A TRUE REPRESENTATION THEREOF AND
SHOWS THE SIZE AND LOCATION OF ALL THE PROPERTY,
EXTERIOR BOUNDARIES, THE LOCATION OF ALL VISIBLE
BOUNDARY FENCES, APPARENT EASEMENTS, ROADWAYS
AND VISIBLE ENCROACHMENTS, IF ANY

THIS SURVEY IS MADE FOR THE USE OF THE PRESENT
OWNERS OF THE PROPERTY, AND ALSO THOSE WHO
PURCHASE, MORTGAGE OR GUARANTEE TITLE THERETO
WITHIN ONE (1) YEAR FROM DATE HERETO.



DATE: 3 / 17 / 2000

John P. Krott
JOHN P. KROTT, R.L.S. 2258

NOTE: THIS IS NOT A CERTIFIED COPY
UNLESS SEAL IS IN RED.

JOB NUMBER: 00043- 2-17-JLCB00581

217-1912

JLCB-581
580A