

AMBIT LAND SURVEYING
P. O. Box 42
Bassett, WI. 53101



PLAT OF SURVEY

OF

PHONE 262-537-4874
FAX 262-537-4221

Lots 3893 through 3897, Block 67, inclusive and Lots 3919 through 3923, Block 67, inclusive, in LAKE COMO BEACH SUBDIVISION, being a subdivision located in Sections 21, 22, 27, 28 and 29, Township 2 North, Range 17 East of the 4th Principal Meridian, Geneva Township, Walworth County, Wisconsin.

LEGAL DESCRIPTION AS PROVIDED

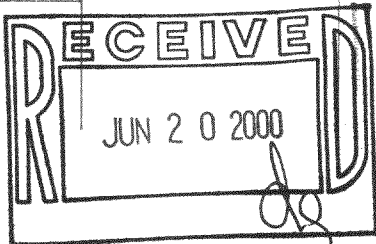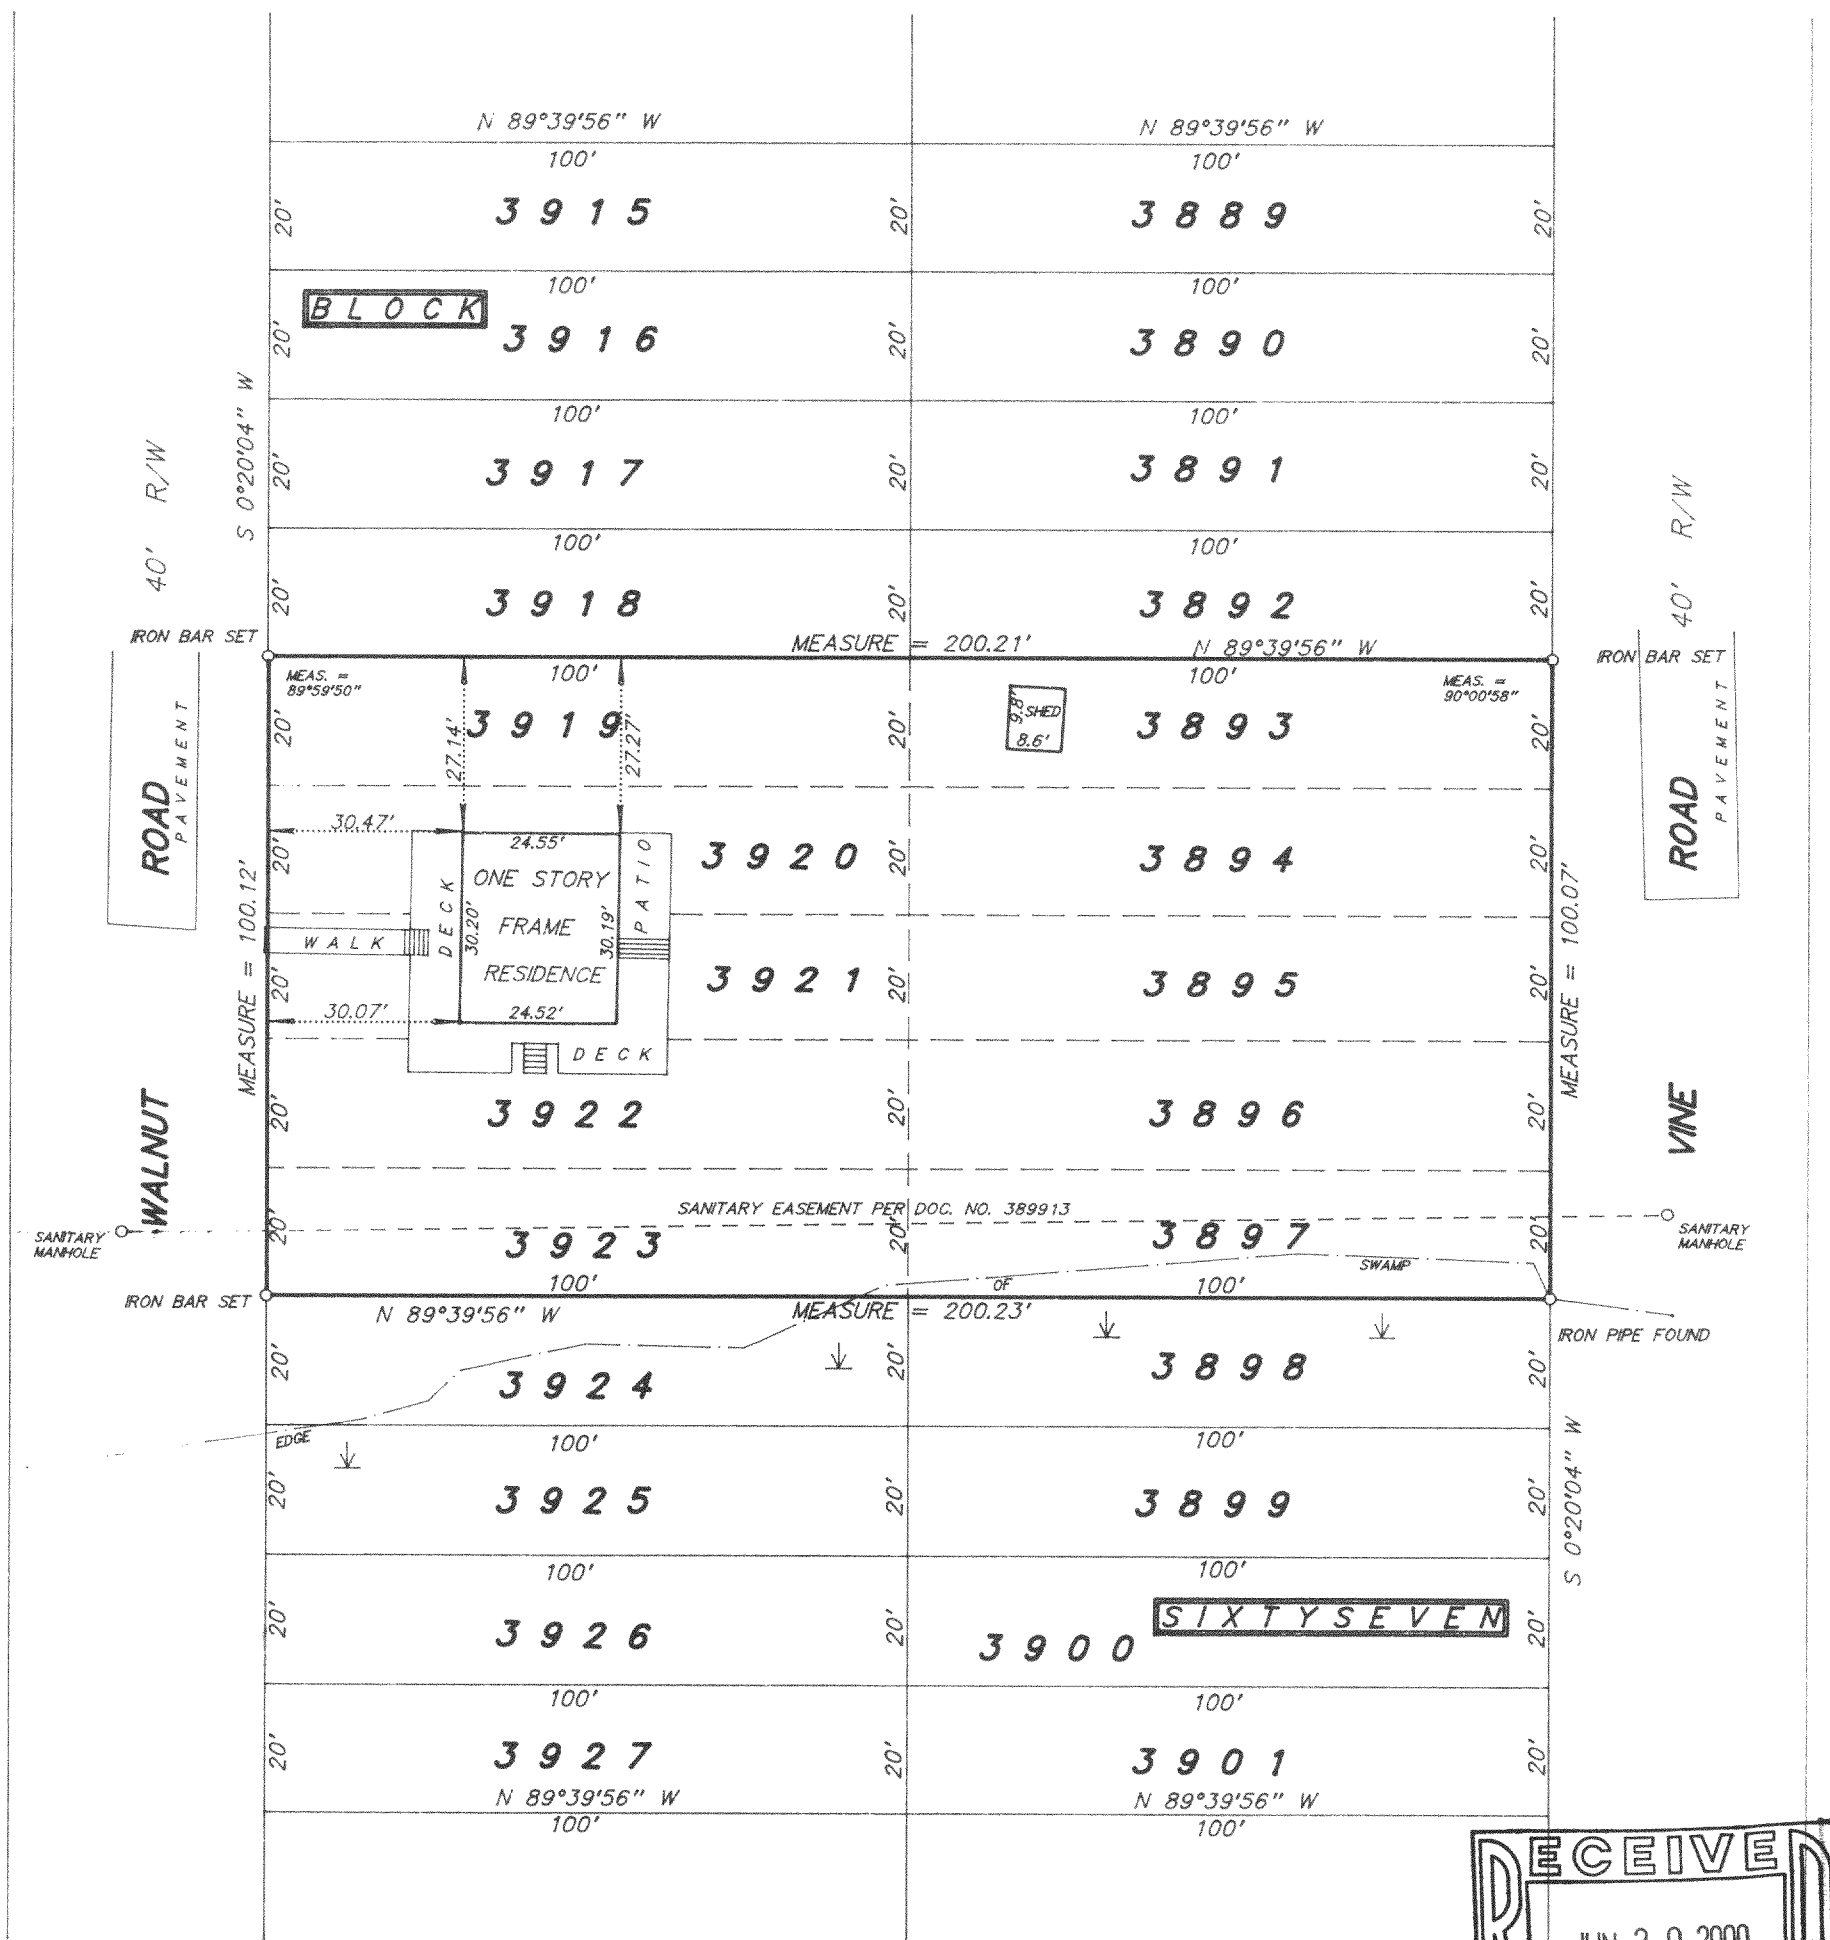

SCALE 1 inch = 30 feet
ORDERED BY B. Limosani / Homestead Lakes Realty
JOB NO. 99357

I hereby certify that I have surveyed the above described property and the above plat is a true representation thereof and shows the size and location of the property, its exterior boundaries, the location and dimensions of all visible structures thereon, boundary fences, apparent easements and roadways and visible encroachments, if any.

This survey is made for the exclusive use of the present owners of the property, and also those who purchase, mortgage, or guarantee the title thereto within one year from the date hereof.

Dated at Bassett, Wisconsin this _____ day of _____ 1999.

Mark A. Bolender
Wisconsin Registered Land Surveyor S - 1784

JLCB-744
JLCB-744A

217-1927