

LOCATED IN TOWN 2 NORTH, RANGE 17 EAST
WALWORTH COUNTY, WISCONSIN

(MH) N RIM MH
(IE = 987.81)

992.30

987.50 988.99
TERMAIN
8" SAN. SEWER
378' SAN SEWER

GENEVA NATIONAL AVENUE
68' WIDE PRIVATE ROADWAY

33

N RIM SANITARY MH



(MH) (IE = 946.89)

WORK ORDERED BY
RESORT REALTY
W4240 STATE ROAD 50
LAKE GENEVA, WI. 53147

FARRIS, HANSEN & ASSOCIATES, INC.
Engineering, Architecture, Surveying
7 Ridgway Court P.O. Box 437
ELKHORN, WISCONSIN 53121
Office: (414) 723-2098
Fax: (414) 723-5886

REVISIONS

PROJECT NO.	3269.17-04
DATE:	07-28-00
SHEET NO.	1 OF 1

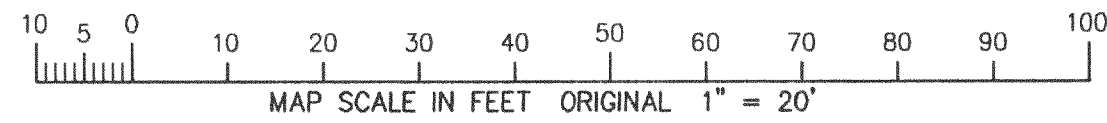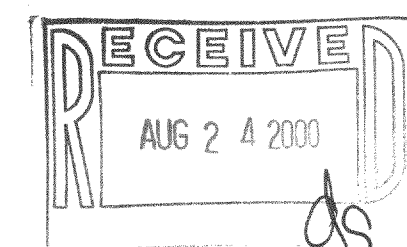

● = FOUND IRON REBAR STAKE
 ● = SET IRON REBAR STAKE
 (xxx) = RECORDED AS
 (H) = HYDRANT
 (MH) = SANITARY MANHOLE

UNIT 17-05

UNIT 17-04
24,352 S.F.

GOLF CLUB GROUNDS

NOTE: COPIES OF THIS MAP TO WHICH THE FOLLOWING CERTIFICATE WILL APPLY SHOW SURVEYOR'S ORIGINAL SEAL AND SIGNATURE IN RED INK. COPIES BY ANY OTHER MEANS MAY HAVE ALTERATIONS WHICH DO NOT REPRESENT THE SURVEYOR'S WORK PRODUCT.

I HEREBY CERTIFY THAT THE ABOVE DESCRIBED PROPERTY HAS BEEN SURVEYED UNDER MY DIRECTION AND THAT THE ABOVE MAP IS A TRUE REPRESENTATION THEREOF AND SHOWS THE SIZE AND LOCATION OF THE PROPERTY AND ITS EXTERIOR BOUNDARIES. THIS SURVEY IS MADE FOR THE USE OF THE PRESENT OWNERS OF THE PROPERTY, AND ALSO THOSE WHO PURCHASE, MORTGAGE, OR GUARANTEE THE TITLE THERETO WITHIN ONE YEAR FROM THE DATE HEREOF.

DATED: 7-28-2000

Peter S. Gordon
PETER S. GORDON R.L.S. 2101

JCN-17-4
217-1948