


ABERNATHY and ASSOCIATES

Kenneth B. Abernathy Jr.

Wisconsin Registered Land Surveyor S-1594

W4056 BRAY RD.
ELKHORN, WI. 53121
PHONE: (262) 723-4260 (OFFICE)
(262) 723-7209 (FAX)
Email: abernathy@elknet.net

PLAT OF SURVEY


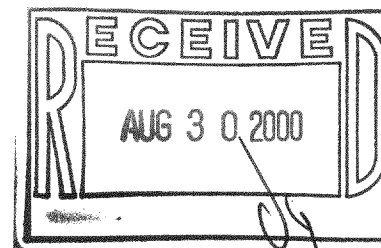


Ordered by: Bill Binn
WynTree Construction, Inc.
201 Broad Street
Post Office Box 460
Lake Geneva, Wisconsin
53147-0460

NOTE:
FLAGS WERE STAKED IN THE FIELD BY THE BUILDER FOR THE PROPOSED RESIDENCE. SEE BUILDERS PLAN FOR ADDITIONAL DETAILS.

THE SOUTHERLY POINT OF LOT 1 WAS NOT FOUND OR TIED TO IN THE COURSE OF THIS SURVEY BY WRITTEN AGREEMENT WITH CLIENT.

MONUMENTATION BY WRITTEN AGREEMENT WITH THE ABOVE NAMED CLIENT HAS BEEN WAIVED IN ACCORDANCE WITH AE 7.01 (2) OF THE WISCONSIN ADMINISTRATIVE CODE.

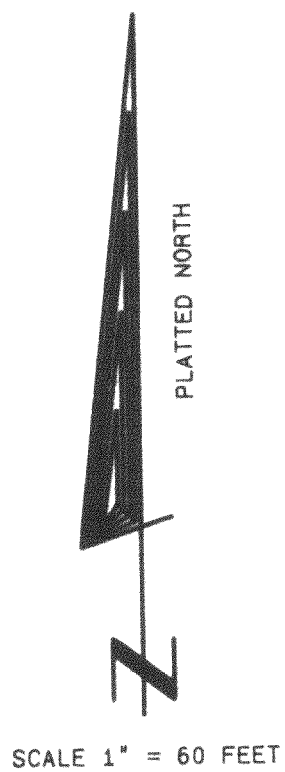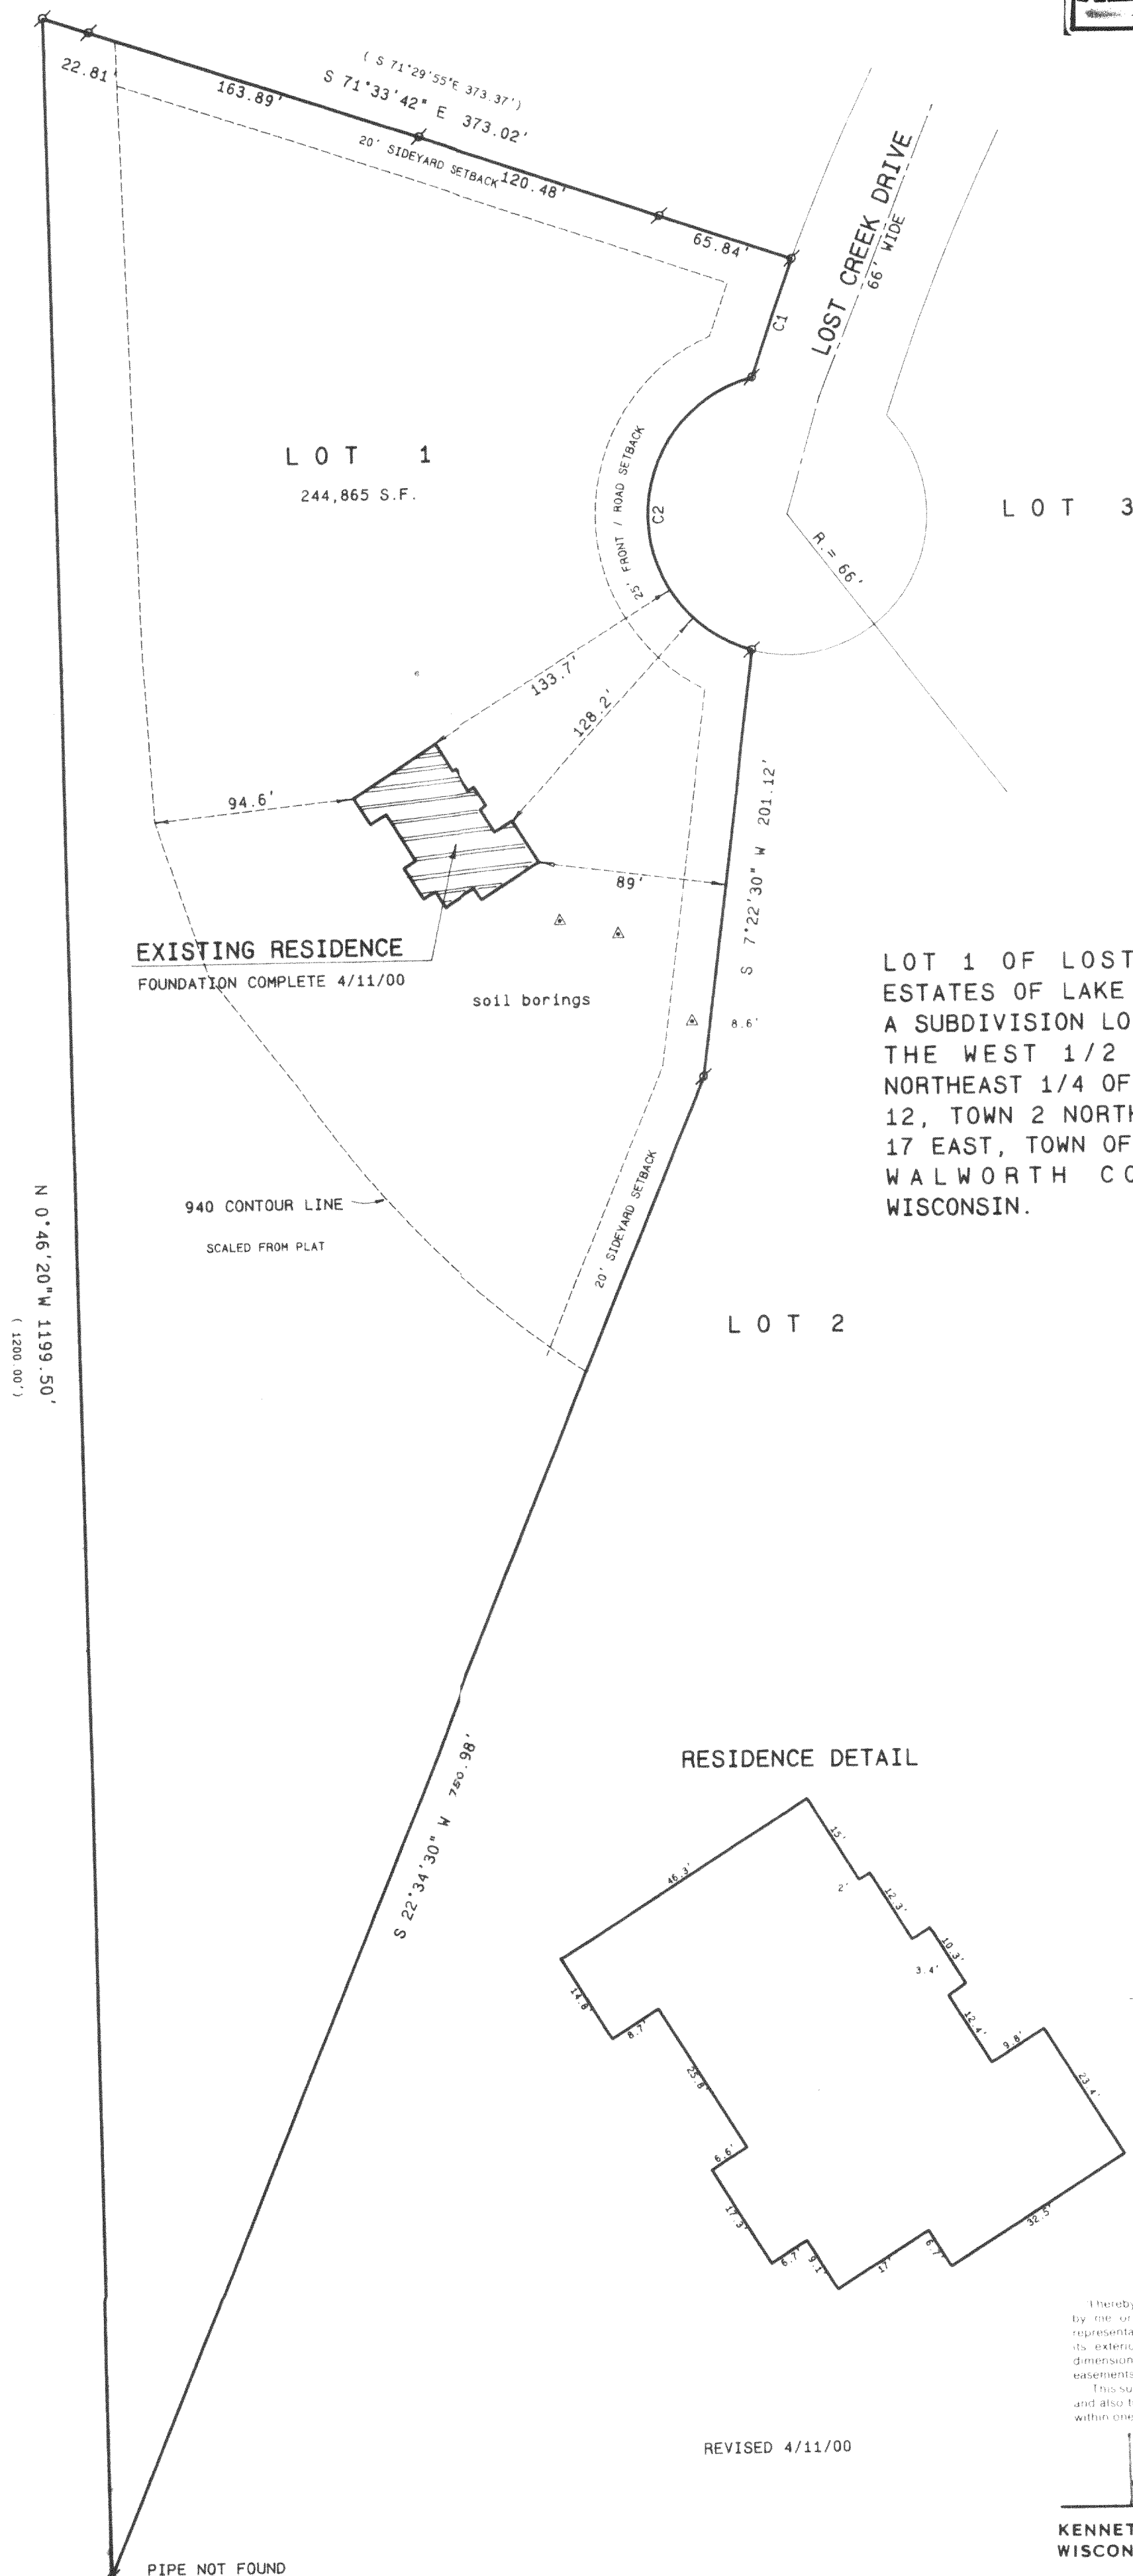

I hereby certify that the above described property has been surveyed by me or under my direction and that the above map is a true representation thereof and shows the size and location of the property, its exterior boundaries, the location of all visible structures, and dimensions of all principal buildings thereon, boundary fences, apparent easements, roadways and visible encroachments, if any.

This survey is made for the use of the present owners of the property, and also those who purchase, mortgage, or guarantee the title thereto within one year from date hereof.

Kenneth B. Abernathy, Jr.
KENNETH B. ABERNATHY, JR.
WISCONSIN REGISTERED LAND SURVEYOR,
S-1594

Date: 4/11/00 Job No. 98209

JLO-1

217-1959