


ABELL
SURVEYING & MAPPING

1140 SEQUOIA STREET • DELAVAN, WISCONSIN 53115
262-728-6737




N

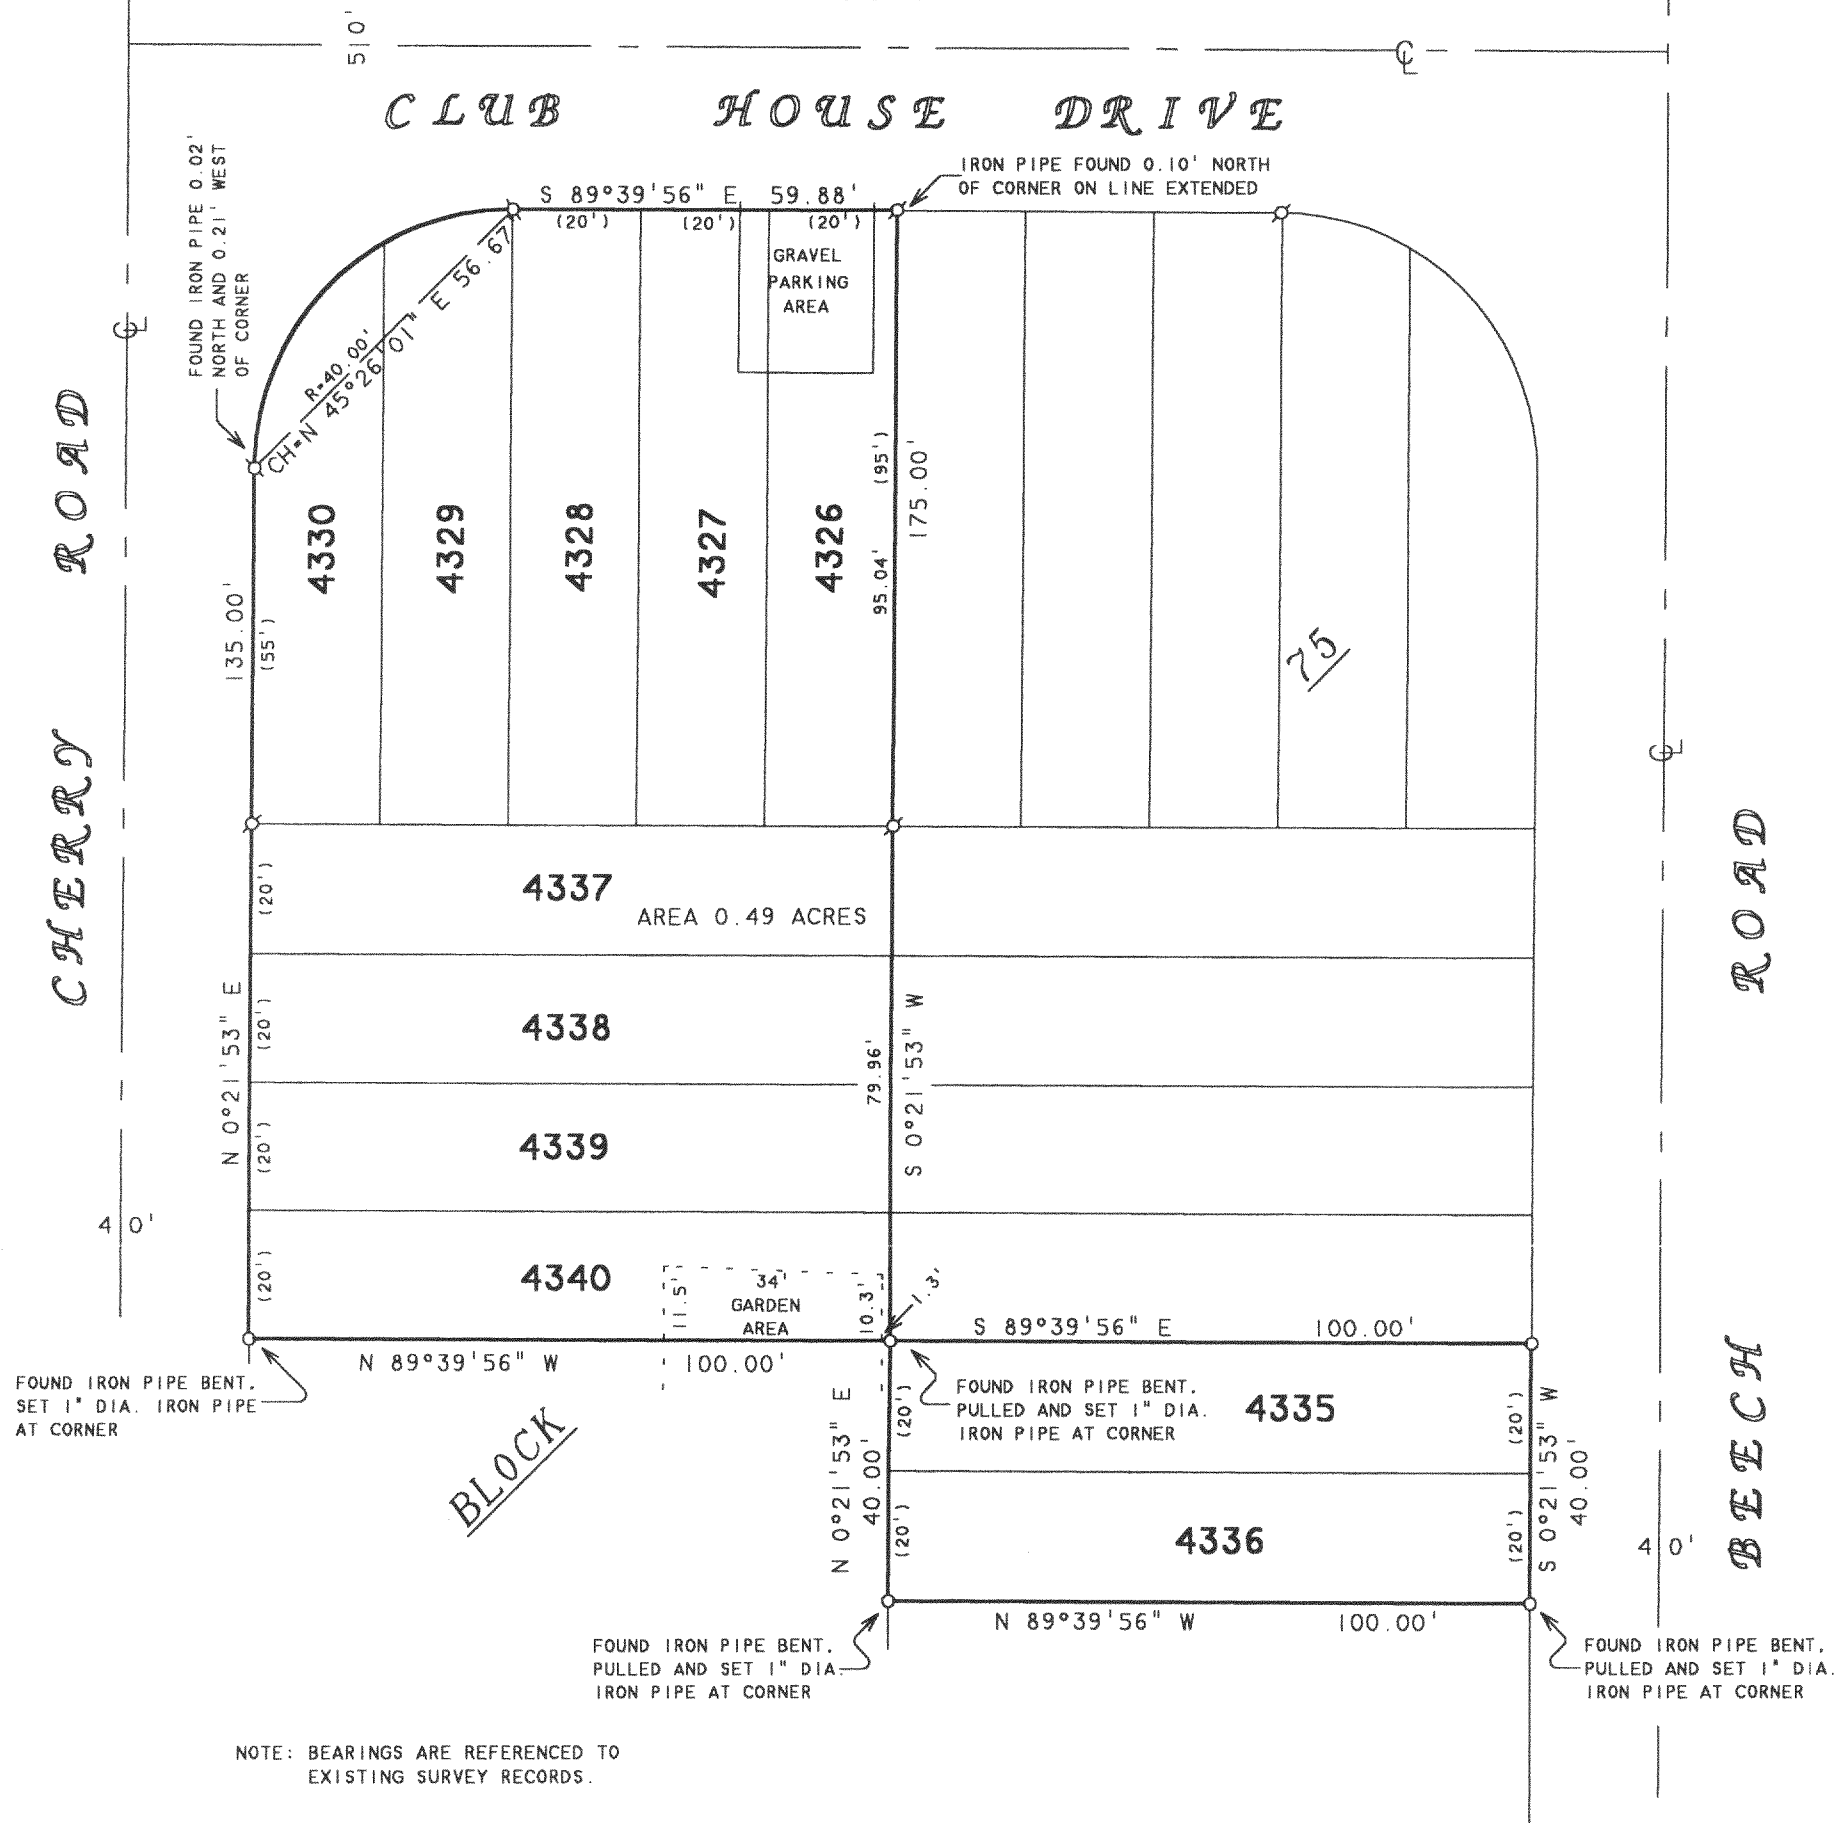

SCALE 1"=30'

LEGEND

○ - IRON PIPE FOUND
○ - 1" DIA. IRON PIPE SET
○ - RECORDED AS

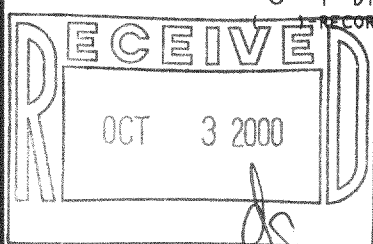

ORDERED BY: ELEANOR KOTERSKI
5874 N. FOREST GLEN AVENUE
CHICAGO, IL 60646

PLAT OF SURVEY OF

LOTS 4326-4330 AND 4335-4340, BLOCK 75, LAKE COMO
BEACH SUBDIVISION, LOCATED IN T2N, R17E, WALWORTH
COUNTY, WISCONSIN.

I, DAVID F. ABELL, DO HEREBY CERTIFY THAT I HAVE SURVEYED THE PROPERTY HEREON
DESCRIBED ACCORDING TO THE OFFICAL RECORDS AND THAT THE PLAT HEREON IS A
CORRECT REPRESENTATION OF THE PROPERTY LINES TO THE BEST OF MY KNOWLEDGE AND
BELIEF.

David F. Abell

DAVID F. ABELL
WISCONSIN REGISTERED LAND SURVEYOR, S-1596

September 19, 2000

DATE JOB NUMBER - 00129
NOTE: THIS IS NOT A CERTIFIED COPY UNLESS SEALED.

JLCB-844

JLCB-843A

JLCB-843

217-1971