


HAROLD H. KOLB

REGISTERED PROFESSIONAL LAND SURVEYOR
LAKE GENEVA, WISCONSIN

BLOCK

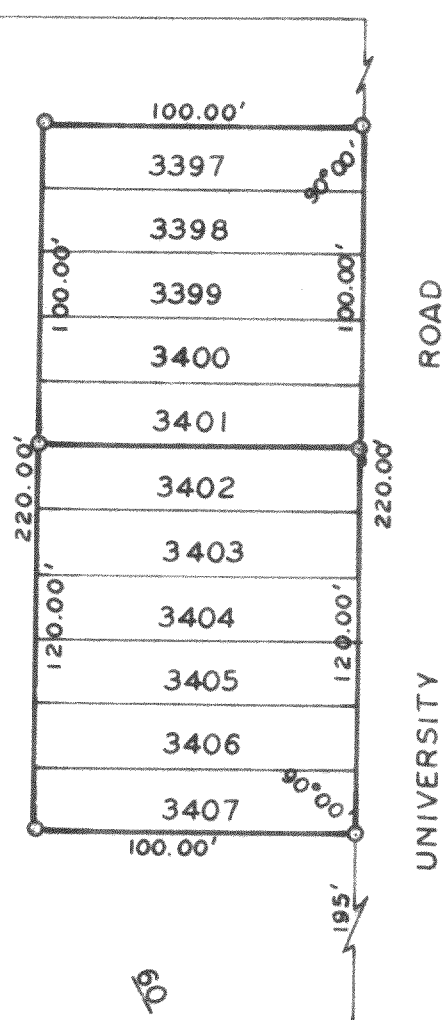

PLAT OF SURVEY OF
Lots 3397-3401 and 3402-
3407, Block 60, Lake Como
Beach, a subdivision loc-
ated in T 2 N, R 17 E,
Walworth County, Wiscon-
sin.

N



SCALE: 1"=60'
LEGEND

- Ø - IRON PIPE FOUND
- - IRON PIPE PLACED
- - CONCRETE MONUMENT
- X - SPIKE

PARK

50'

DRIVE

I, HAROLD H. KOLB, DO HEREBY CERTIFY THAT I HAVE
SURVEYED THE PROPERTY HEREON DESCRIBED ACCORDING
TO THE OFFICIAL RECORDS, AND THAT THE PLAT HEREON
IS A CORRECT REPRESENTATION OF THE LOT LINES.

Harold H. Kolb

HAROLD H. KOLB

WISCONSIN REGISTERED LAND SURVEYOR, S-187

DATE January 26, 1968

JLCB-628, 629, 629A

217-205