


PLAT OF SURVEY  
LOTS 9427 THRU 9431, & LOT 9437  
BLOCK 170  
LAKE COMO BEACH SUBDIVISION

LOCATED IN PART OF SECTION 21  
TOWN 2 NORTH, RANGE 17 EAST  
WALWORTH COUNTY, WISCONSIN

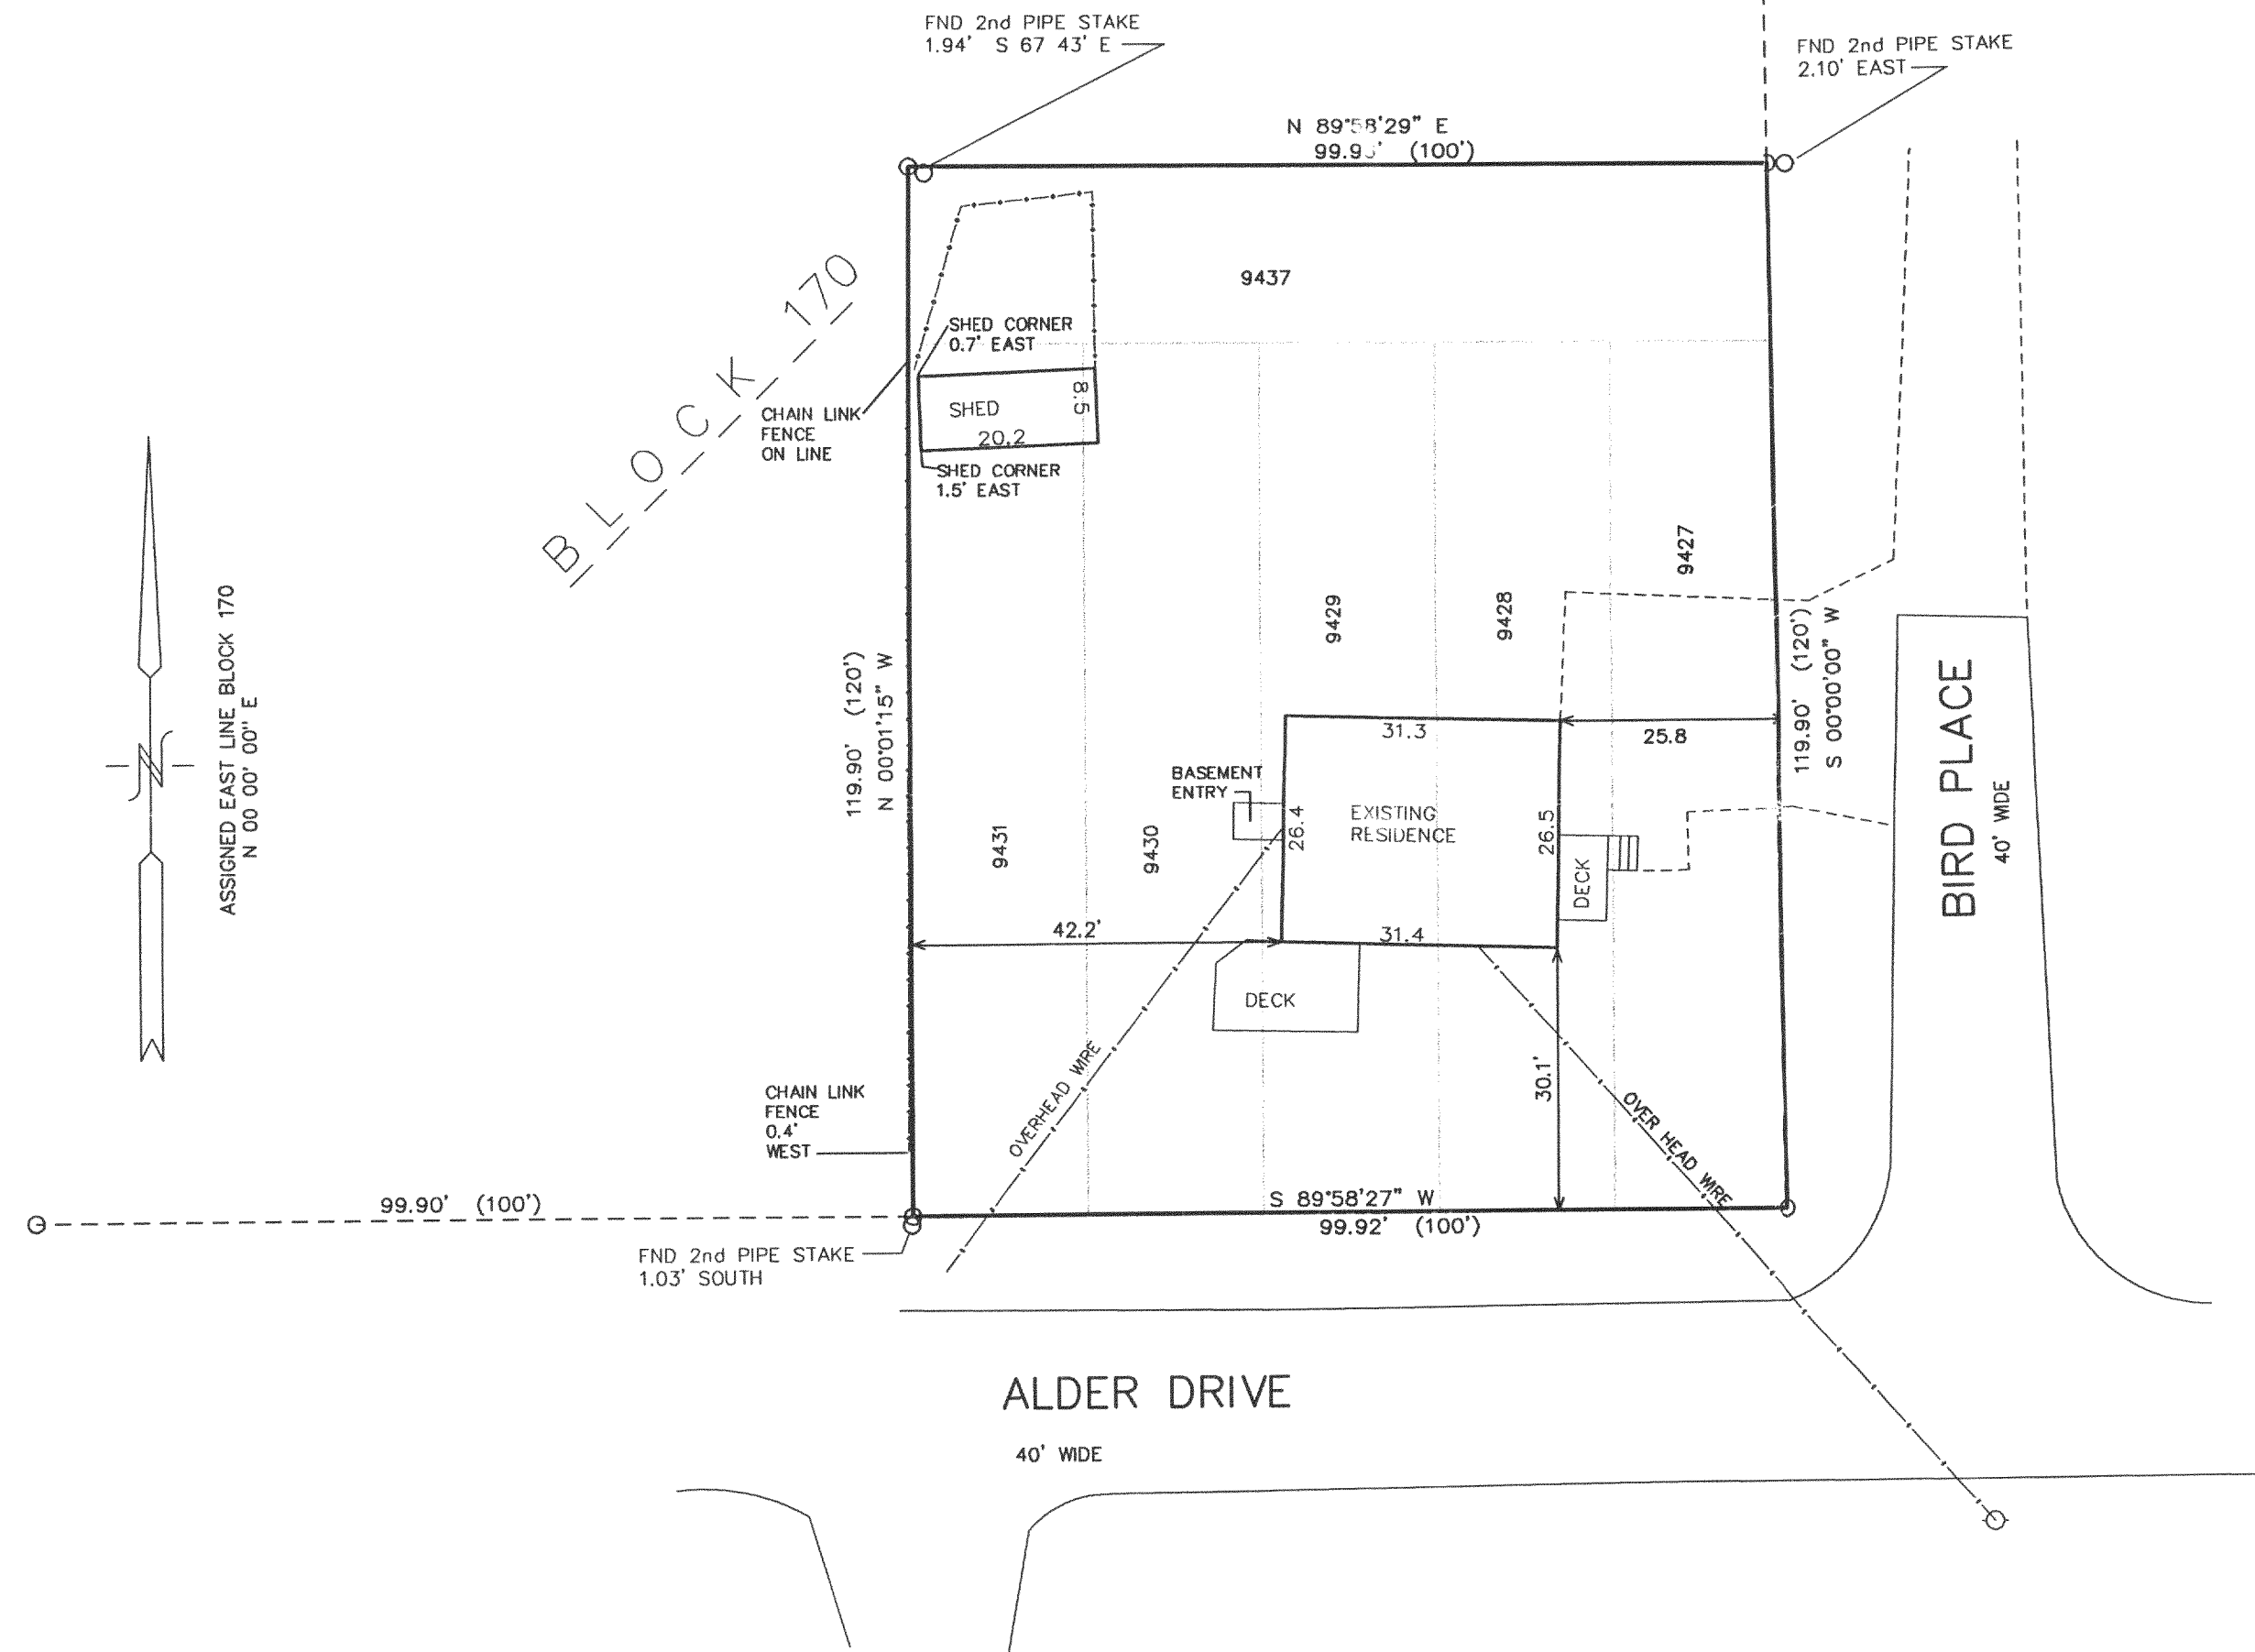


LEGEND  
O = FOUND IRON PIPE STAKE  
= FOUND IRON REBAR STAKE  
(xxx) = RECORDED AS

NOTE: COPIES OF THIS MAP TO WHICH THE FOLLOWING  
CERTIFICATE WILL APPLY SHOW SURVEYOR'S ORIGINAL SEAL  
AND SIGNATURE IN RED INK. COPIES BY ANY OTHER MEANS  
MAY HAVE ALTERATIONS WHICH DO NOT REPRESENT THE  
SURVEYOR'S WORK PRODUCT.

I HEREBY CERTIFY THAT THE ABOVE DESCRIBED PROPERTY HAS  
BEEN SURVEYED UNDER MY DIRECTION AND THAT THE ABOVE MAP  
IS A TRUE REPRESENTATION THEREOF AND SHOWS THE SIZE AND  
LOCATION OF THE PROPERTY AND ITS EXTERIOR BOUNDARIES.  
THIS SURVEY IS MADE FOR THE USE OF THE PRESENT OWNERS  
OF THE PROPERTY, AND ALSO THOSE WHO PURCHASE, MORTGAGE,  
OR GUARANTEE THE TITLE THERETO WITHIN ONE YEAR FROM THE  
DATE HEREOF.

DATED: MARCH 28, 2001  
PETER S. GORDON R.L.S. 2101

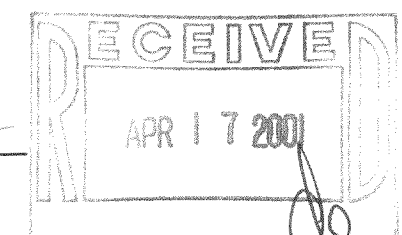

WORK ORDERED BY:  
ERIC SEAVER  
N3456 STH "H"  
LAKE GENEVA, WI. 53147

FARRIS, HANSEN & ASSOCIATES, INC.  
Engineering, Architecture, Surveying  
7 Ridgway Court P.O. Box 437  
ELKHORN, WISCONSIN 53121  
Office: (414) 723-2098  
Fax: (414) 723-5896

REVISIONS

PROJECT NO.  
5761  
DATE:  
03-26-01  
SHEET NO.  
1 OF 1

MAP SCALE IN FEET ORIGINAL 1" = 20'

MAR 29 2001

217-2082  
JLCB-2032