


HAROLD H. KOLB
REGISTERED PROFESSIONAL LAND SURVEYOR
LAKE GENEVA, WISCONSIN

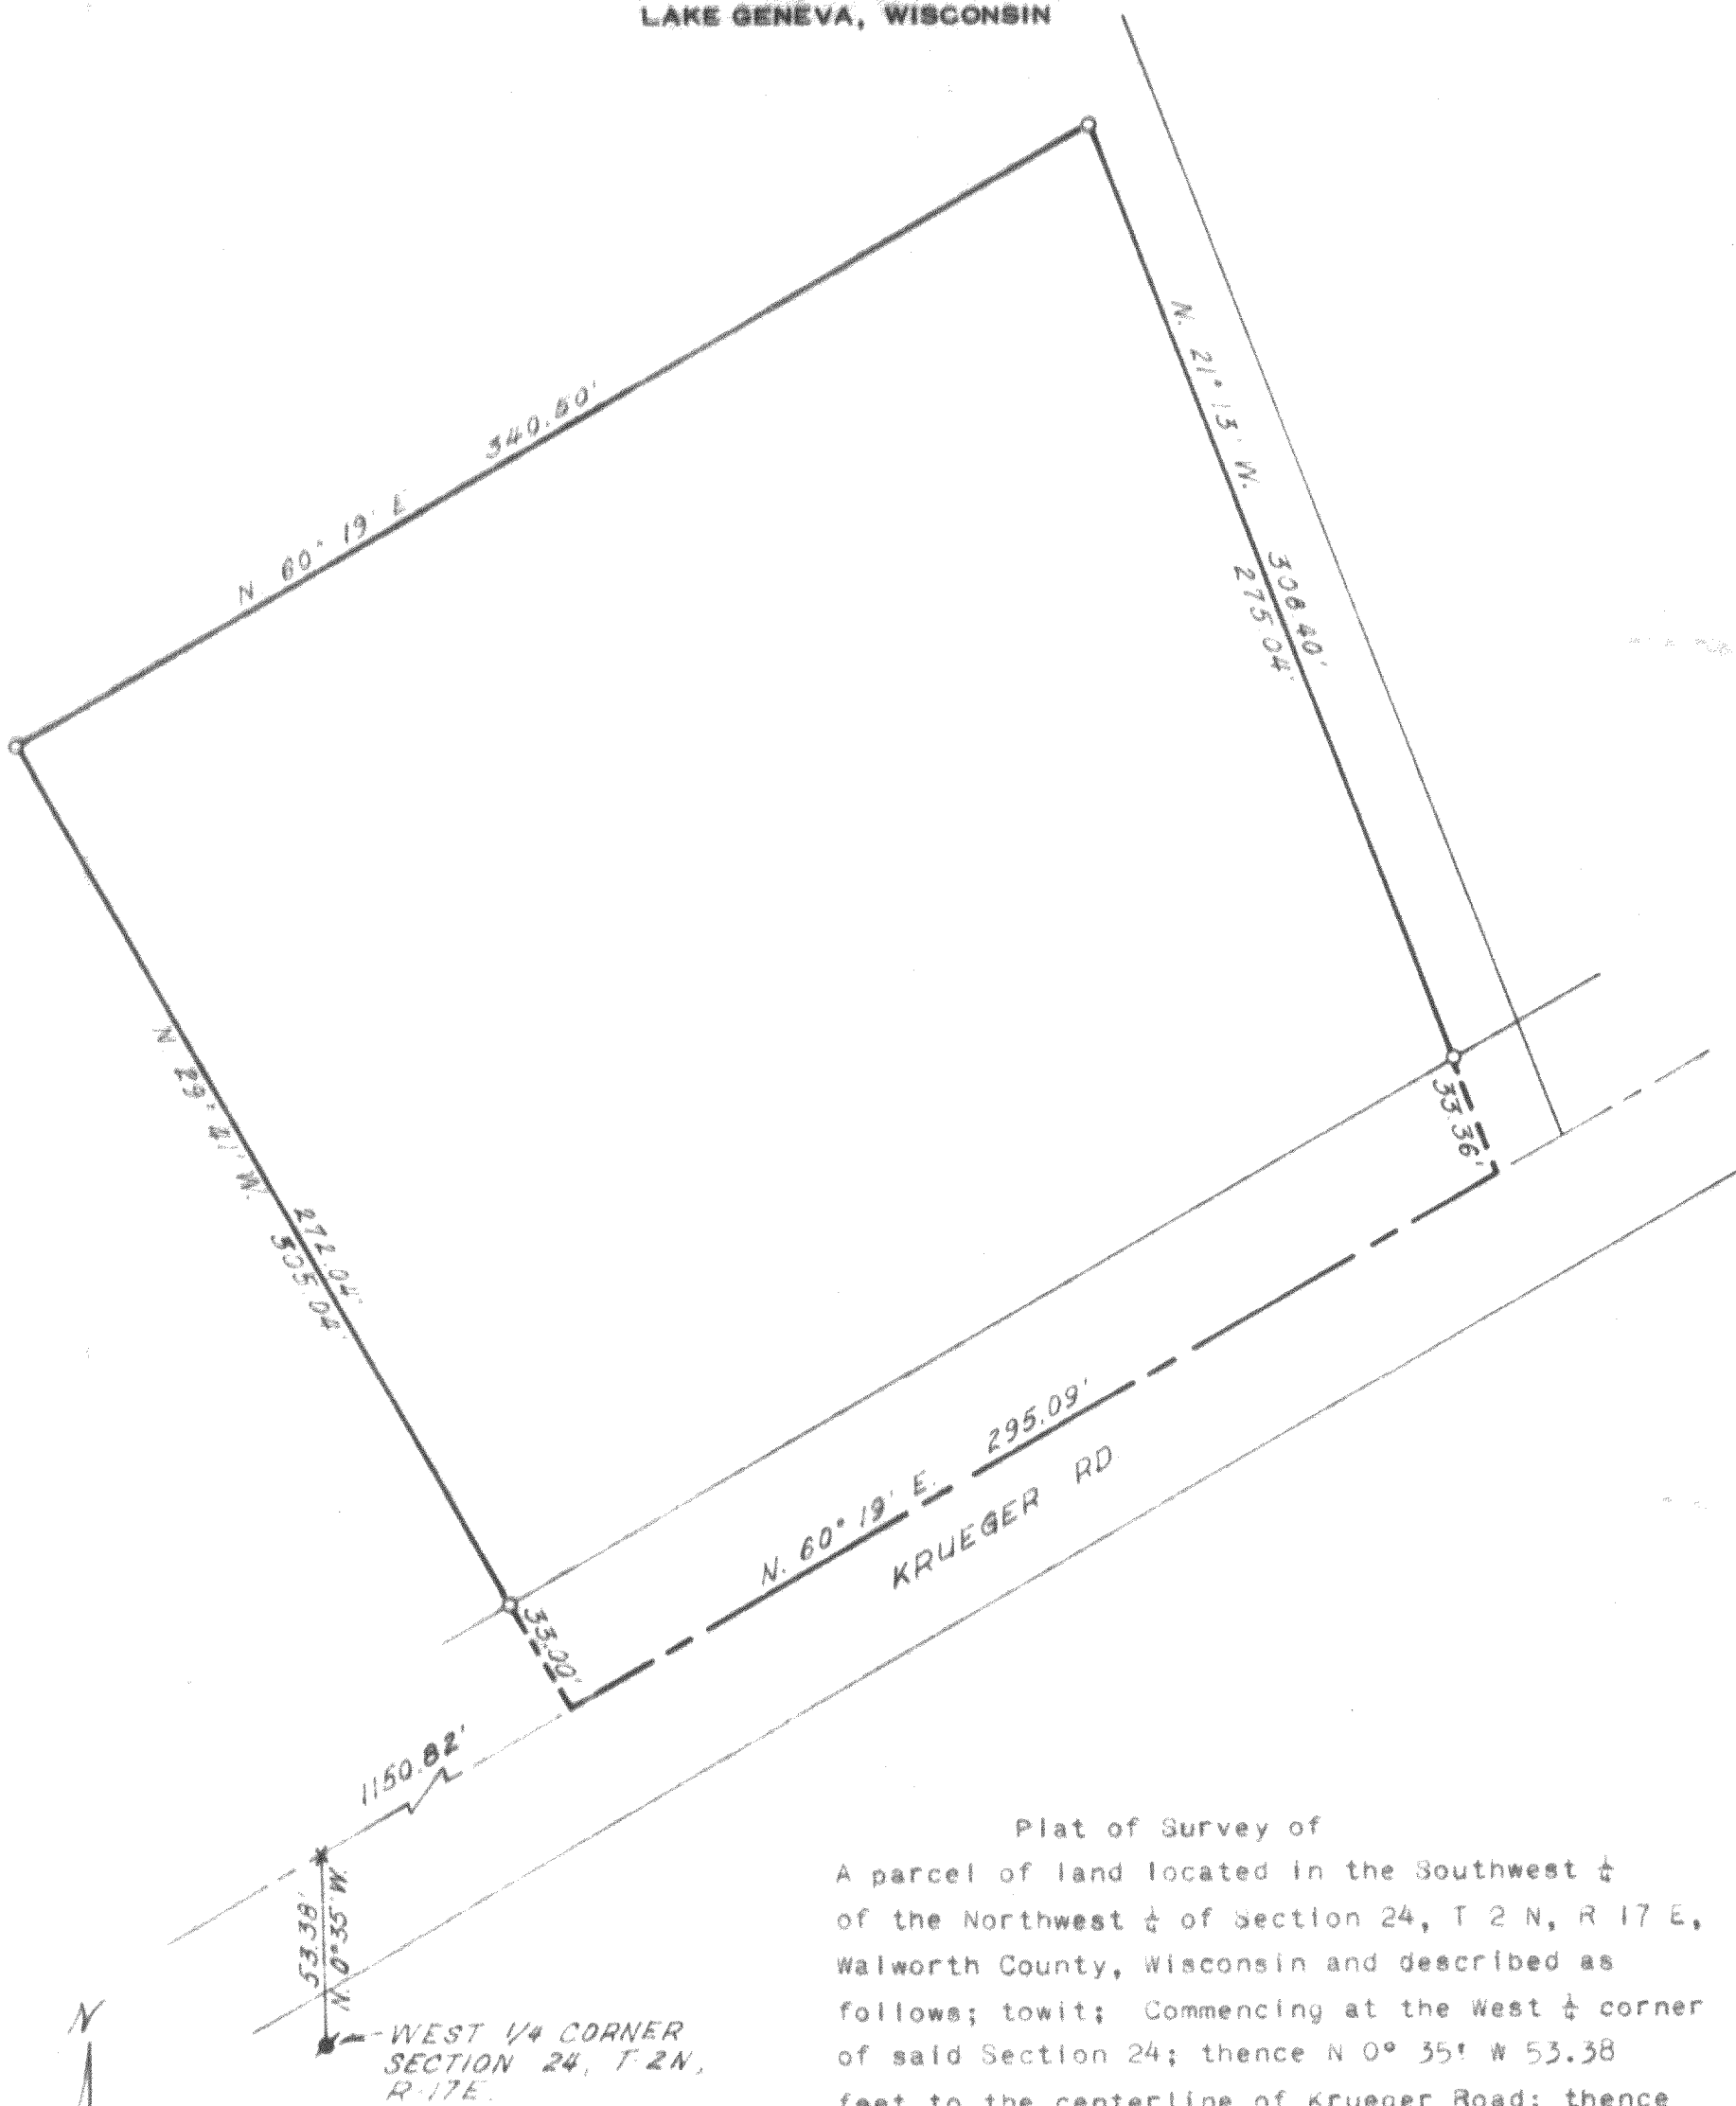

Containing 2.23 acres or
2.00 acres exclusive of road
right-of-way.

LEGEND
 ⚭ - IRON PIPE FOUND
 ○ - IRON PIPE PLACED
 ● - CONCRETE MONUMENT
 X - SPIKE
 SCALE 1" = 50'



Plat of Survey of
A parcel of land located in the Southwest $\frac{1}{4}$
of the Northwest $\frac{1}{4}$ of Section 24, T 2 N, R 17 E,
Walworth County, Wisconsin and described as
follows; to-wit; Commencing at the West $\frac{1}{4}$ corner
of said Section 24; thence N 0° 35' W 53.38
feet to the centerline of Krueger Road; thence
N 60° 19' E 1150.82 feet along said centerline
to the place of beginning; thence N 29° 41' W
305.04 feet; thence N 60° 19' E 340.50 feet;
thence S 21° 13' 308.40 feet to the centerline
of said Krueger Road; thence S 60° 19' W along
said centerline 295.09 feet to the place of
beginning.

I, HAROLD H. KOLB, DO HEREBY CERTIFY THAT I HAVE
SURVEYED THE PROPERTY HEREON DESCRIBED ACCORDING
TO THE OFFICIAL RECORDS, AND THAT THE PLAT HEREON
IS A CORRECT REPRESENTATION OF THE LOT LINES.

Harold H. Kolb
HAROLD H. KOLB
WISCONSIN REGISTERED LAND SURVEYOR, S-187
DATE July 24, 1968

G-24-6A

217-214

217-124