PREPARED FOR: **BASSO BUILDERS** 403 SKYLINE DR LAKE GENEVA, WI 53147

PLAT OF SURVEY

J.K. SURVEYING INC. N3705 WILLOWBEND LANE LAKE GENEVA, WI, 53147 262-248-3697


1 du

MAK

LOTS 9417-9421 BLOCK 169 OF LAKE COMO BEACH SUBDIVISION; LOCATED IN TOWN 2 NORTH, RANGE 17 EAST, WALWORTH COUNTY, C WISCONSIN

ALDER DRIVE

(40.00' WIDE)

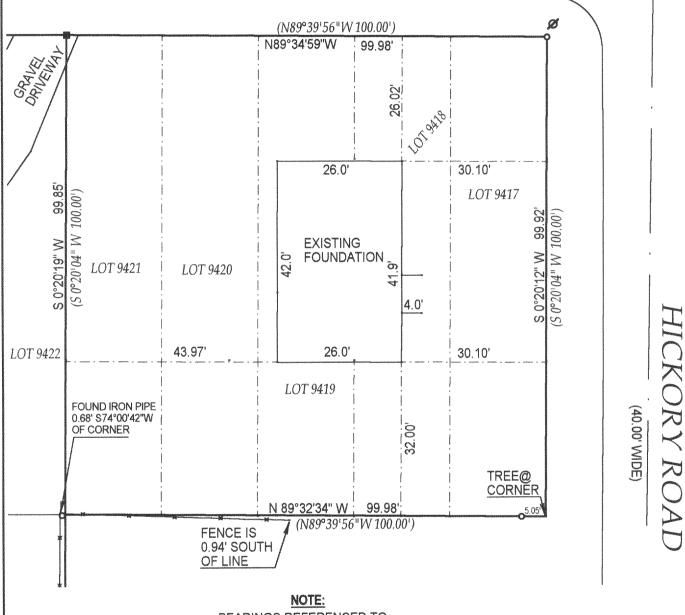

BEARINGS REFERENCED TO THE RECORDED PLAT OF LAKE COMO BEACH SUBDIVISION

)= recorded as

☐ = found iron bar

DATE OF LAST REVISION: 1/07/2002

= found iron pipe

COMPARE LEGAL DESCRIPTION ABOVE AND DRAWING WITH DEED. FOR BUILDING RESTRICTIONS AND EASEMENTS NOT SHOWN, REFER TO DEED, ABSTRACT SOURCES AND LOCAL MUNICIPAL CODES. NOTIFY THE SURVEYOR IMMEDIATELY OF ANY DISCREPANCY.

= set iron pipe

= set iron bar SCALE 1" = 20'

JOB # 01-505PH

location of all visible structures, apparent easements and encroachments if any."

This survey is made for the present owners of the property, and those who purchase, mortgage, or guarantee the title thereto, within one year from the date hereof.

"I hereby certify that I have surveyed the above described property and that the above map is a true representation thereof and shows the size and

DATED THIS 8 TH, DAY OF NOVEMBER 20 01

JOHN KROTT S - 2258 Wisconsin Registered Land Surveyor

(original if signed in red)

JOHN P.
KROTT
S-2258
MUKWONAGO
WIS.

O SURVE

JLCB-2029A1

TAX ID # 2-17-JLCB

217-2246