


PLAT OF SURVEY

LOCATION: N3311 Beach Road, Geneva, Wisconsin

LEGAL DESCRIPTION: Lots 8701 thru 8704 and Lots 8712 thru 8716, both inclusive, as designated and delineated on the map entitled "Fourth Map of Lake Como Beach, Walworth County, Wisconsin" and recorded in the Office of the Register of Deeds in and for the County of Walworth and State of Wisconsin on the 1st day of May 1926.

January 23, 2002

Survey No. 94355

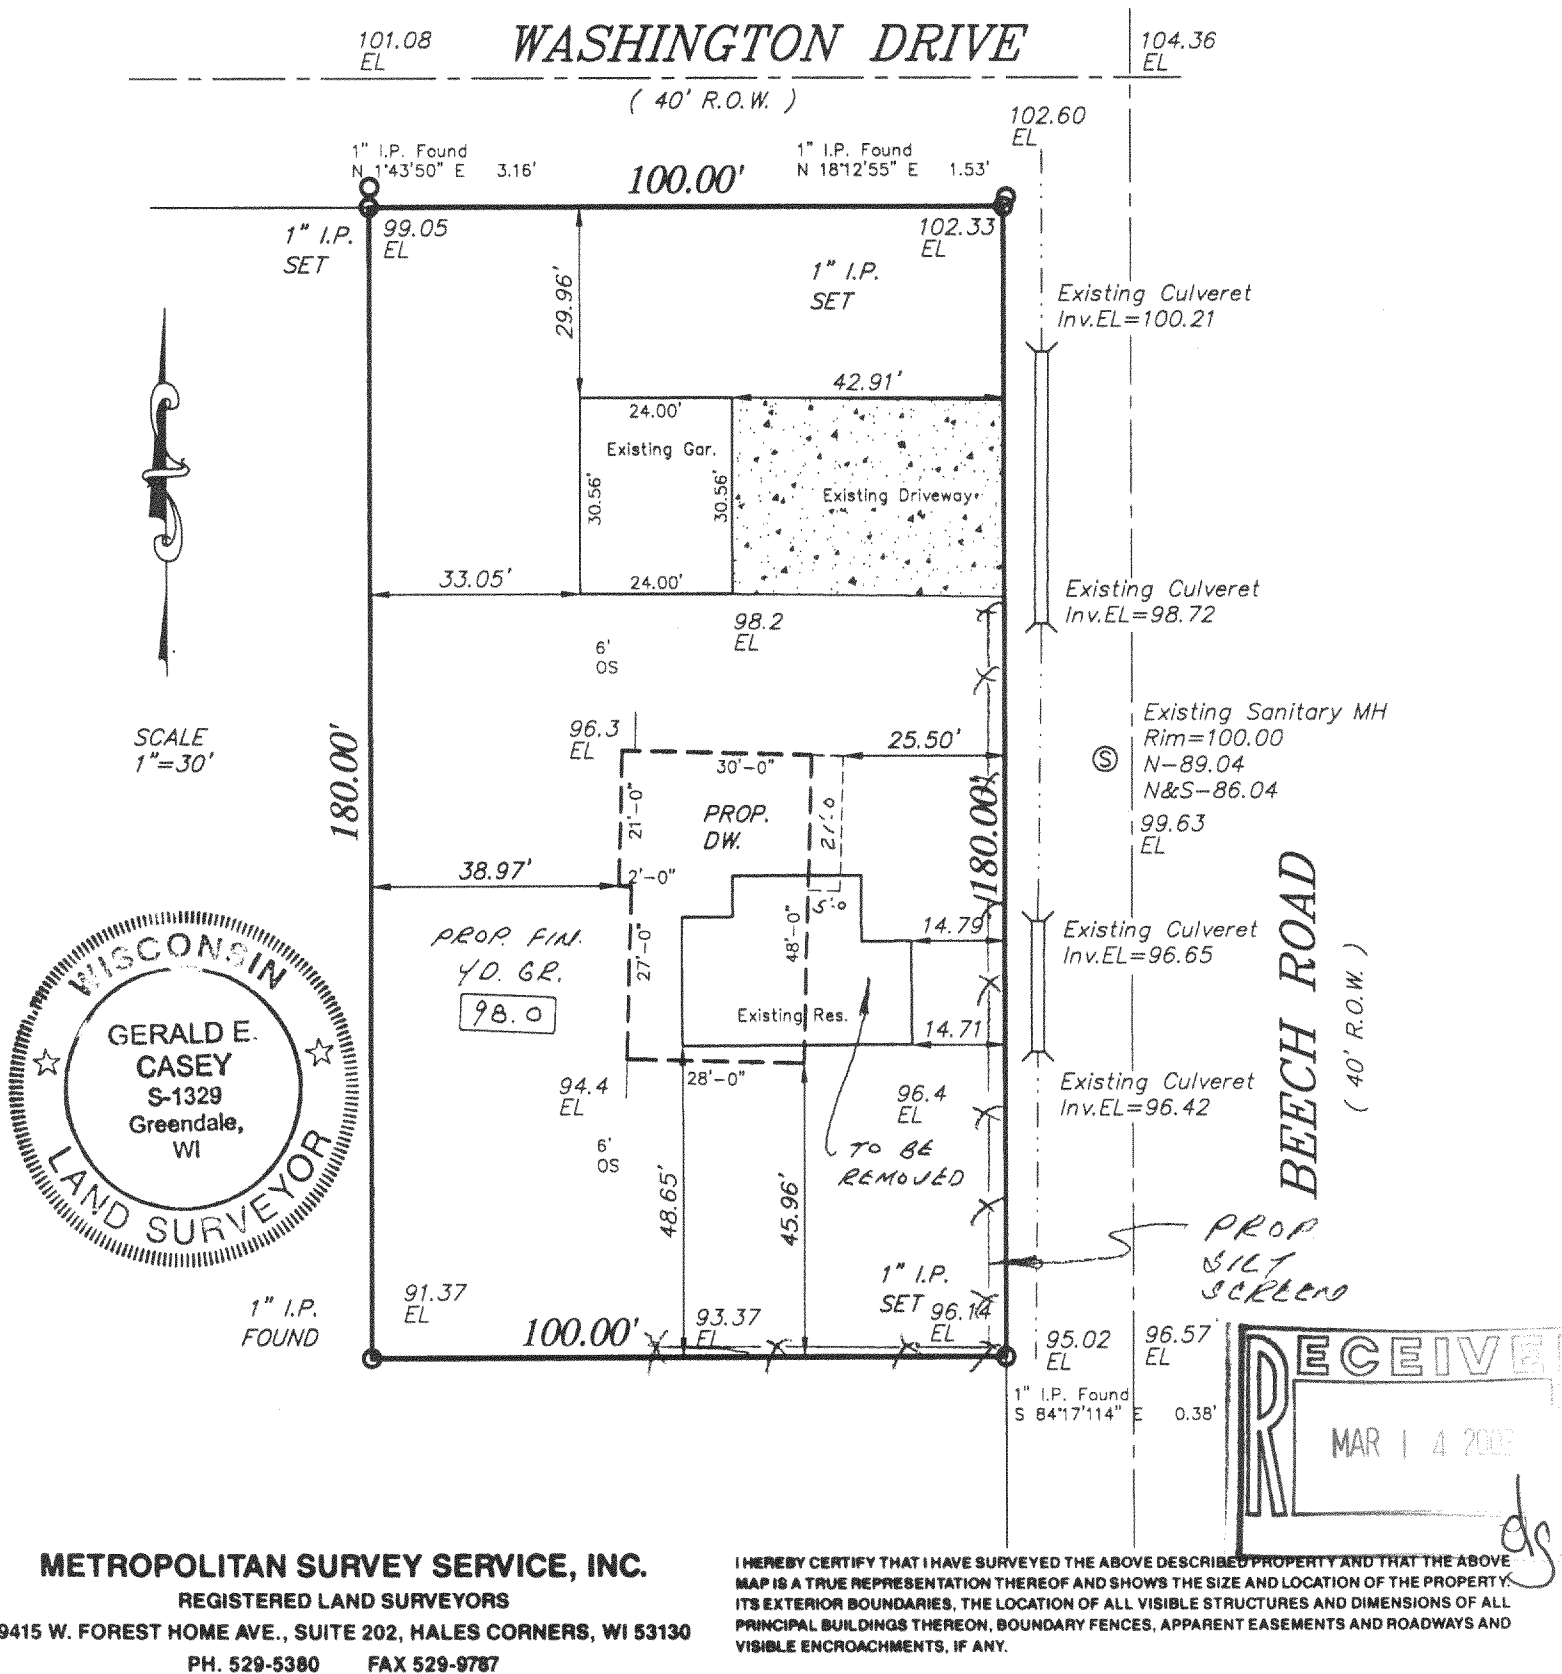

217-2253
JLCB-18621