


ABELL
SURVEYING & MAPPING

1140 SEQUOIA STREET • DELAVAN, WISCONSIN 53115
262-728-6737

LOT 1

NO. 2166

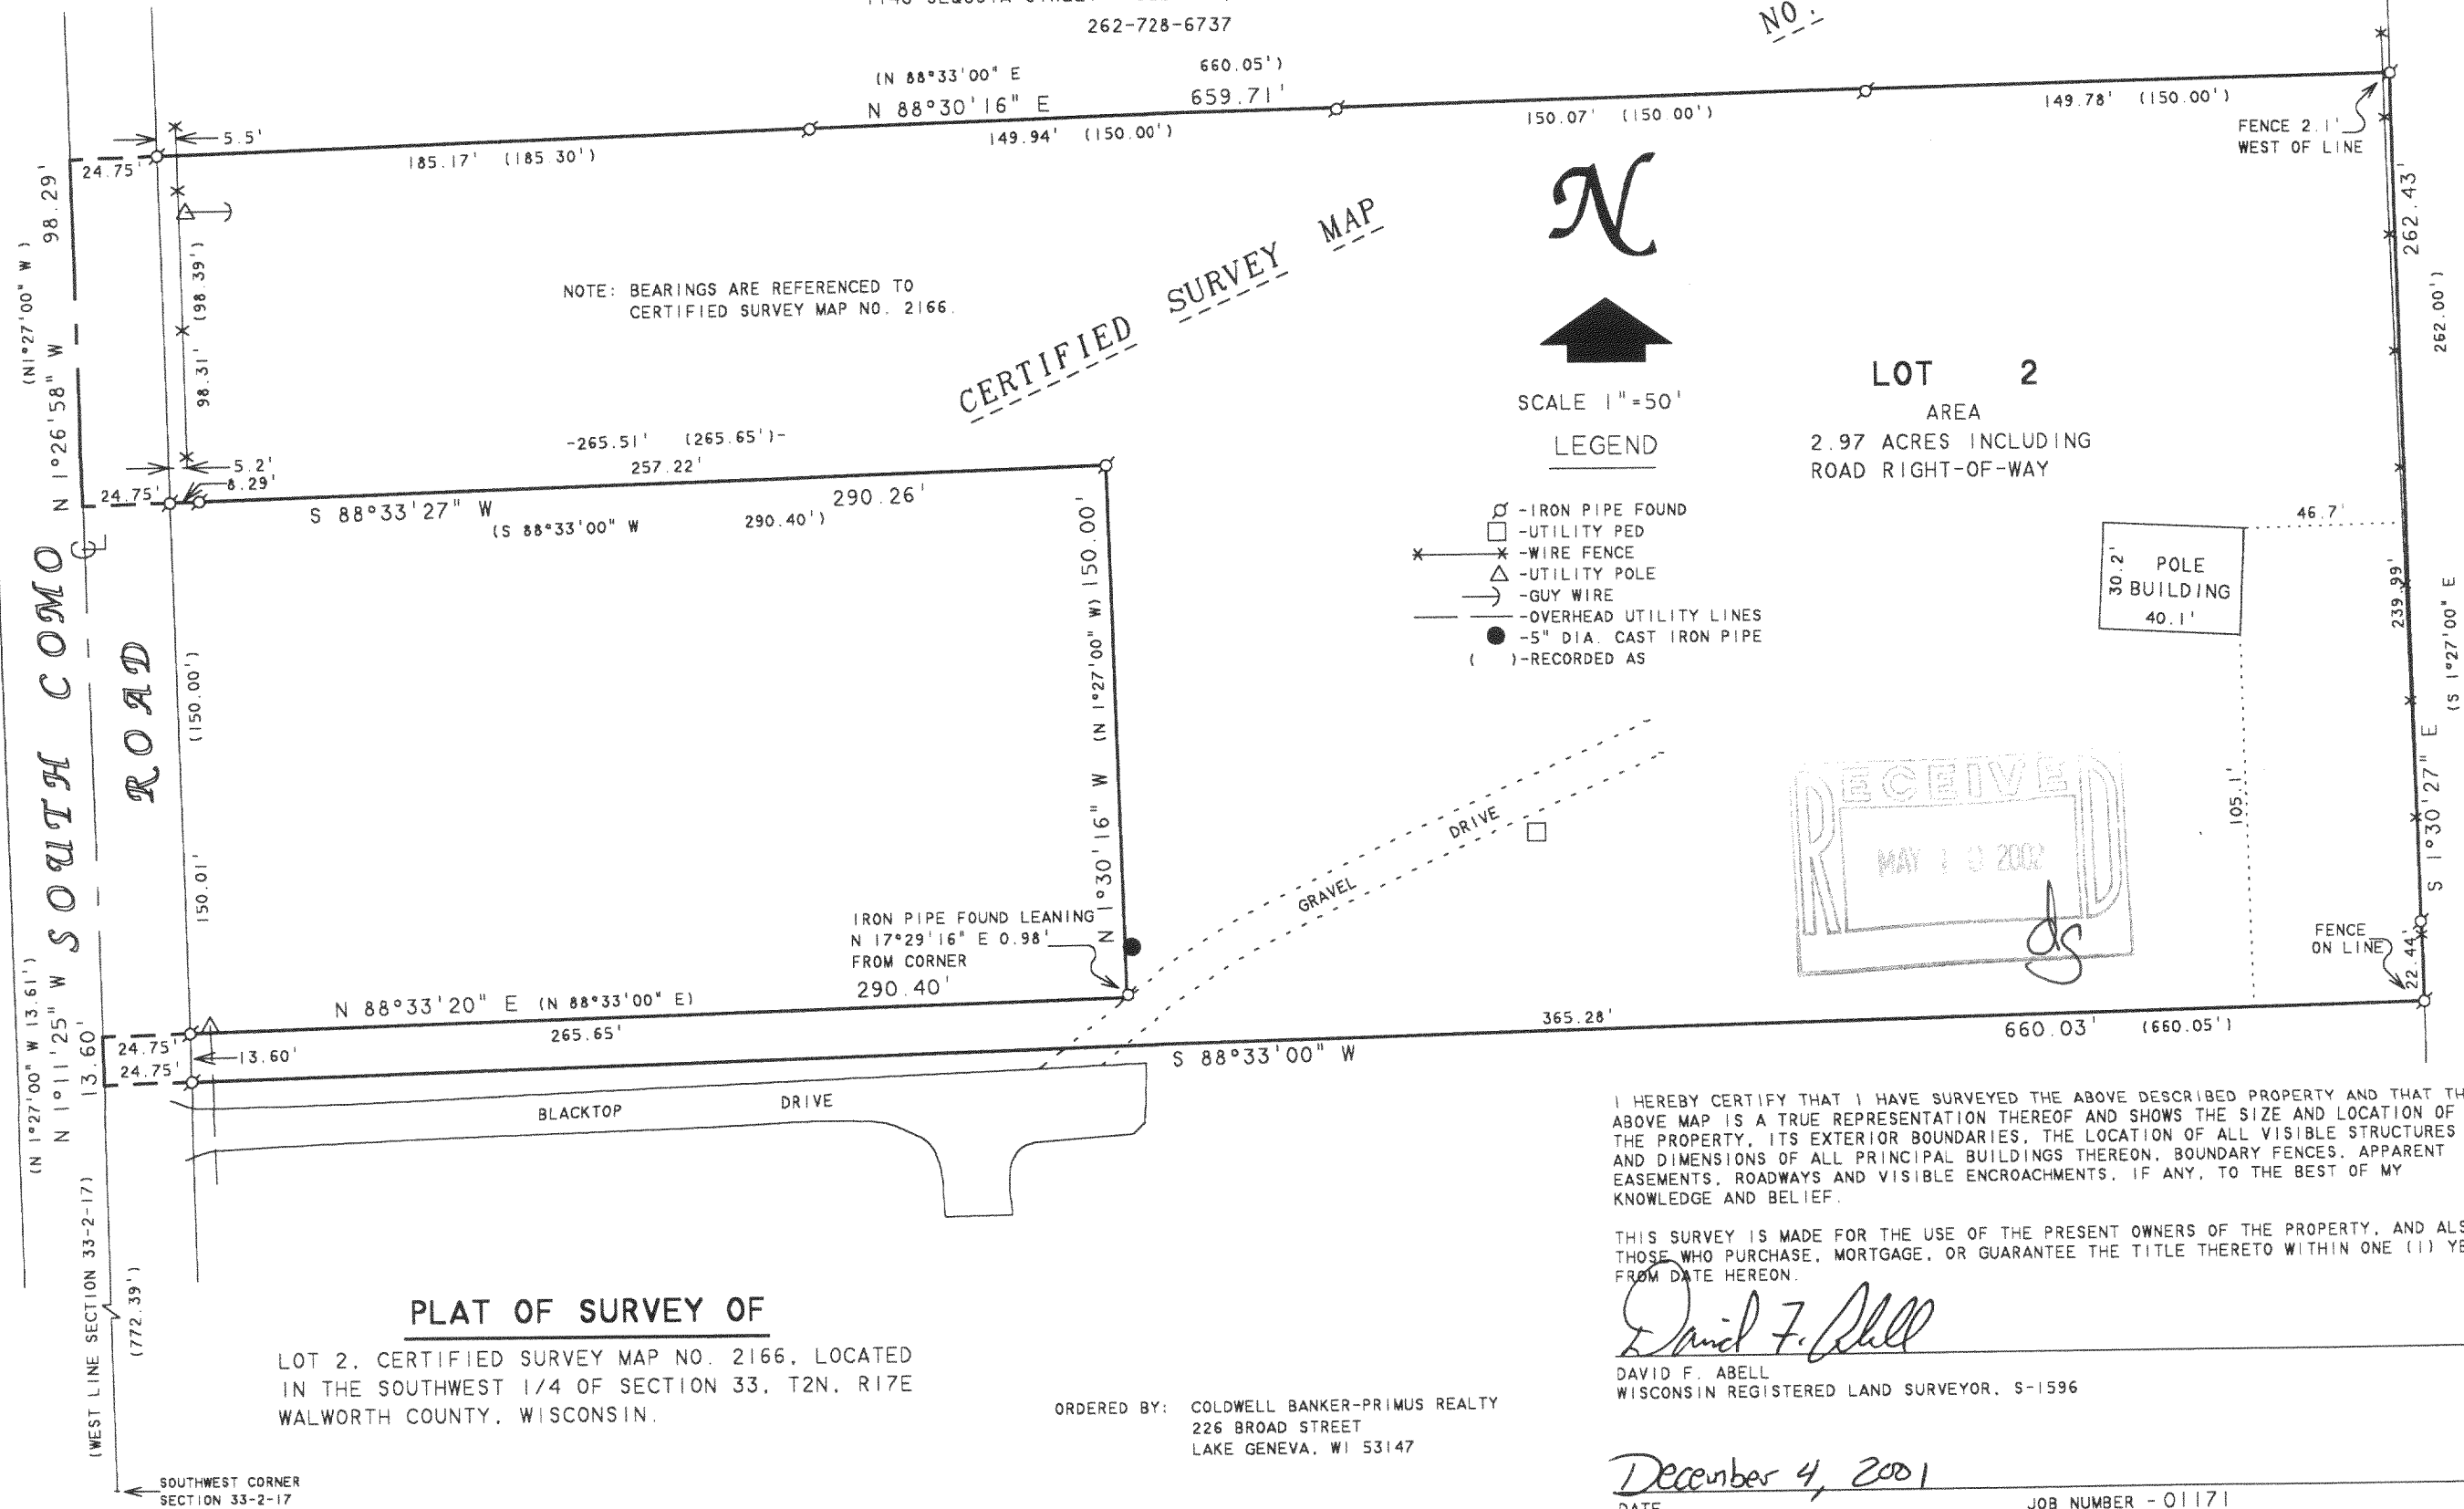

NOTE: BEARINGS ARE REFERENCED TO
CERTIFIED SURVEY MAP NO. 2166.

CERTIFIED SURVEY MAP

N

SCALE 1"=50'

LEGEND

- -IRON PIPE FOUND
- -UTILITY PED
- ✕ -WIRE FENCE
- △ -UTILITY POLE
- -GUY WIRE
- -OVERHEAD UTILITY LINES
- -5" DIA. CAST IRON PIPE
- () -RECORDED AS

LOT 2

AREA
2.97 ACRES INCLUDING
ROAD RIGHT-OF-WAY

POLE
BUILDING
40.1'

RECEIVED
MAY 10 2002

PLAT OF SURVEY OF

LOT 2, CERTIFIED SURVEY MAP NO. 2166, LOCATED
IN THE SOUTHWEST 1/4 OF SECTION 33, T2N, R17E
WALWORTH COUNTY, WISCONSIN.

ORDERED BY: COLDWELL BANKER-PRIMUS REALTY
226 BROAD STREET
LAKE GENEVA, WI 53147

I HEREBY CERTIFY THAT I HAVE SURVEYED THE ABOVE DESCRIBED PROPERTY AND THAT THE
ABOVE MAP IS A TRUE REPRESENTATION THEREOF AND SHOWS THE SIZE AND LOCATION OF
THE PROPERTY, ITS EXTERIOR BOUNDARIES, THE LOCATION OF ALL VISIBLE STRUCTURES
AND DIMENSIONS OF ALL PRINCIPAL BUILDINGS THEREON, BOUNDARY FENCES, APPARENT
EASEMENTS, ROADWAYS AND VISIBLE ENCROACHMENTS, IF ANY, TO THE BEST OF MY
KNOWLEDGE AND BELIEF.

THIS SURVEY IS MADE FOR THE USE OF THE PRESENT OWNERS OF THE PROPERTY, AND ALSO
THOSE WHO PURCHASE, MORTGAGE, OR GUARANTEE THE TITLE THERETO WITHIN ONE (1) YEAR
FROM DATE HEREON.

David F. Abell

DAVID F. ABELL
WISCONSIN REGISTERED LAND SURVEYOR, S-1596

December 4, 2001

DATE
NOTE: THIS IS NOT A CERTIFIED COPY UNLESS SEALED.

JOB NUMBER - 01171

217-2271

JA-2166-2