


Plat of Survey

of

Lot 5 of Lost Creek Estates,

a subdivision located in the Northeast 1/4 of Section 12,
Town 2 North, Range 17 East, Town of Geneva, Walworth
County, Wisconsin.

Surveyed for: **Steve & Kim Prince**
W894 Miramar Road
East Troy, Wisconsin 53120

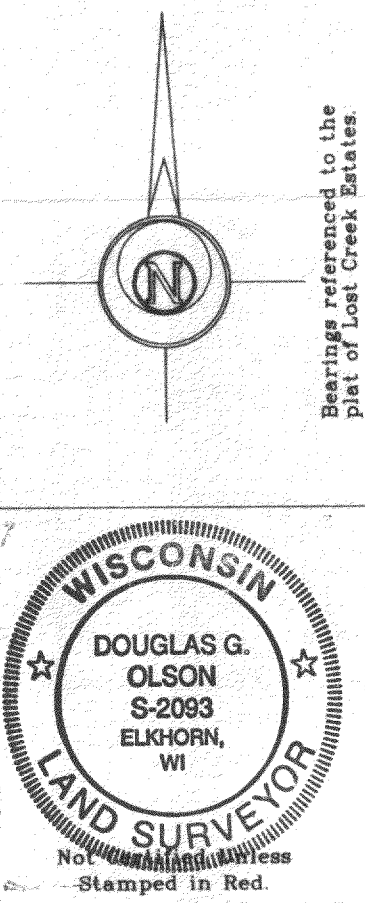

Lot 1
Certified Survey
Map No. 2523

Notes: 1) This survey plat is not
certified unless signed
and sealed in red ink.


2) This survey is subject to Wisconsin lien laws.
This Plat of Survey is the notice of intent
to file lien. Lien waiver required.

Copyright © 2001 by Jensen & Olson Land Surveying, LLC.

All rights reserved. No part of this survey plat may be reproduced
or transmitted in any form by any means - graphic, electronic, or
mechanical, including photocopying, tracing, or information storage
and retrieval systems - without permission in writing from Douglas
G. Olson, Jensen & Olson Land Surveying, LLC.

I, Douglas G. Olson, Wisconsin Registered Land Surveyor,
do hereby certify that this survey was performed by me or under my
direction in full compliance with the owner's/agent's instructions
and Chapter A-E 7 of the Wisconsin Administrative Code "Minimum
Standards for Property Surveys", and that this map is an accurate
representation thereof to the best of my knowledge and belief.

Douglas G. Olson
Wisconsin Registered Land Surveyor - 2093

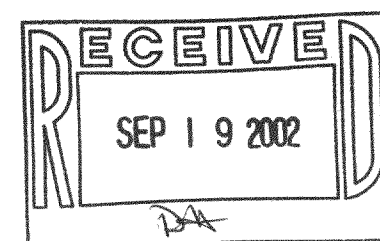

Drive

N2°15'00"W

(66' Wide)

183.05'

Arc=183.05'

263.28'

Arc=264.00'

263.06'

Radius=1033.00'

105.14'

131.3'

314.86'

S 72°39'48" E

(S 72°28'20" E)

±669.69'

161.59'

±88.1'

Hospital Road

(66' Wide)

N 89°57'10" E 2662.91'

N89°57'10"E ±503.0'

421.00'

±35.0'

Vision Corner
As shown on the plat
of Lost Creek Estates.

Approximate location of buried line

Well

House
Under
Construction

40.4'

75.1'

40.5'

55.7'

Utility Box

Utility Pedestal

Centerline of Creek

As digitized from the plat
of Lost Creek Estates.

Tax Parcel
JG 1200001

Survey Date: 10-19-00
Revisions: No. 1 - Proposed House
No. 2 - 1' Contours
No. 3 - House Revisions
No. 4 - House & Drive
No. 5 - Foundation

Scale in Feet
1" = 50'



Jensen & Olson Land Surveying, LLC
45 South Wisconsin Street
Elkhorn, Wisconsin 53121
Telephone (262) 723-3434
Facsimile (262) 723-8044

Legend
Found County Section Corner
Found Iron Pipe
Found Iron Rod
Recorded Information
PVC Pipe
Asphalt Surface

Sheet 1 of 1 Sheets
Job Reference Number
2001.060

2001.060