

JA3383-1

Tax Parcel
JG 1100001

S89°58'45"E 290.00'

Plat of Survey

of

Lot 1 of Certified Survey Map No. 3383,

recorded in Vol. 19 of Certified Survey Maps of Walworth County on
Page 187 and located in the Southeast 1/4 of the Northwest 1/4 of
Section 11, Town 2 North, Range 17 East, Town of Geneva, Walworth
County, Wisconsin.



Surveyed for: **Five Lakes Builders**
P.O. Box 105
Evansville, Wisconsin. 53536

Tax Parcel
JG 1100001

Lot 1
2.662 Acres
115,958 Sq.Ft.
2.442 Acres
106,391 Sq.Ft.
Exclusive of R.O.W.

**Poured
Concrete
Foundation**
W3186

Bearings reference to the Wisconsin State
Plane Coordinate System, South Zone.

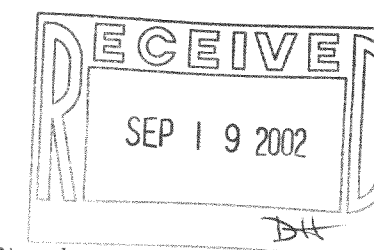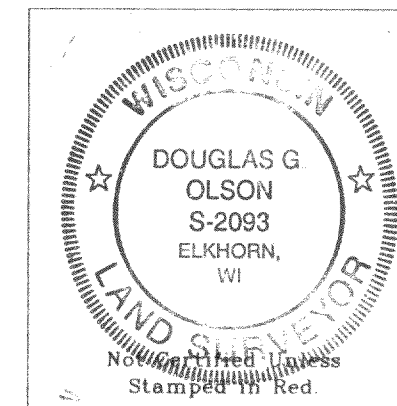

- Notes: 1) This survey plat is not certified unless signed and sealed in red ink.
- 2) This survey is subject to Wisconsin lien laws. This Plat of Survey is the notice of intent to file lien. Lien waiver required.

Copyright © 2001 by Jensen & Olson Land Surveying, LLC.

All rights reserved. No part of this survey plat may be reproduced or transmitted in any form by any means - graphic, electronic, or mechanical, including photocopying, tracing, or information storage and retrieval systems - without permission in writing from Douglas G. Olson, Jensen & Olson Land Surveying, LLC.

I, Douglas G. Olson, Wisconsin Registered Land Surveyor, do hereby certify that this survey was performed by me or under my direction in full compliance with the owner's/agent's instructions and Chapter A-E 7 of the Wisconsin Administrative Code "Minimum Standards for Property Surveys"; and that this map is an accurate representation thereof to the best of my knowledge and belief.

Douglas G. Olson
Wisconsin Registered Land Surveyor - 2093

Survey Date: December 5, 2001.
Revisions: No. 1 - Revised Legal

Scale in Feet
1" = 30'



Jensen & Olson Land Surveying, LLC

45 South Wisconsin Street
Elkhorn, Wisconsin. 53121
Telephone (262) 723-3434
Facsimile (262) 723-8044

Legend
Found County Section Corner
Found Iron Pipe
Found Iron Rod
Found Nail
Records Information
Gravel Surface
Asphalt Surface
No Access

Sheet 1 of 1 Sheets
Job Reference Number
2001.173

2001.173

217-2392