
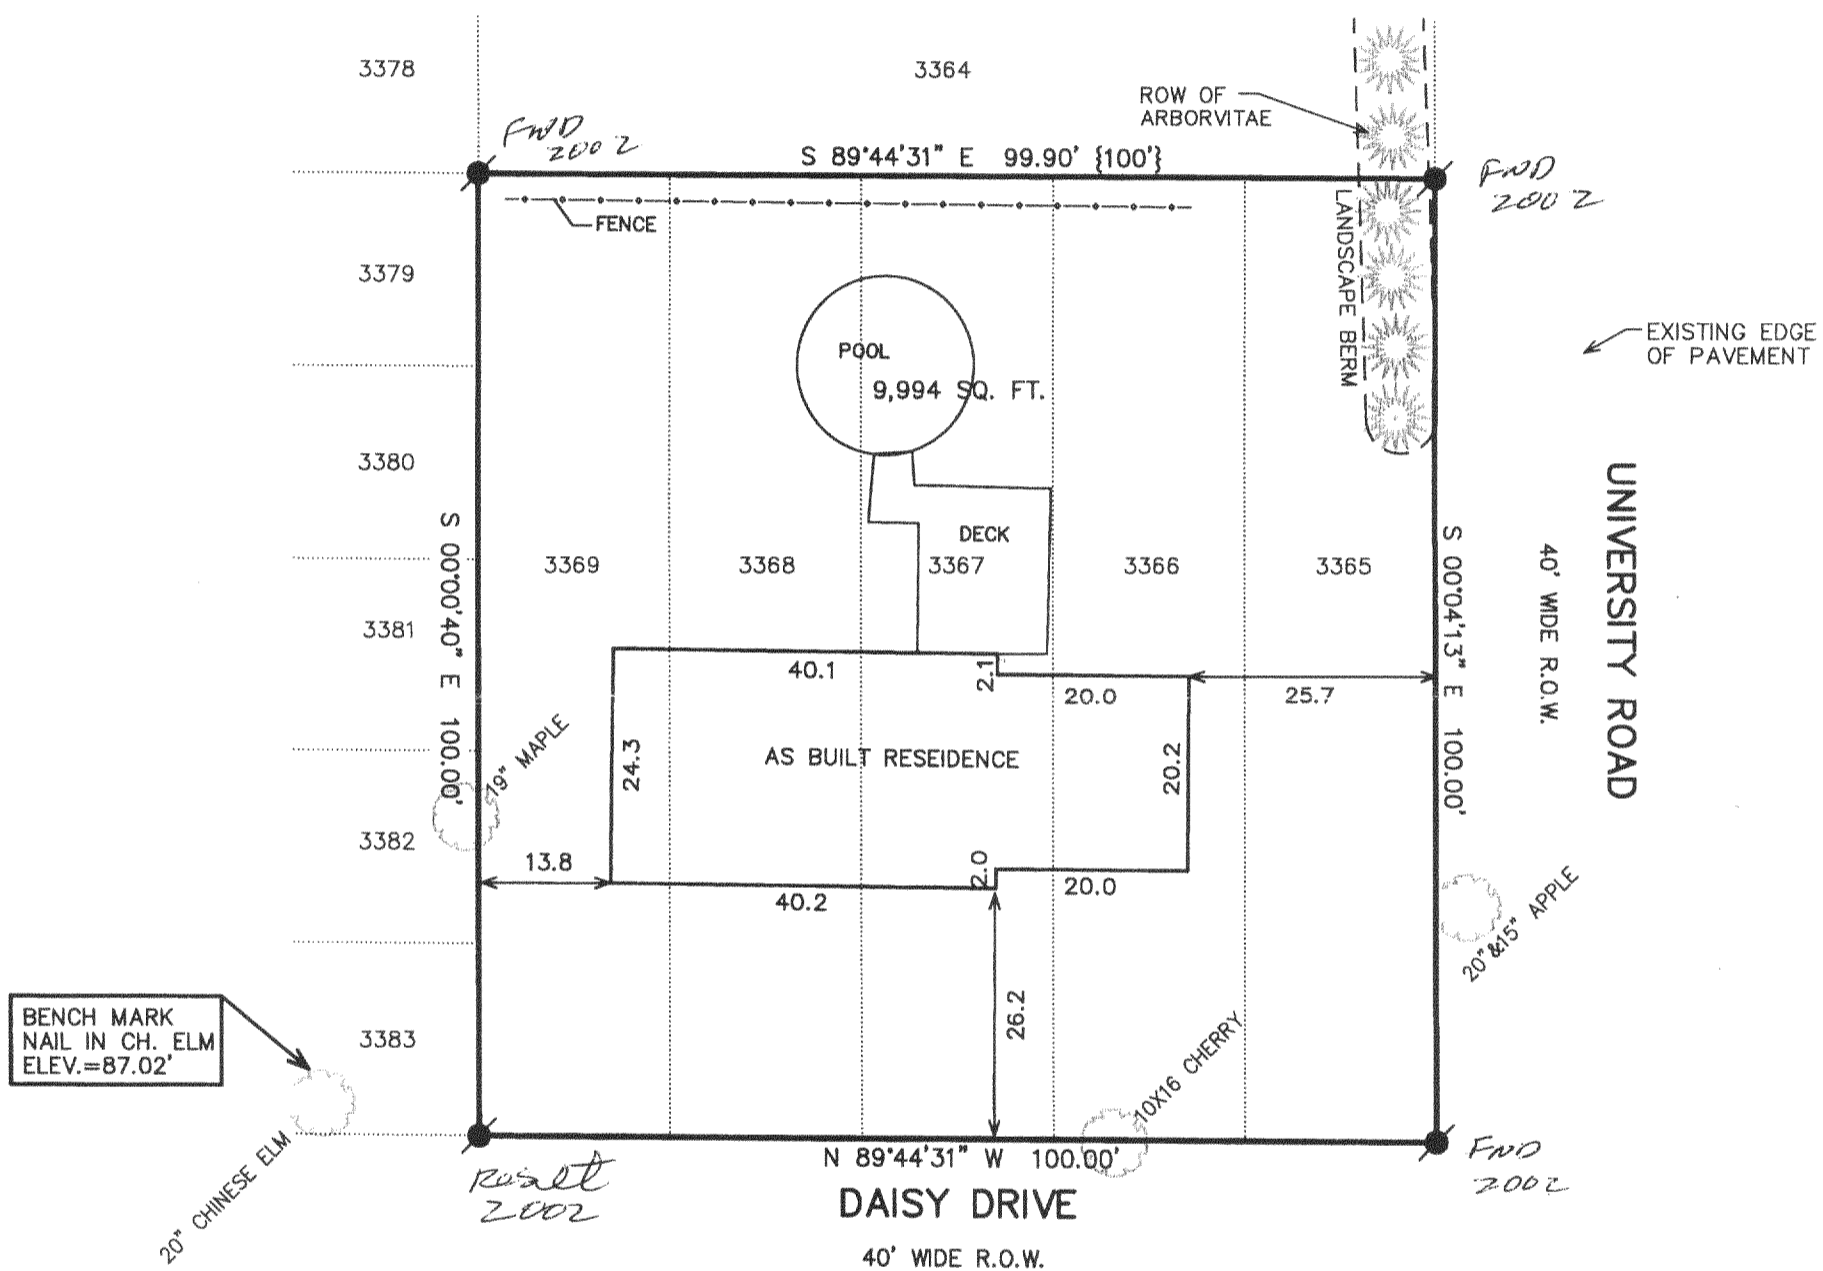


ENGINEERING — ARCHITECTURE — SURVEYING  
7 RIDGWAY COURT — P.O. BOX 437 — ELKHORN, WISCONSIN 53121  
PHONE: (262) 723-2098 FAX: (262) 723-5886

LOTS 3365 THRU 3369 OF BLOCK 59  
OF LAKE COMO BEACH


- WORK ORDERED BY -  
TRACY SEAYER  
39 WELLINGTON COURT  
BROOKLYN, N.Y.

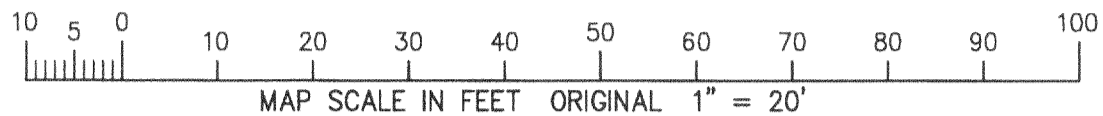

● = SET IRON REBAR STAKE, " DIA.  
{XXX} = RECORDED AS

I HEREBY CERTIFY THAT THE ABOVE DESCRIBED PROPERTY HAS BEEN SURVEYED UNDER MY DIRECTION AND THAT THE ABOVE MAP IS A TRUE REPRESENTATION THEREOF AND SHOWS THE SIZE AND LOCATION OF THE PROPERTY AND ITS EXTERIOR BOUNDARIES. THIS SURVEY IS MADE FOR THE USE OF THE PRESENT OWNERS OF THE PROPERTY, AND ALSO THOSE WHO PURCHASE, MORTGAGE, OR GUARANTEE THE TITLE THERETO WITHIN ONE YEAR FROM THE DATE HEREOF.

  
PETER S. GORDON R.L.S. 2101

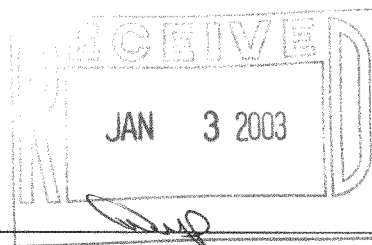

PROJECT: 4706  
DATE: 01/26/2000  
SHEET 1 OF 1

566B-622

217-2465