


-OF-

SURVEY FOR: CHRIS GEIKEN

Franklin J. Lehman
FRANKLIN J. LEHMAN S-2211

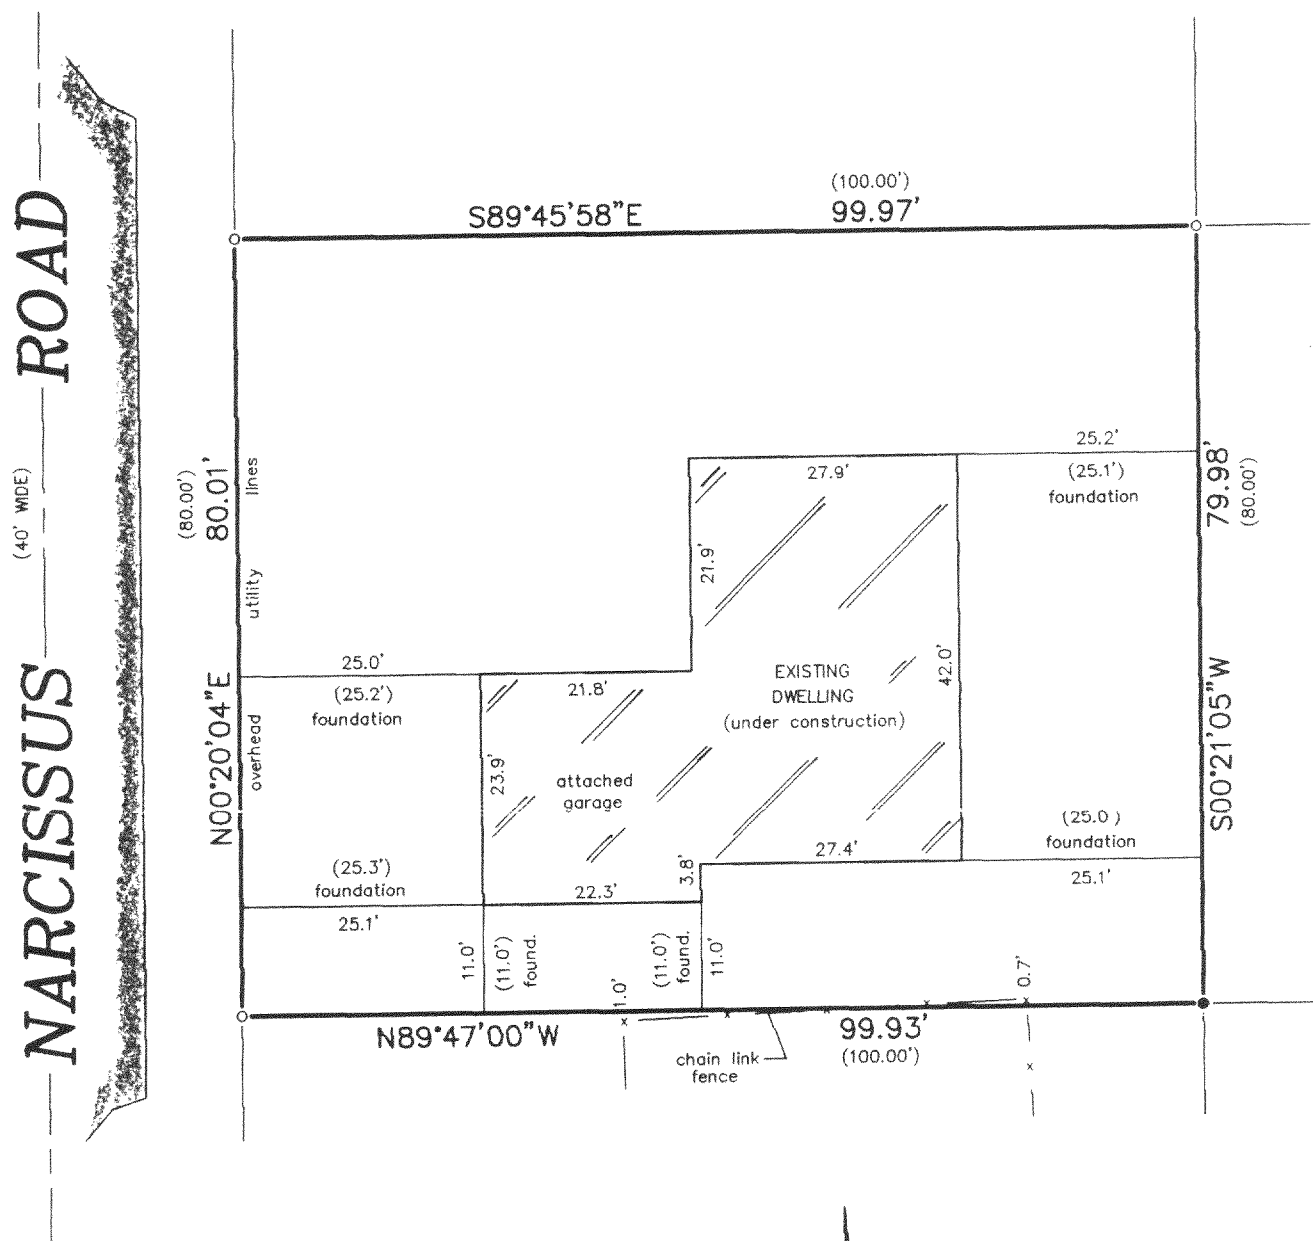


LEGEND


- FOUND IRON PIPE
● FOUND IRON ROD

"This survey is made for the use of the present owners of the property, and those who purchase, mortgage, or guarantee the title thereto within one year from date hereof."

LAND SURVEYS
MAPPING AND PLANNING
412 N. PINE STREET
BURLINGTON, WI 53105
(262)-767-0225

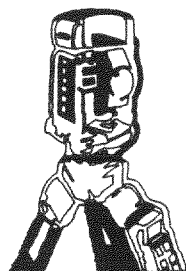

SCALE:
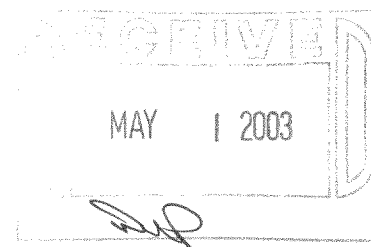
$$1'' = 20'$$


THIS IS NOT AN ORIGINAL PRINT
UNLESS THIS SEAL IS RED.

Franklin J. Lehman
FRANKLIN J. LEHMAN S-2211

JANUARY 13, 2002
DATE

5709
JOB NUMBER

JLCB-204

217-2536