PLAT OF SURVEY


LOCATION:


Iris Road, Geneva, Wisconsin

LEGAL DESCRIPTION: LEGAL DESCRIPTION: Lots 5857, 5858, 5859, 5860, 5861 and West 4.50 feet of Lot 5862, in Block 103, in FOURTH MAP OF LAKE COMO BEACH, being a part of the Southeast 1/4 of Section 21, Town 2 North, Range 17 East, in the Town of Geneva, Walworth County, Wisconsin.

October 11, 2002

Survey No. 95264

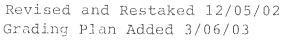

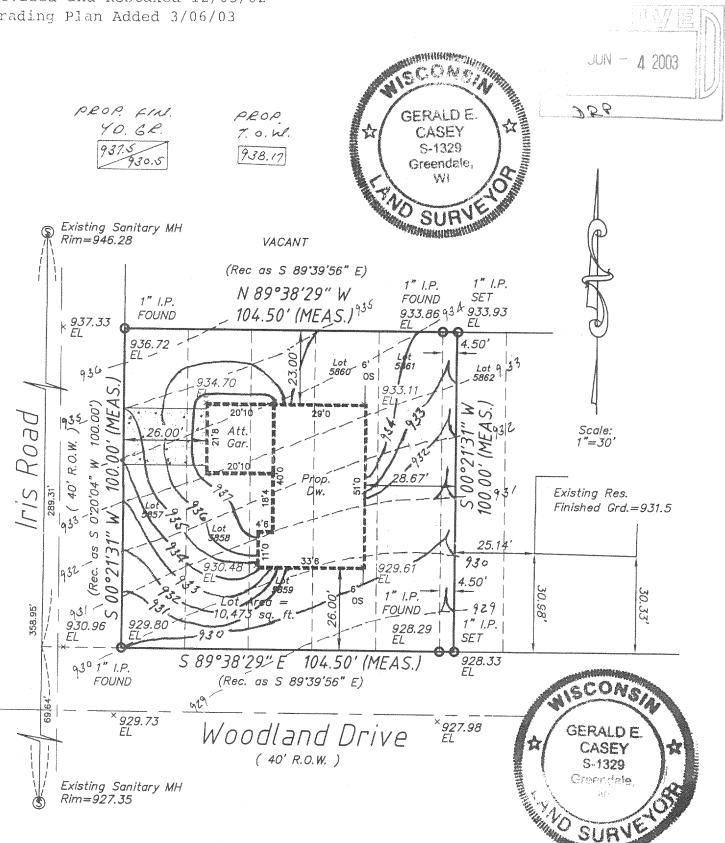

METROPOLITAN SURVEY SERVICE, INC.

REGISTERED LAND SURVEYORS 5200 W. LOOMIS RD. • GREENDALE, WI 53129 PH. 529-5380 FAX 529-9787

Proposed finished yard, 1st floor or top of foundation grade shown on this drawing is a suggested grade and should be verified by the owner and/or the builder.

I HEREBY CERTIFY THAT I HAVE SURVEYED THE ABOVE DESCRIBED PROPERTY AND THAT THE ABOVE MAP IS A TRUE REPRESENTATION THEREOF AND SHOWS THE SIZE AND LOCATION OF THE PROPERTY, ITS EXTERIOR BOUNDARIES, THE LOCATION OF ALL VISIBLE STRUCTURES AND DIMENSIONS OF ALL PRINCIPAL BUILDINGS THEREON, BOUNDARY FENCES, APPARENT EASEMENTS AND ROADWAYS AND VISIBLE ENCROACHMENTS, IF ANY.

THIS SURVEY IS MADE FOR THE EXCLUSIVE USE OF THE PRESENT OWNERS OF THE PROPERTY, AND ALSO THOSE WHO PURCHASE, MORTGAGE, OR GUARANTEE THE TITLE THERETO WITHIN ONE (1) YEAR FROM DATE HEREOF.

SIGNED ___

Gerald E. Casey Registered Land Surveyor S-1329

217-2562

1 JLCB-1199A