


PLAT OF SURVEY

LOT 1 AND OUTLOT 2

CERTIFIED SURVEY MAP 3423

LOCATED IN THE SE 1/4 OF SECTION 28,
TOWN 2 NORTH, RANGE 17 EAST,
WALWORTH COUNTY, WISCONSIN

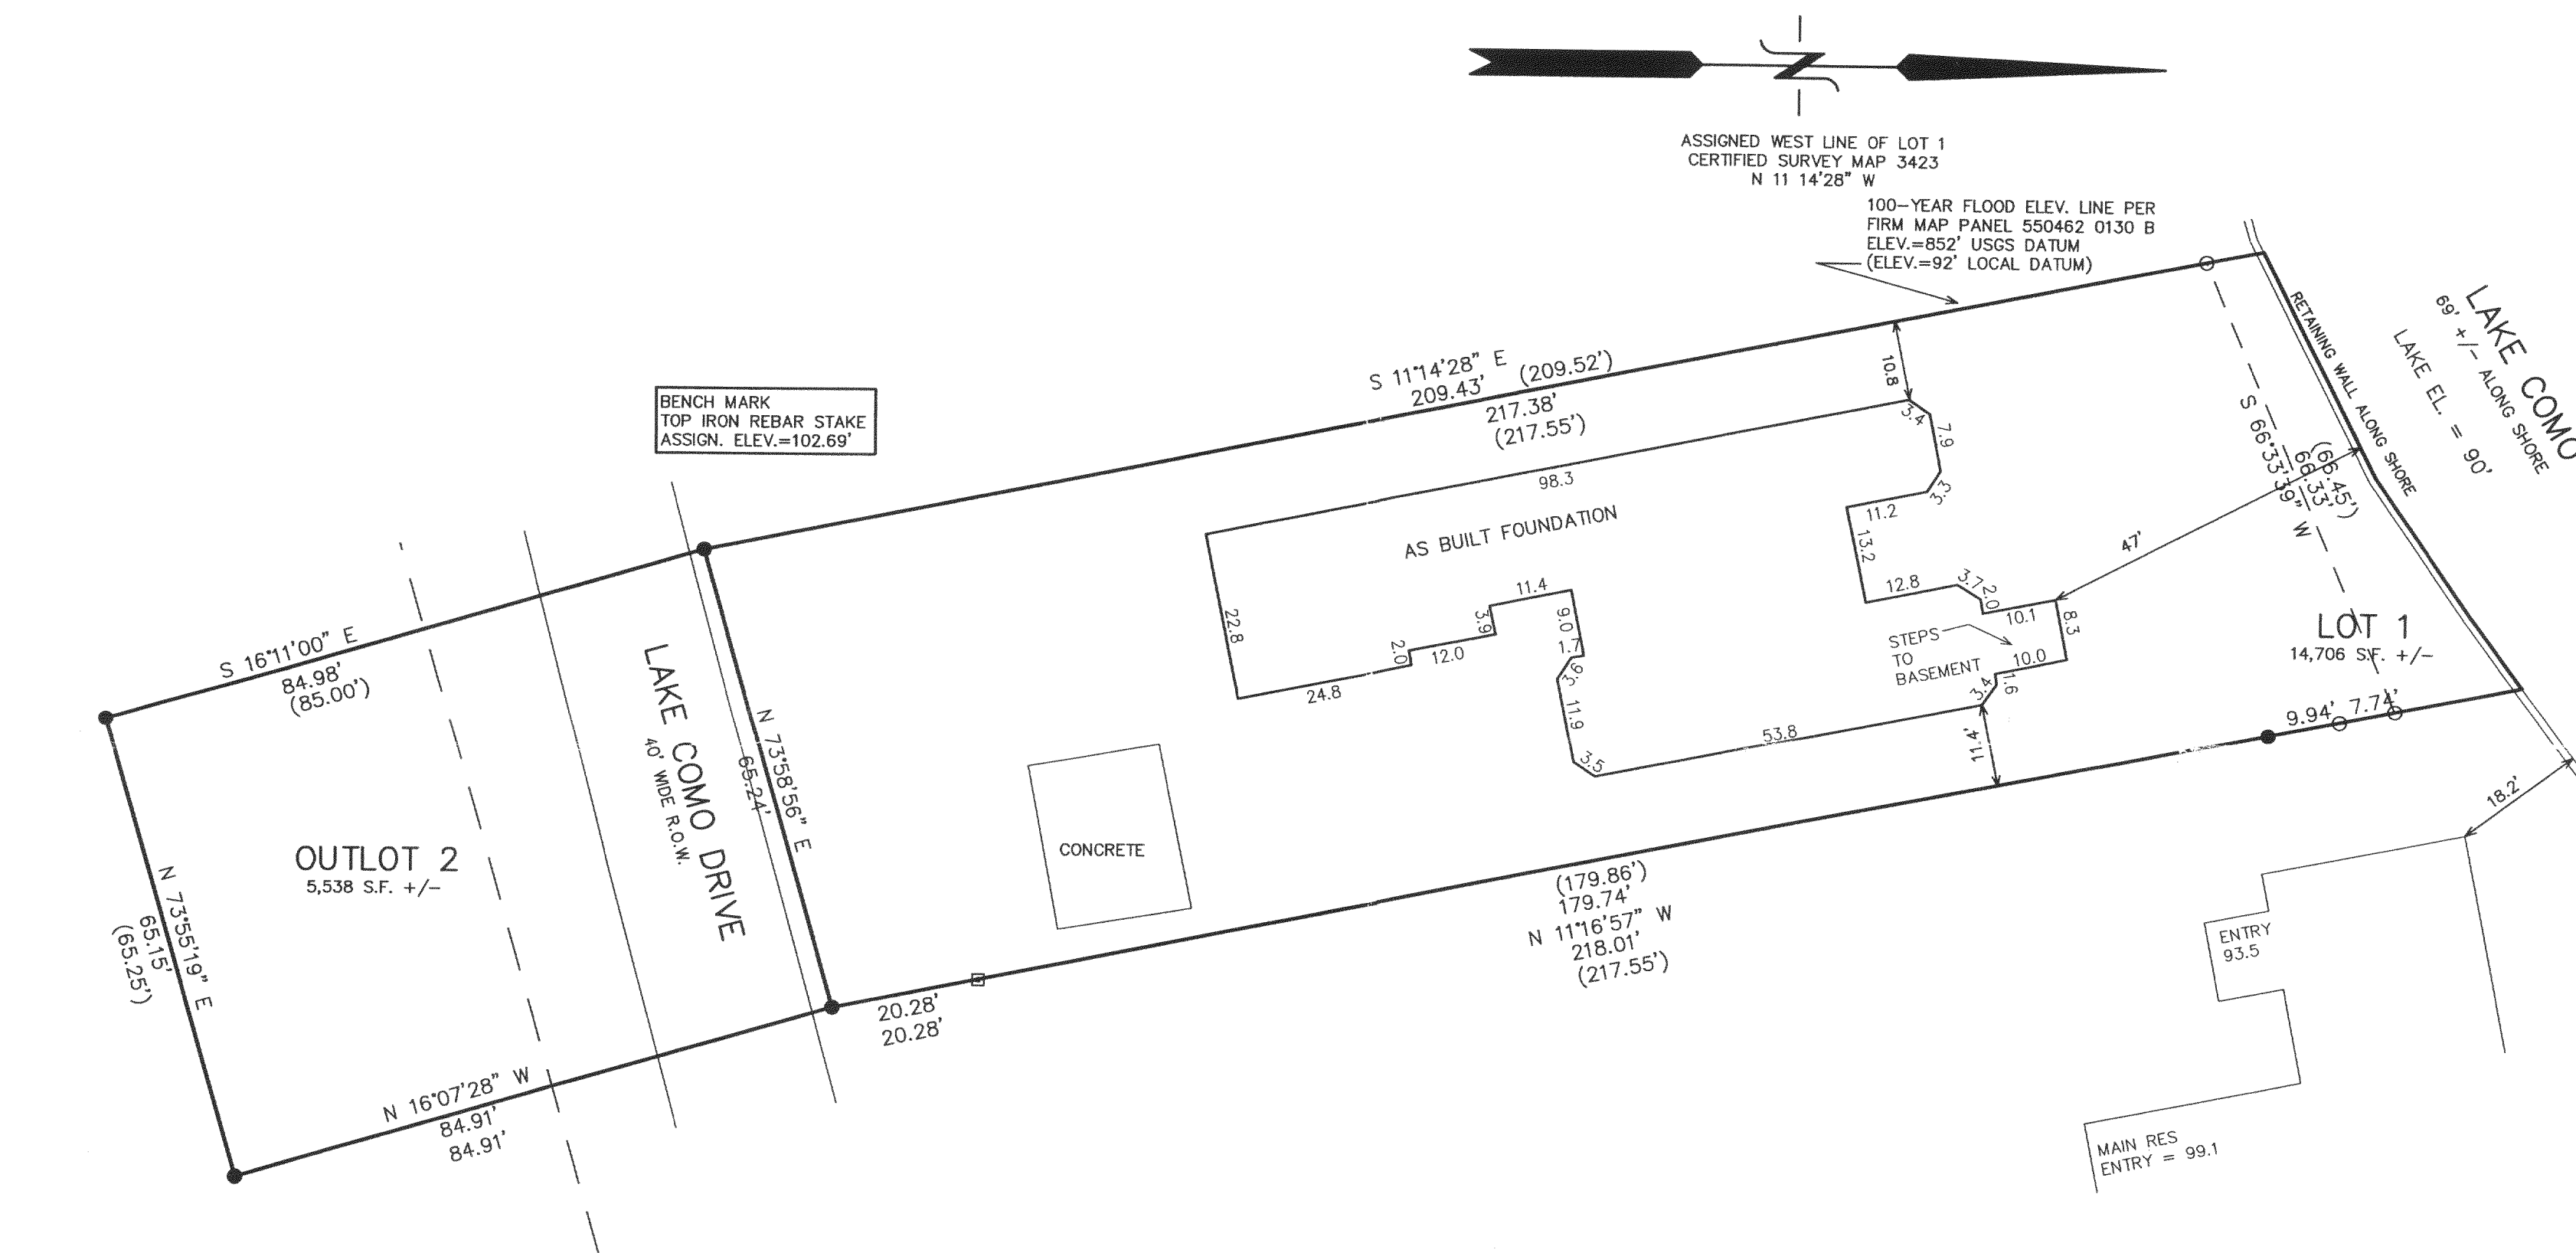

— WORK ORDERED BY —
ROB HOEVAR
TECH 2 BUILDERS, INC.
565 NORTH WOLF
WHEELING, IL 60090

FARRIS, HANSEN & ASSOCIATES, INC.
ENGINEERING — ARCHITECTURE — SURVEYING
7 RIDGWAY COURT P.O. BOX 437
ELKHORN, WISCONSIN 53121
OFFICE: (262) 723-2098 FAX: (262) 723-5886

REVISIONS

PROJECT NO.
6171

DATE:
12/10/02

SHEET NO.
1 OF 1

JA3423-1
JA3423-3

217-2576