



LOTS 4236, 4237, 4238, 4239 and 4240 OF BLOCK 73, OF LAKE COMO BEACH 2ND MAP SUBDIVISION, located in the Southwest ¼ of Section 22, Town 2 North, Range 17 East, Town of Geneva, Walworth County, Wisconsin.

Survey address: W3723 Lakeview Dr.

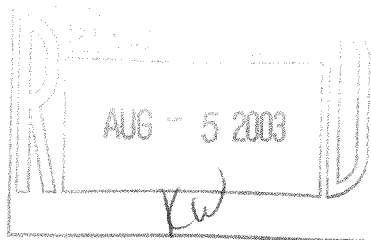

LAKEVIEW ROAD

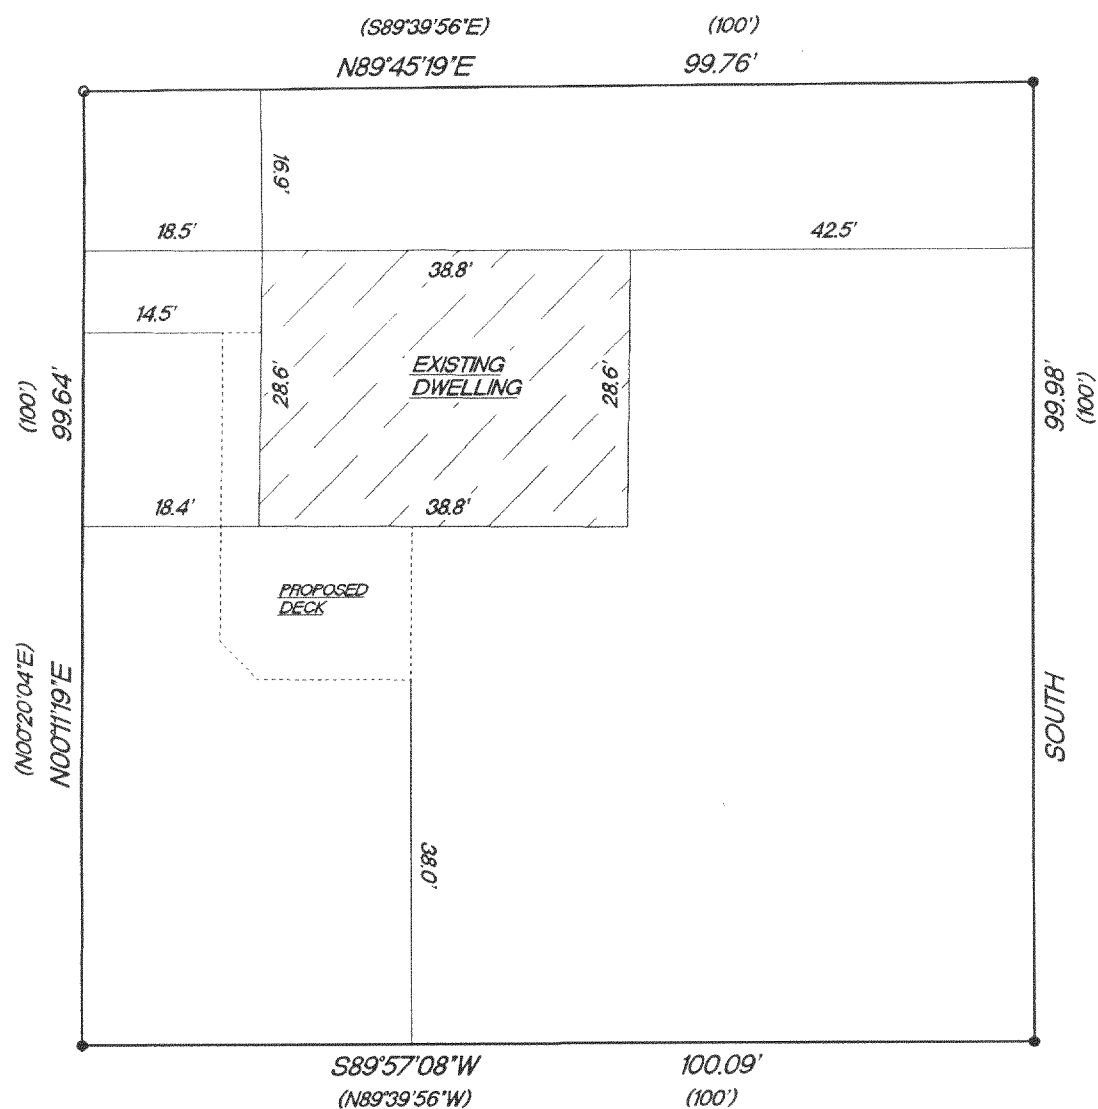


- FOUND 1" IRON PIPE
- FOUND 3/4" IRON PIPE
- () RECORDED AS DIMENSIONS

SCALE 1"=20'

"This survey is made for the use of the present owners of the property, and also those who purchase, mortgage or guarantee the title thereto within one year from date hereof."

Terrance E. Pisarek R.L.S.

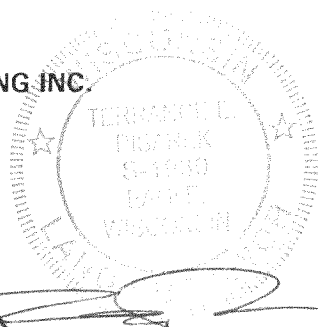

THIS IS NOT AN ORIGINAL SURVEY UNLESS THE SEAL IS RED.

7/9/03

TEP/DW

TEP

03145

DATE _____

FIELD WORK BY

DRAWN BY

JOB NUMBER

JLCB-824

217-2604