


PREPARED FOR :
CAROL & TOM THOMPSON
4122 LONGFELLOW
OR
1145 S MEYERS RD
LOMBARD, IL. 60148

PLAT OF SURVEY



J.K. SURVEYING INC.
N3705 WILLOWBEND LANE
LAKE GENEVA, WI, 53147
262-248-3697

OF
LOTS 11488-11492, BLOCK 207, OF LAKE COMO BEACH
SUBDIVISION, LOCATED IN TOWN 2 NORTH, RANGE 17
EAST, TOWN OF GENEVA, WALWORTH COUNTY, WISCONSIN.

BM
TOP OF
IRON PIPE=100.00

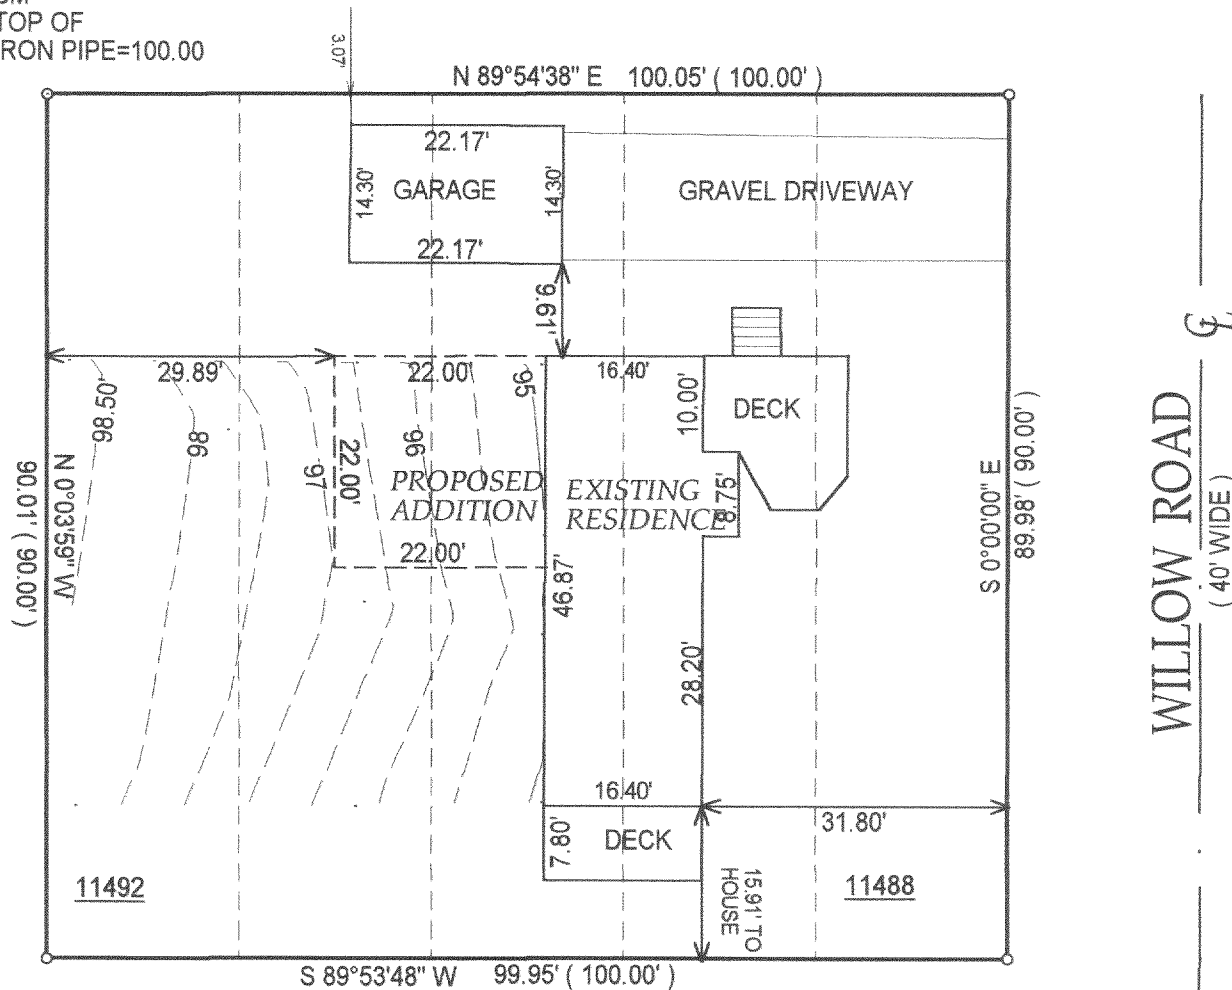

LONGFELLOW DRIVE
(40' WIDE)

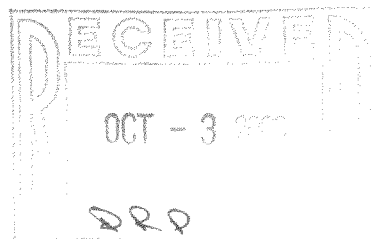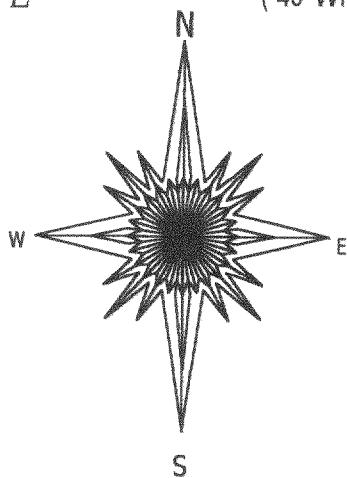


- () = recorded as
- = set iron bar
- = found iron bar
- = found iron pipe
- = set iron pipe

COMPARE LEGAL DESCRIPTION ABOVE AND DRAWING WITH DEED. FOR BUILDING RESTRICTIONS AND EASEMENTS NOT SHOWN, REFER TO DEED, ABSTRACT SOURCES AND LOCAL MUNICIPAL CODES. NOTIFY THE SURVEYOR IMMEDIATELY OF ANY DISCREPANCY.

"I hereby certify that I have surveyed the above described property and that the above map is a true representation thereof and shows the size and location of all visible structures, apparent easements and encroachments if any."

This survey is made for the present owners of the property, and those who purchase, mortgage, or guarantee the title thereto, within one year from the date hereof.

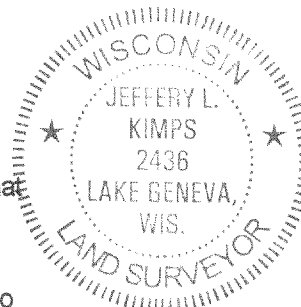

JOB# 03-191

SCALE: 1"=20'

TAX KEY #

JLCB 02497

DATED THIS 28 TH DAY OF APRIL 20 03

JEFFREY L KIMPS S-2436
WISCONSIN REGISTERED LAND SURVEYOR
(ORIGINAL IF SIGNED IN RED)

217-2658