ABERNATHY and ASSOCIATES

Kenneth B. Abernathy Jr.

Wisconsin Registered Land Surveyor

S-1594

W4056 BRAY RD. ELKHORN, WI. 53121

SURVEY

PHONE: (262) 723-4260 (OFFICE) (262) 723-7209 (FAX)

Email: abernathy@elknet.net


PLAT OF

Lots 6727 - 6731 inclusive of Block 115 of Lake Como Beach Subdivision located in Section 28, Town 2 North, Range 17 East, Walworth County, Wisconsin.

Owner: Ron Gazija

367 Kerry Way

Grayslake, II. 60030

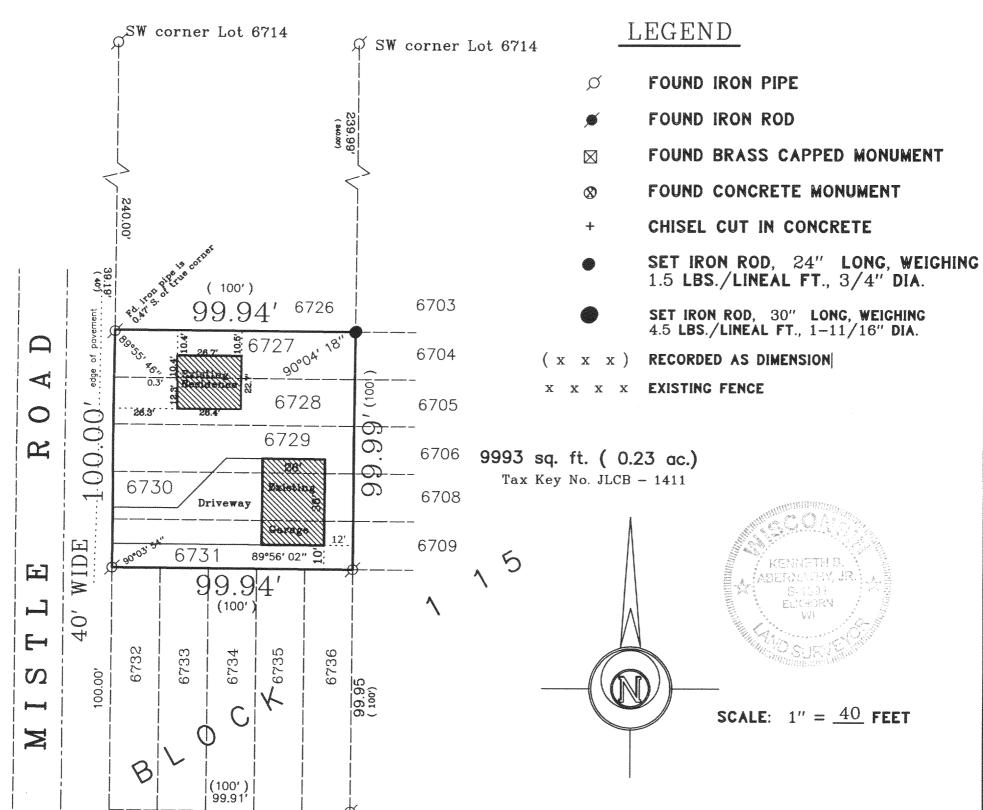

Revised April 22, 2003 Proposed Residence and Garage added.

Revised December 4, 2003 Residence & Garage under construction "As Built" "I hereby certify that the above described property has been surveyed by me or under my direction and that the above map is a true representation thereof and shows the size and location of the property, its exterior boundaries, the location of all visible structures and dimensions of all principal buildings thereon, boundary fences, apparent easements, roadways and visible encroachments, if any."

if any."
"This survey is made for the use of the present owners of the property, and also those who purchase, mortgage, or guarantee the title thereto within one year from the date hereof."

KENNETH B. ABERNATHY, JR. S-1594 WISCONSIN REGISTERED LAND SURVEYOR,

DATED June 12, 2002

Job No. <u>02.601A</u>

SW corner

of Block 115

D06