



PREPARED FOR:
MARK VALLENGO
37999 N NORA PLACE
SPRING GROVE IL
60081

PLAT OF SURVEY

-OF-

J.K. SURVEYING INC.
N3705 WILLOWBEND LANE
LAKE GENEVA, WI, 53147
262-248-3697

LOTS 10187 THRU 10191 AS DESIGNATED AND DELINEATED ON THE MAP
ENTITLED " FIFTH MAP OF LAKE COMO BEACH, WALWORTH COUNTY,
WISCONSIN, " AND RECORDED IN THE OFFICE OF THE REGISTER OF
DEEDS IN AND FOR WALWORTH COUNTY, WISCONSIN ON THE FIRST
DAY OF MAY, 1926.

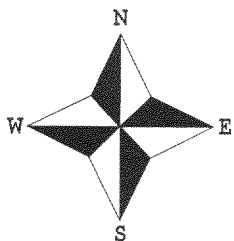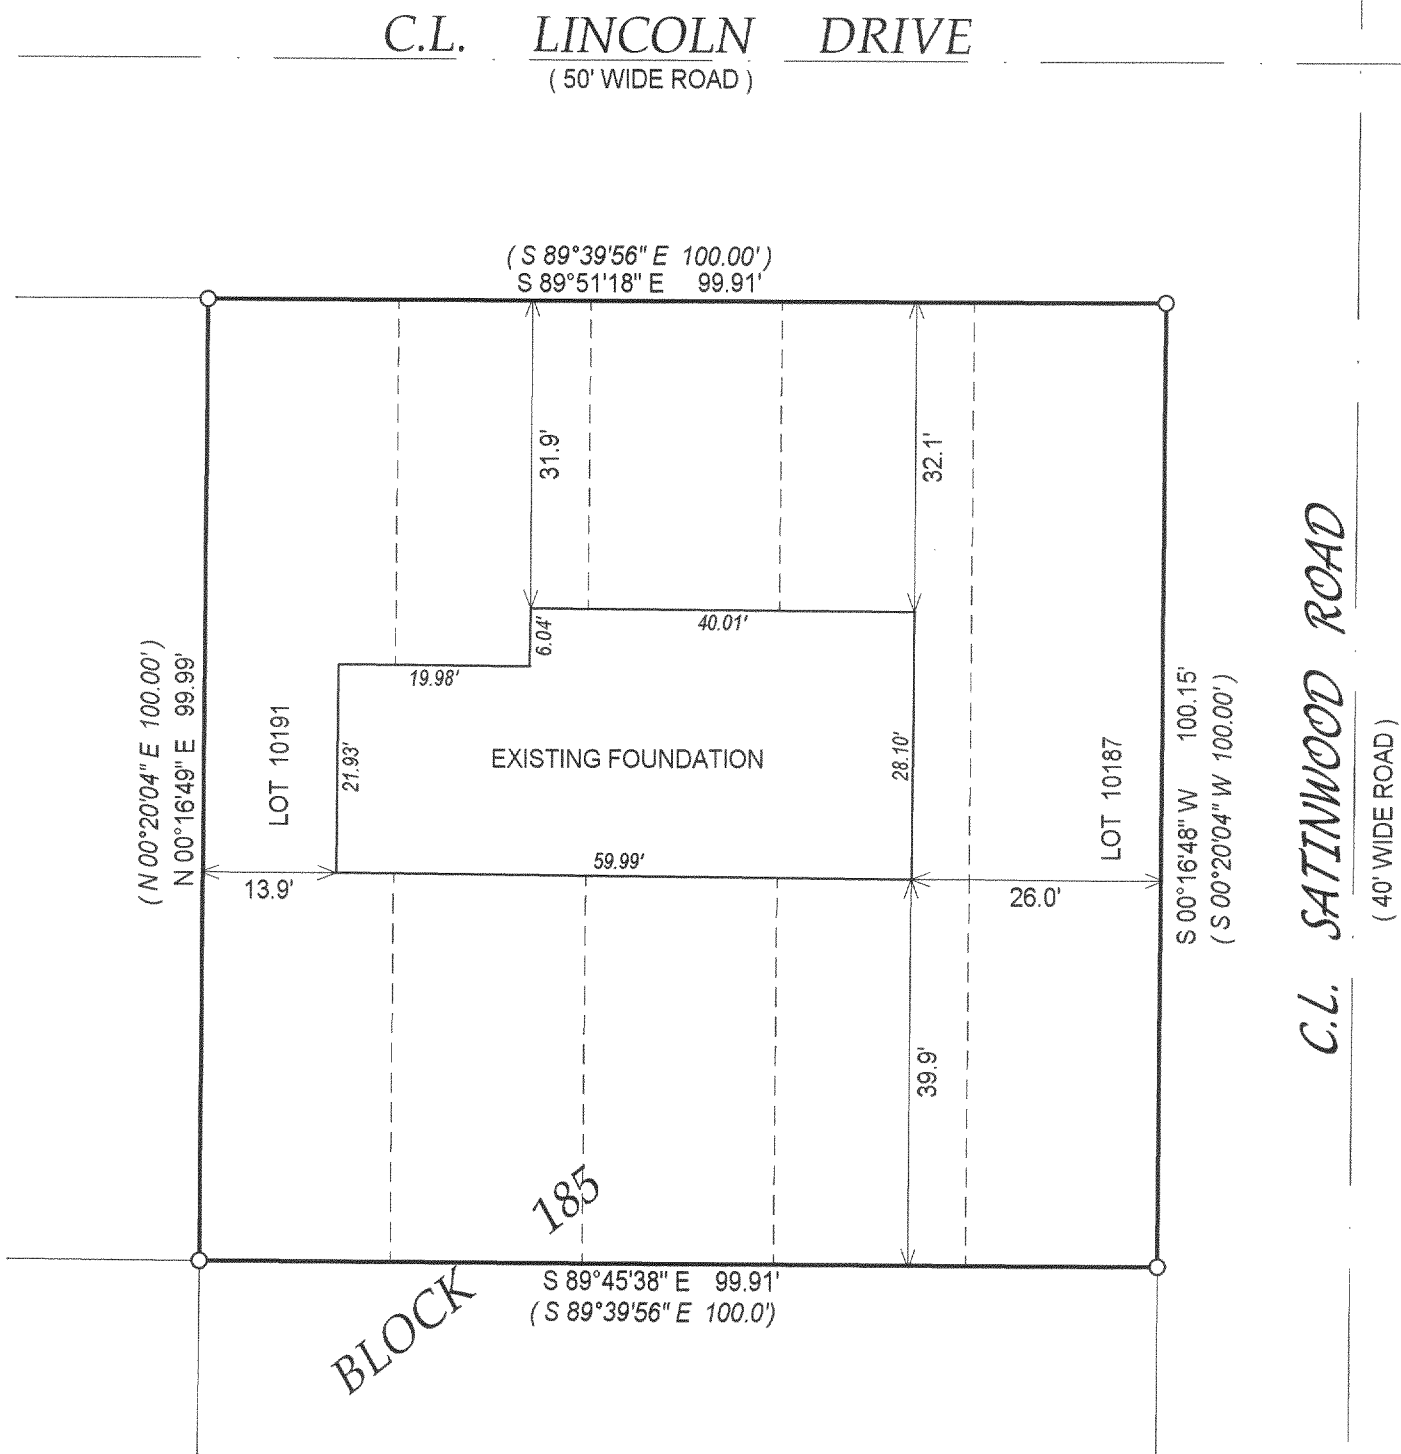

() = recorded as

□ = found iron bar

● = found iron pipe


● = set iron pipe

■ = set iron bar

SCALE 1" = 20'

JOB # 04-253AB


TAX ID # JLCB02203

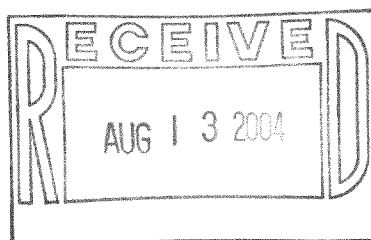

COMPARE LEGAL DESCRIPTION ABOVE AND DRAWING WITH DEED. FOR BUILDING RESTRICTIONS AND
EASEMENTS NOT SHOWN, REFER TO DEED, ABSTRACT SOURCES AND LOCAL MUNICIPAL CODES. NOTIFY
THE SURVEYOR IMMEDIATELY OF ANY DISCREPANCY.

"I hereby certify that the above described property was surveyed under my
supervision and that the above map is a true representation thereof and
shows the size and location of all visible structures, apparent easements
and encroachments if any."

This survey is made for the present owners of the property, and those who
purchase, mortgage, or guarantee the title thereto, within one year from
the date hereof.

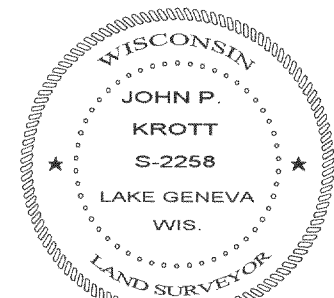

John P. Krott
JOHN KROTT S - 2258
Wisconsin Registered Land Surveyor
(original if signed in red)

DATED THIS THE 1st DAY OF JUNE 2004.
DATE OF LAST REVISION 08-11-04.

217-2878