

HAROLD H. KOLB

REGISTERED PROFESSIONAL LAND SURVEYOR
LAKE GENEVA, WISCONSIN


WOODLAND DRIVE

PLAT OF SURVEY OF

LOTS 4371-4377, BLOCK 76, LAKE
COMO BEACH SUBDIVISION, T2N, R17E,
WALWORTH COUNTY, WISCONSIN.

ORDERED BY: N. ARTHUR RUBINOFF

BLOCK

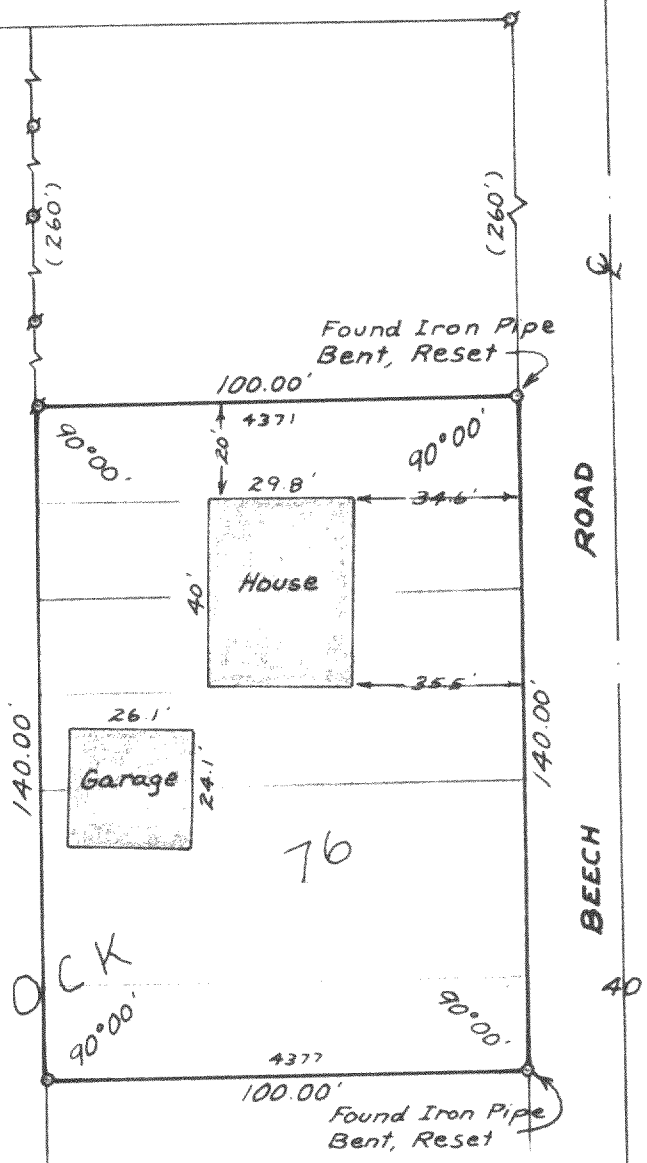

I, EUGENE A. BLOMQUIST, DO HEREBY CERTIFY
THAT I HAVE SURVEYED THE PROPERTY HEREON
DESCRIBED ACCORDING TO THE OFFICIAL RECORDS
AND THAT THE PLAT HEREON IS A CORRECT RE-
PRESENTATION OF THE LOT LINES.



Scale 1" = 40'

JLCB-855

LEGEND

- O — IRON PIPE PLACED, 1" x 24" 1.13 LB./LIN. FT.
- — CONCRETE MONUMENT, 5" DIA. x 30"
- Ø — IRON PIPE FOUND () — AS PLATTED

EUGENE A. BLOMQUIST
WISCONSIN REGISTERED LAND SURVEYOR, S-1279
DATE Feb. 28, 1977