


AS BUILT UNIT LOCATION
GENEVA NATIONAL CONDOMINIUM 47 ADD. 1
LOCATED IN TOWN 2 NORTH, RANGE 17 EAST
WALWORTH COUNTY, WISCONSIN


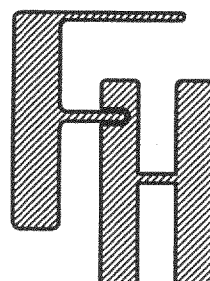


HARVEST HOMES, INC.
5024 GREENBAY ROAD
KENOSHA, WI. 53144

FARRIS, HANSEN & ASSOCIATES, INC.
ENGINEERING - ARCHITECTURE - SURVEYING
7 RIDGWAY COURT P.O. BOX 437
ELKHORN, WISCONSIN 53121
OFFICE: (262) 723-2098 FAX: (262) 723-5886

REVISIONS

PROJECT NO.
3269.46
DATE
12-29-03
SHEET NO.
1 OF 1

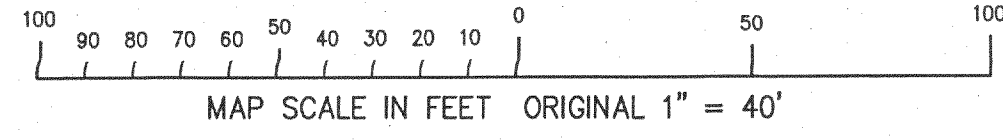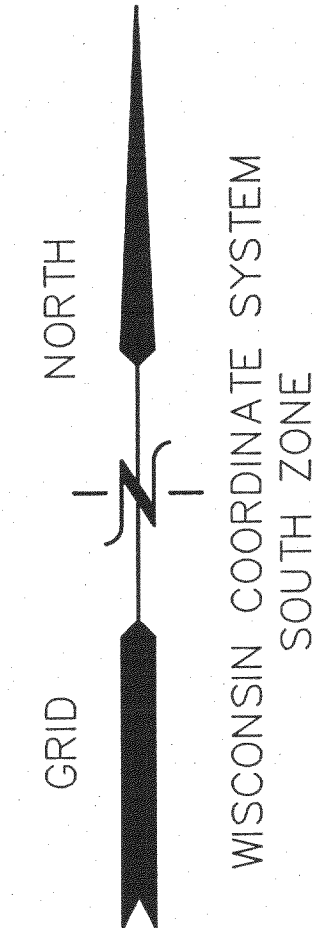

LEGEND
● = FOUND IRON REBAR STAKE

GENEVA NATIONAL CONDOMINIUM NO. 47
47-08
47-07
47-06
47-05
47-04
47-03
47-02
47-01

HILLVIEW CIRCLE

DECLARED
AREA 1
ADDENDUM 1

DECLARED
AREA 2
ADDENDUM 1

EAGLETON DRIVE

PRIVATE ROADWAY

NOTE: COPIES OF THIS MAP TO WHICH THE FOLLOWING CERTIFICATE WILL APPLY SHOW SURVEYOR'S ORIGINAL SEAL AND SIGNATURE IN RED INK. COPIES BY ANY OTHER MEANS MAY HAVE ALTERATIONS WHICH DO NOT REPRESENT THE SURVEYOR'S WORK PRODUCT.

I HEREBY CERTIFY THAT THE ABOVE DESCRIBED PROPERTY HAS BEEN SURVEYED UNDER MY DIRECTION AND THAT THE ABOVE MAP IS A TRUE REPRESENTATION THEREOF AND SHOWS THE SIZE AND LOCATION OF THE PROPERTY AND ITS EXTERIOR BOUNDARIES. THIS SURVEY IS MADE FOR THE USE OF THE PRESENT OWNERS OF THE PROPERTY, AND ALSO THOSE WHO PURCHASE, MORTGAGE, OR GUARANTEE THE TITLE THERETO WITHIN ONE YEAR FROM THE DATE HEREOF.

DATED: APRIL 27, 2004

PETER S. GORDON R.L.S. 2101

REVISED 12-27-2004
TO SHOW SIZE & LOCATION OF
AS BUILT UNITS 29 & 30

FEB - 4 2004

12/27/2004 K:\Projects\3269\CONDO-46\COND046.dwg

JGN47-1

217-2983