


GEORGE T. DUNHAM  
SURVEYING & SUBDIVIDING  
DELAVAN, WISCONSIN

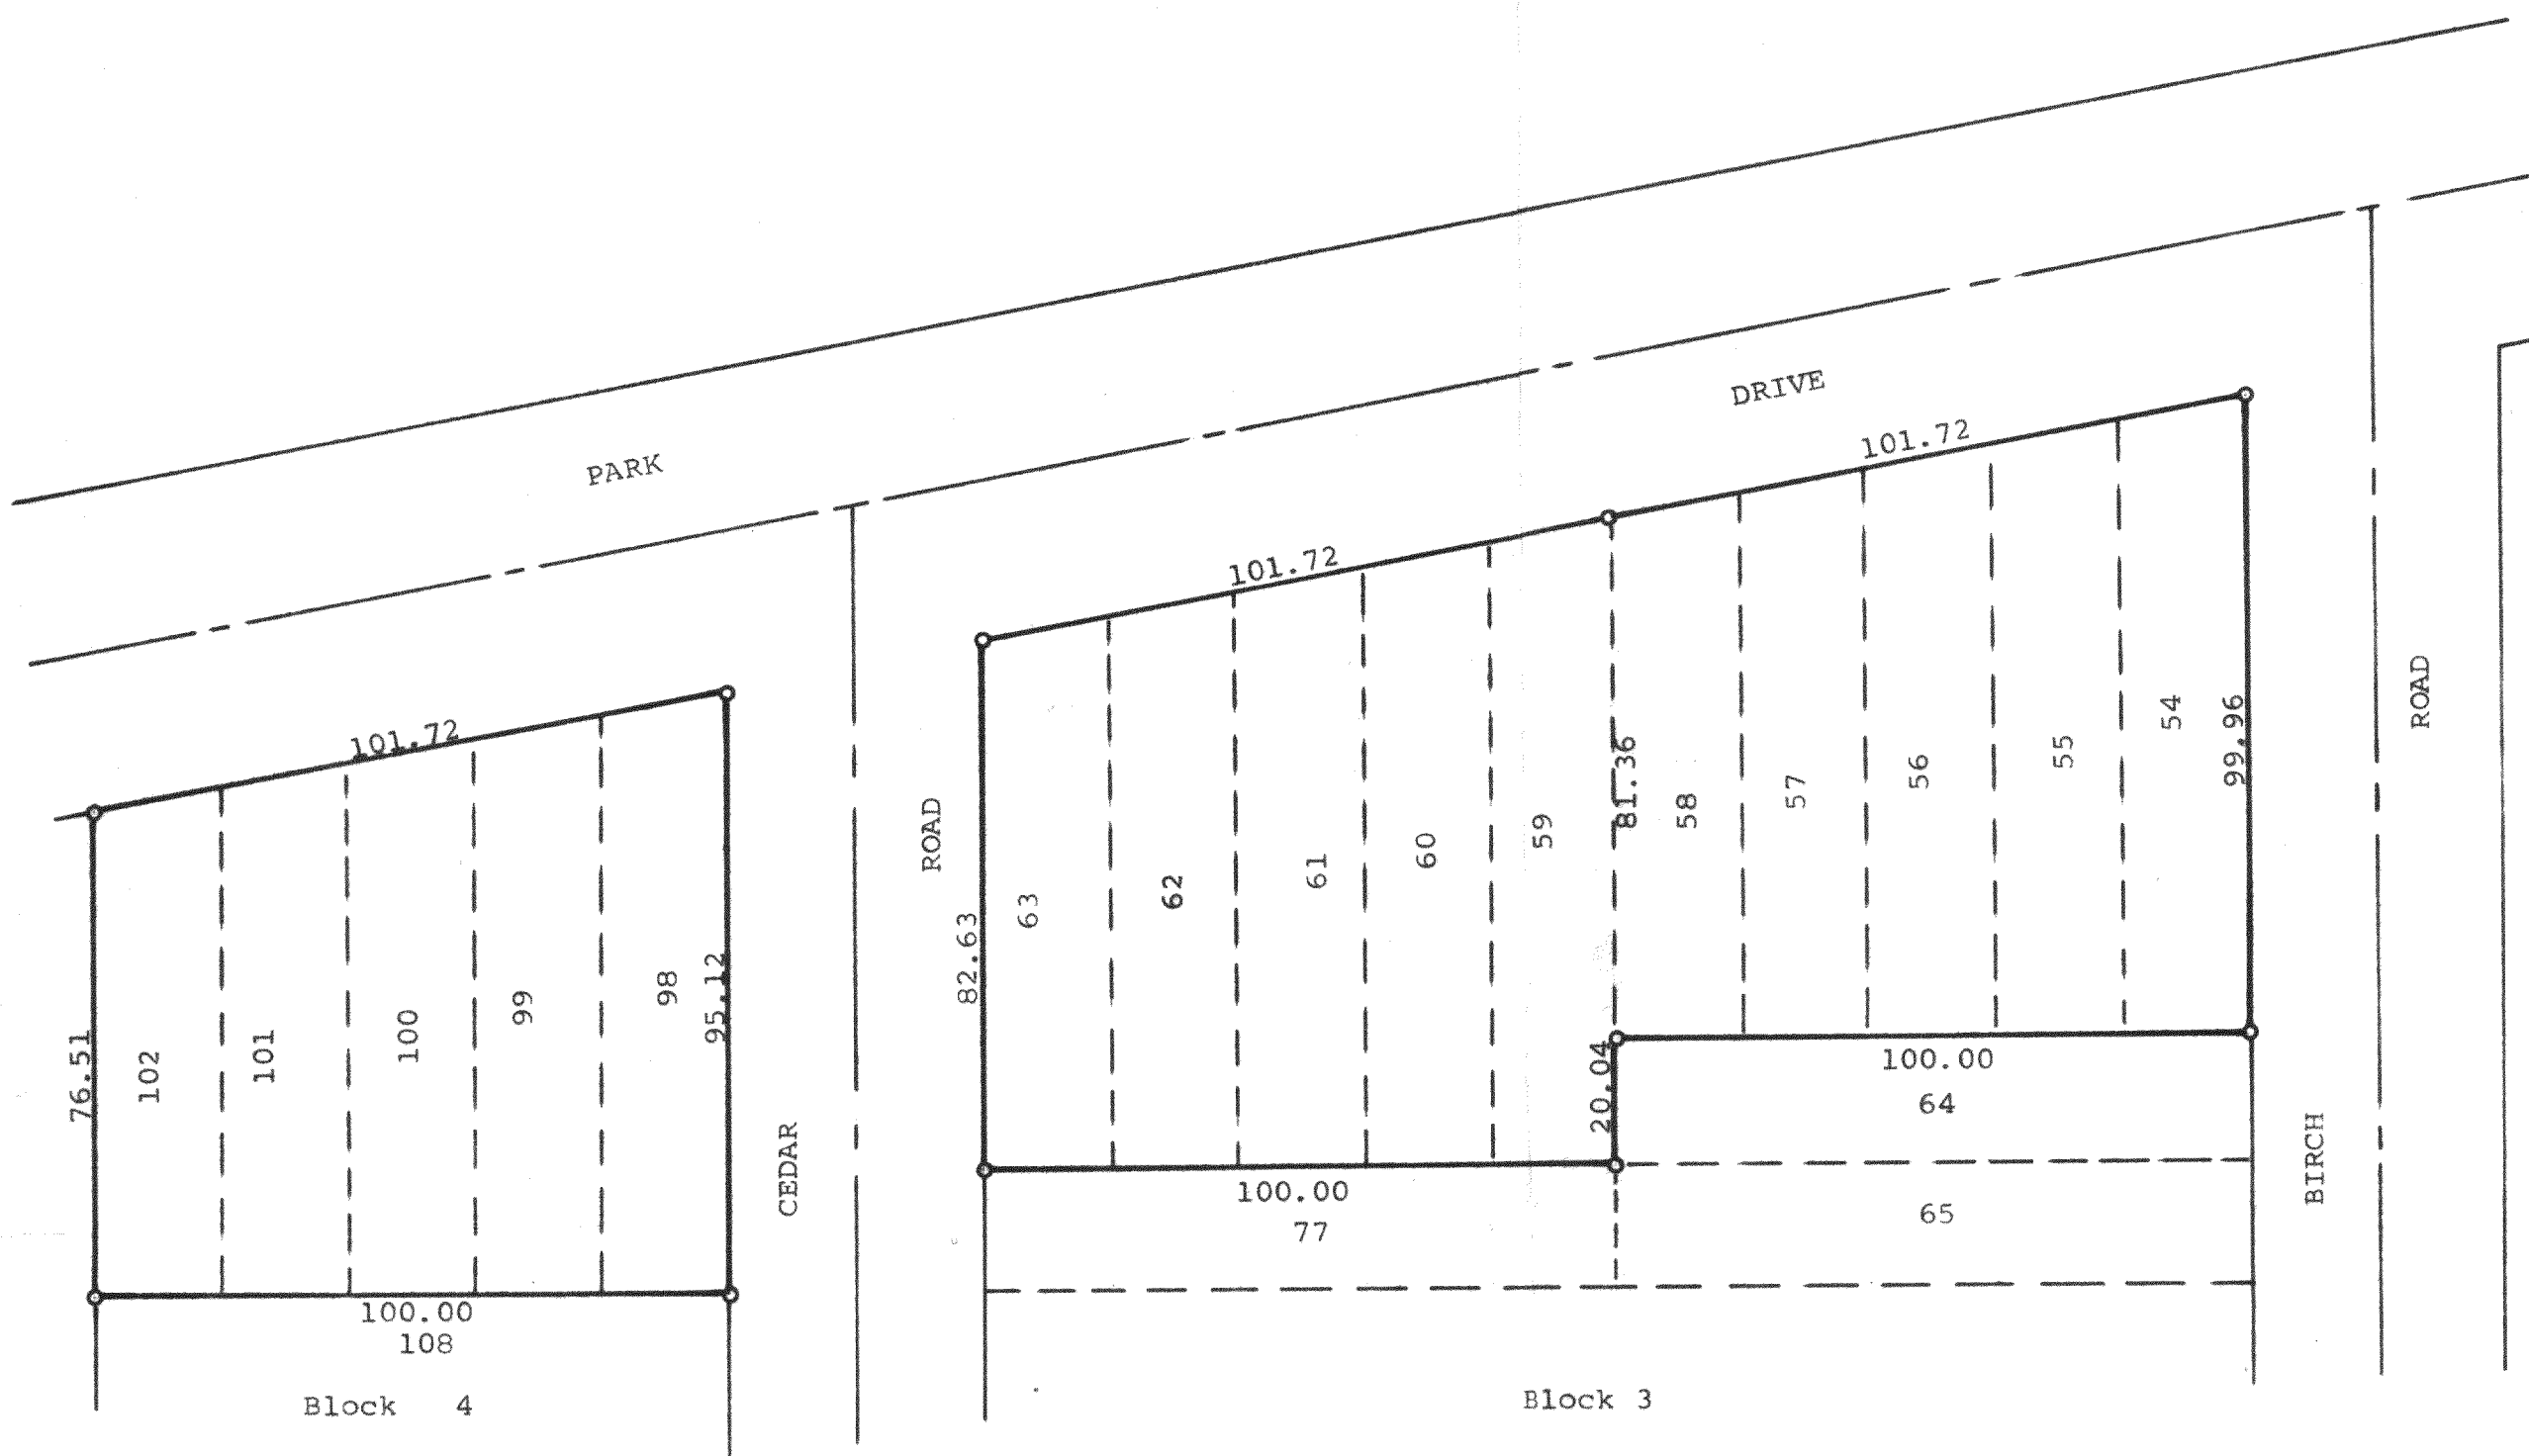

Scale - 1" = 30'  
● = Iron Pipe

Plat of survey of Lots 54-63 inclusive in Block 3 and  
Lots 98-102 inclusive in Block 4, all in Lake Como Beach  
Subdivision, Section 22, T 2 N, R 17 E, Walworth County,  
Wisconsin.  
April 9, 1976

*George T. Dunham*  
George T. Dunham, Surveyor

