


SCALE - 1" = 40'
O = IRON PIPE

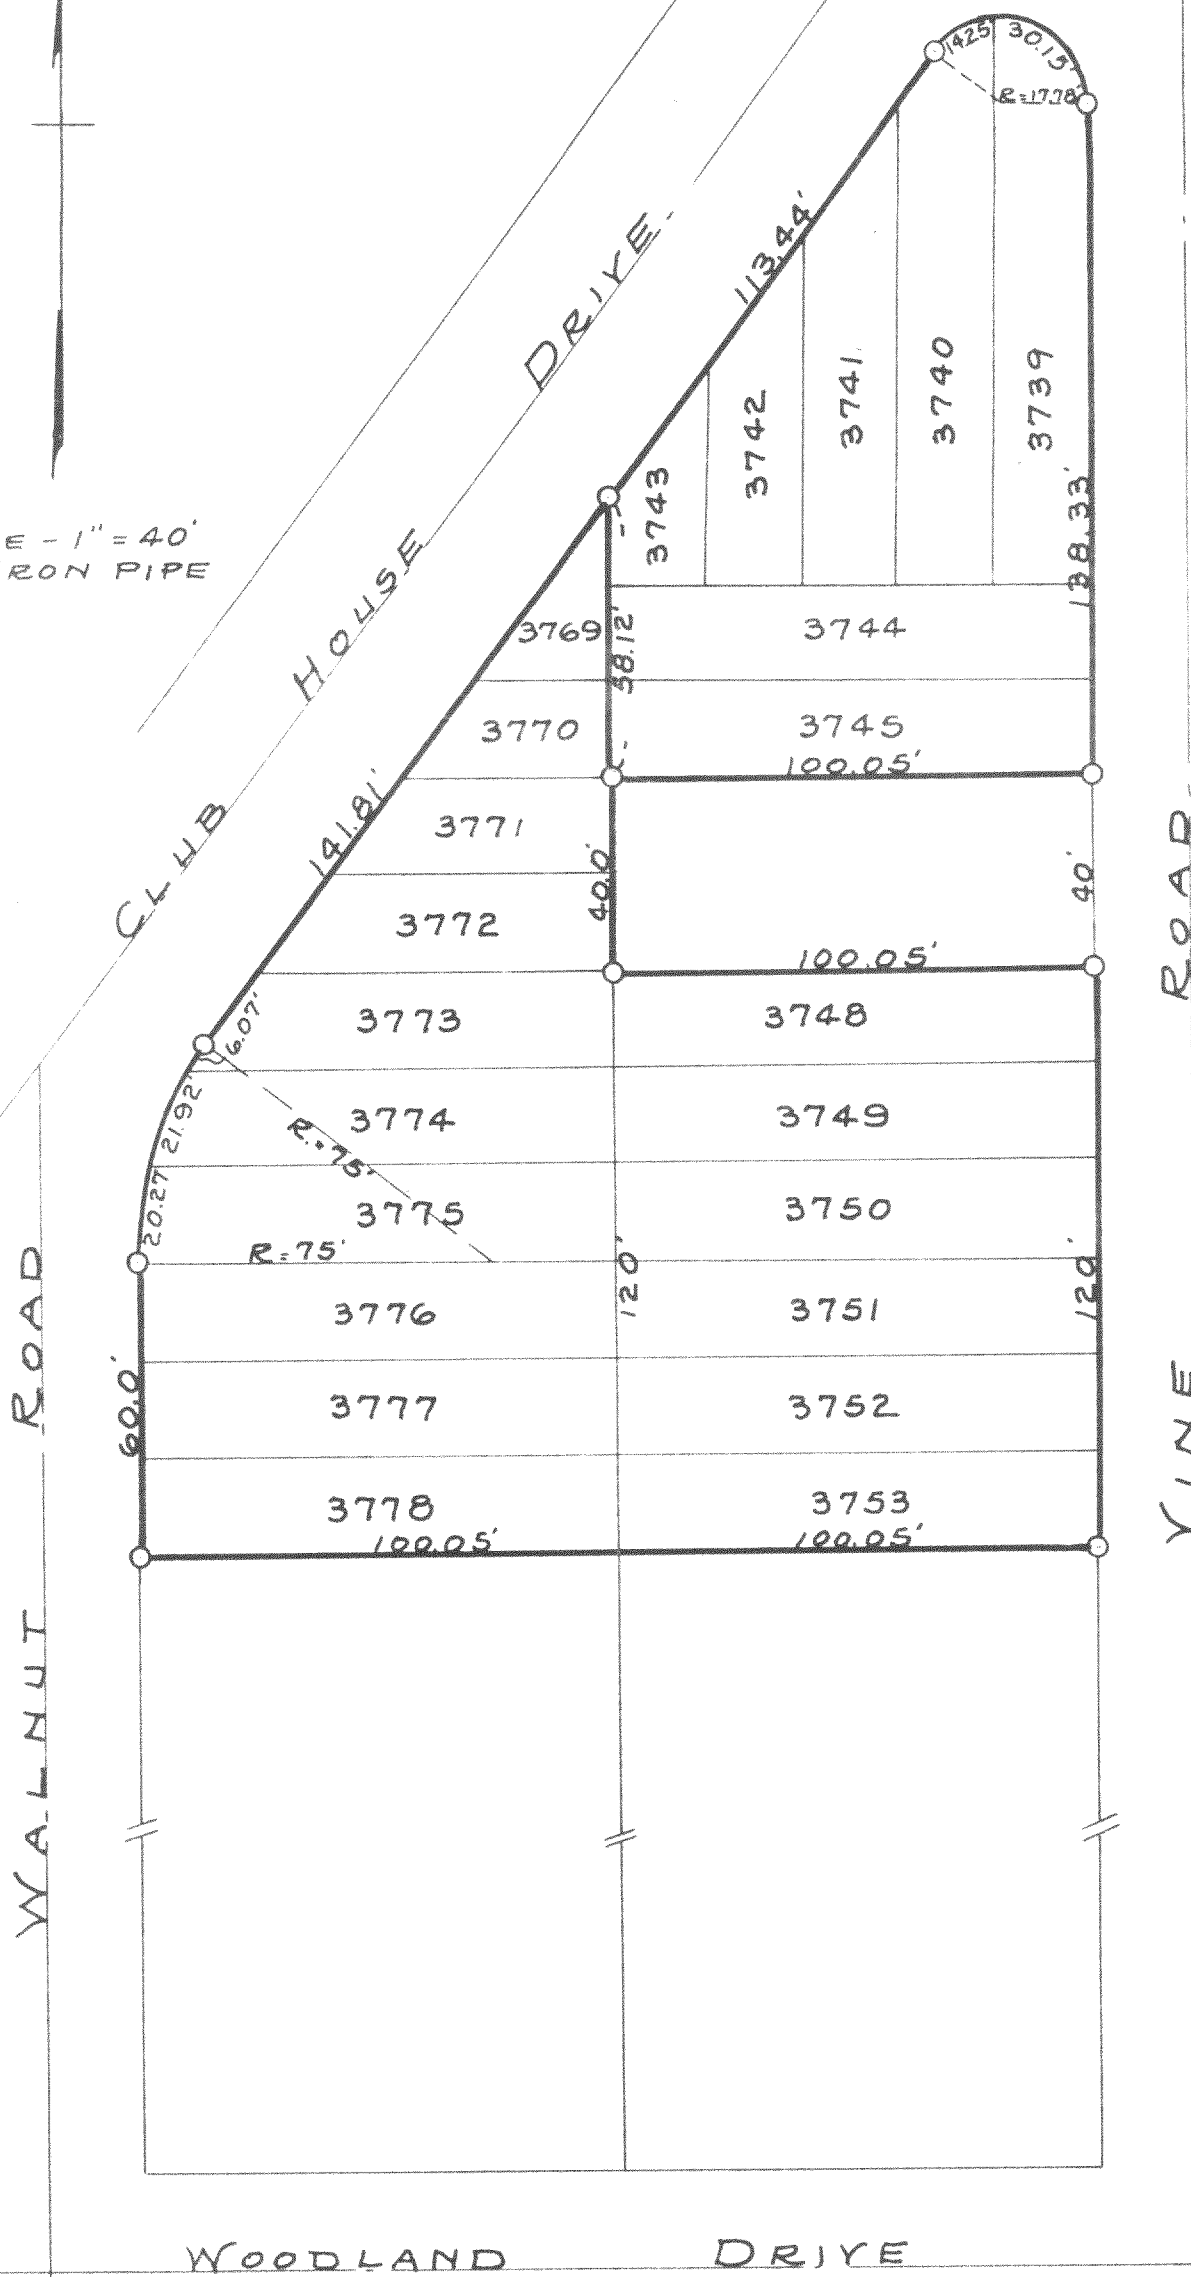

I HEREBY CERTIFY THAT I HAVE SURVEYED THE LOTS LOCATED IN LAKE COMO BEACH SUBDIVISION OF WALWORTH COUNTY WISCONSIN, AS SHOWN ON THE ABOVE PLAT, AND THAT THE ABOVE PLAT IS A CORRECT REPRESENTATION OF SAID LOTS. I FURTHER CERTIFY THAT THERE ARE NO ENCROACHMENTS ON THE ABOVE PROPERTY BY ADJOINING PROPERTY OWNERS AT THE DATE OF THIS SURVEY.

OCT. 1946

Lloyd L. Jensen
COUNTY SURVEYOR

217-31