
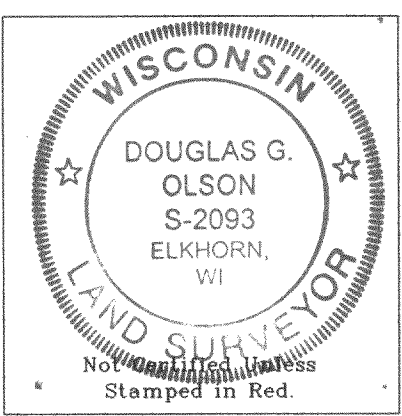
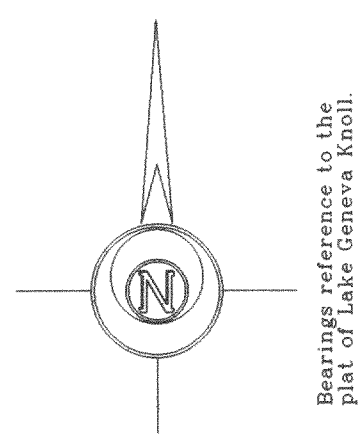


RECEIVED
SEP 20 2005

Plat of Survey

of
Lot 18 except the South 20 feet and all
of Lots 28 and 29 in Lake Geneva Knolls,
a subdivision located in the Southwest 1/4 of Section 33, Town 2
North, Range 17 East, Town of Geneva, Walworth County, Wisconsin.

Surveyed for: **Dean Babcock**
W3935 State Road 50
Lake Geneva, Wisconsin. 53147

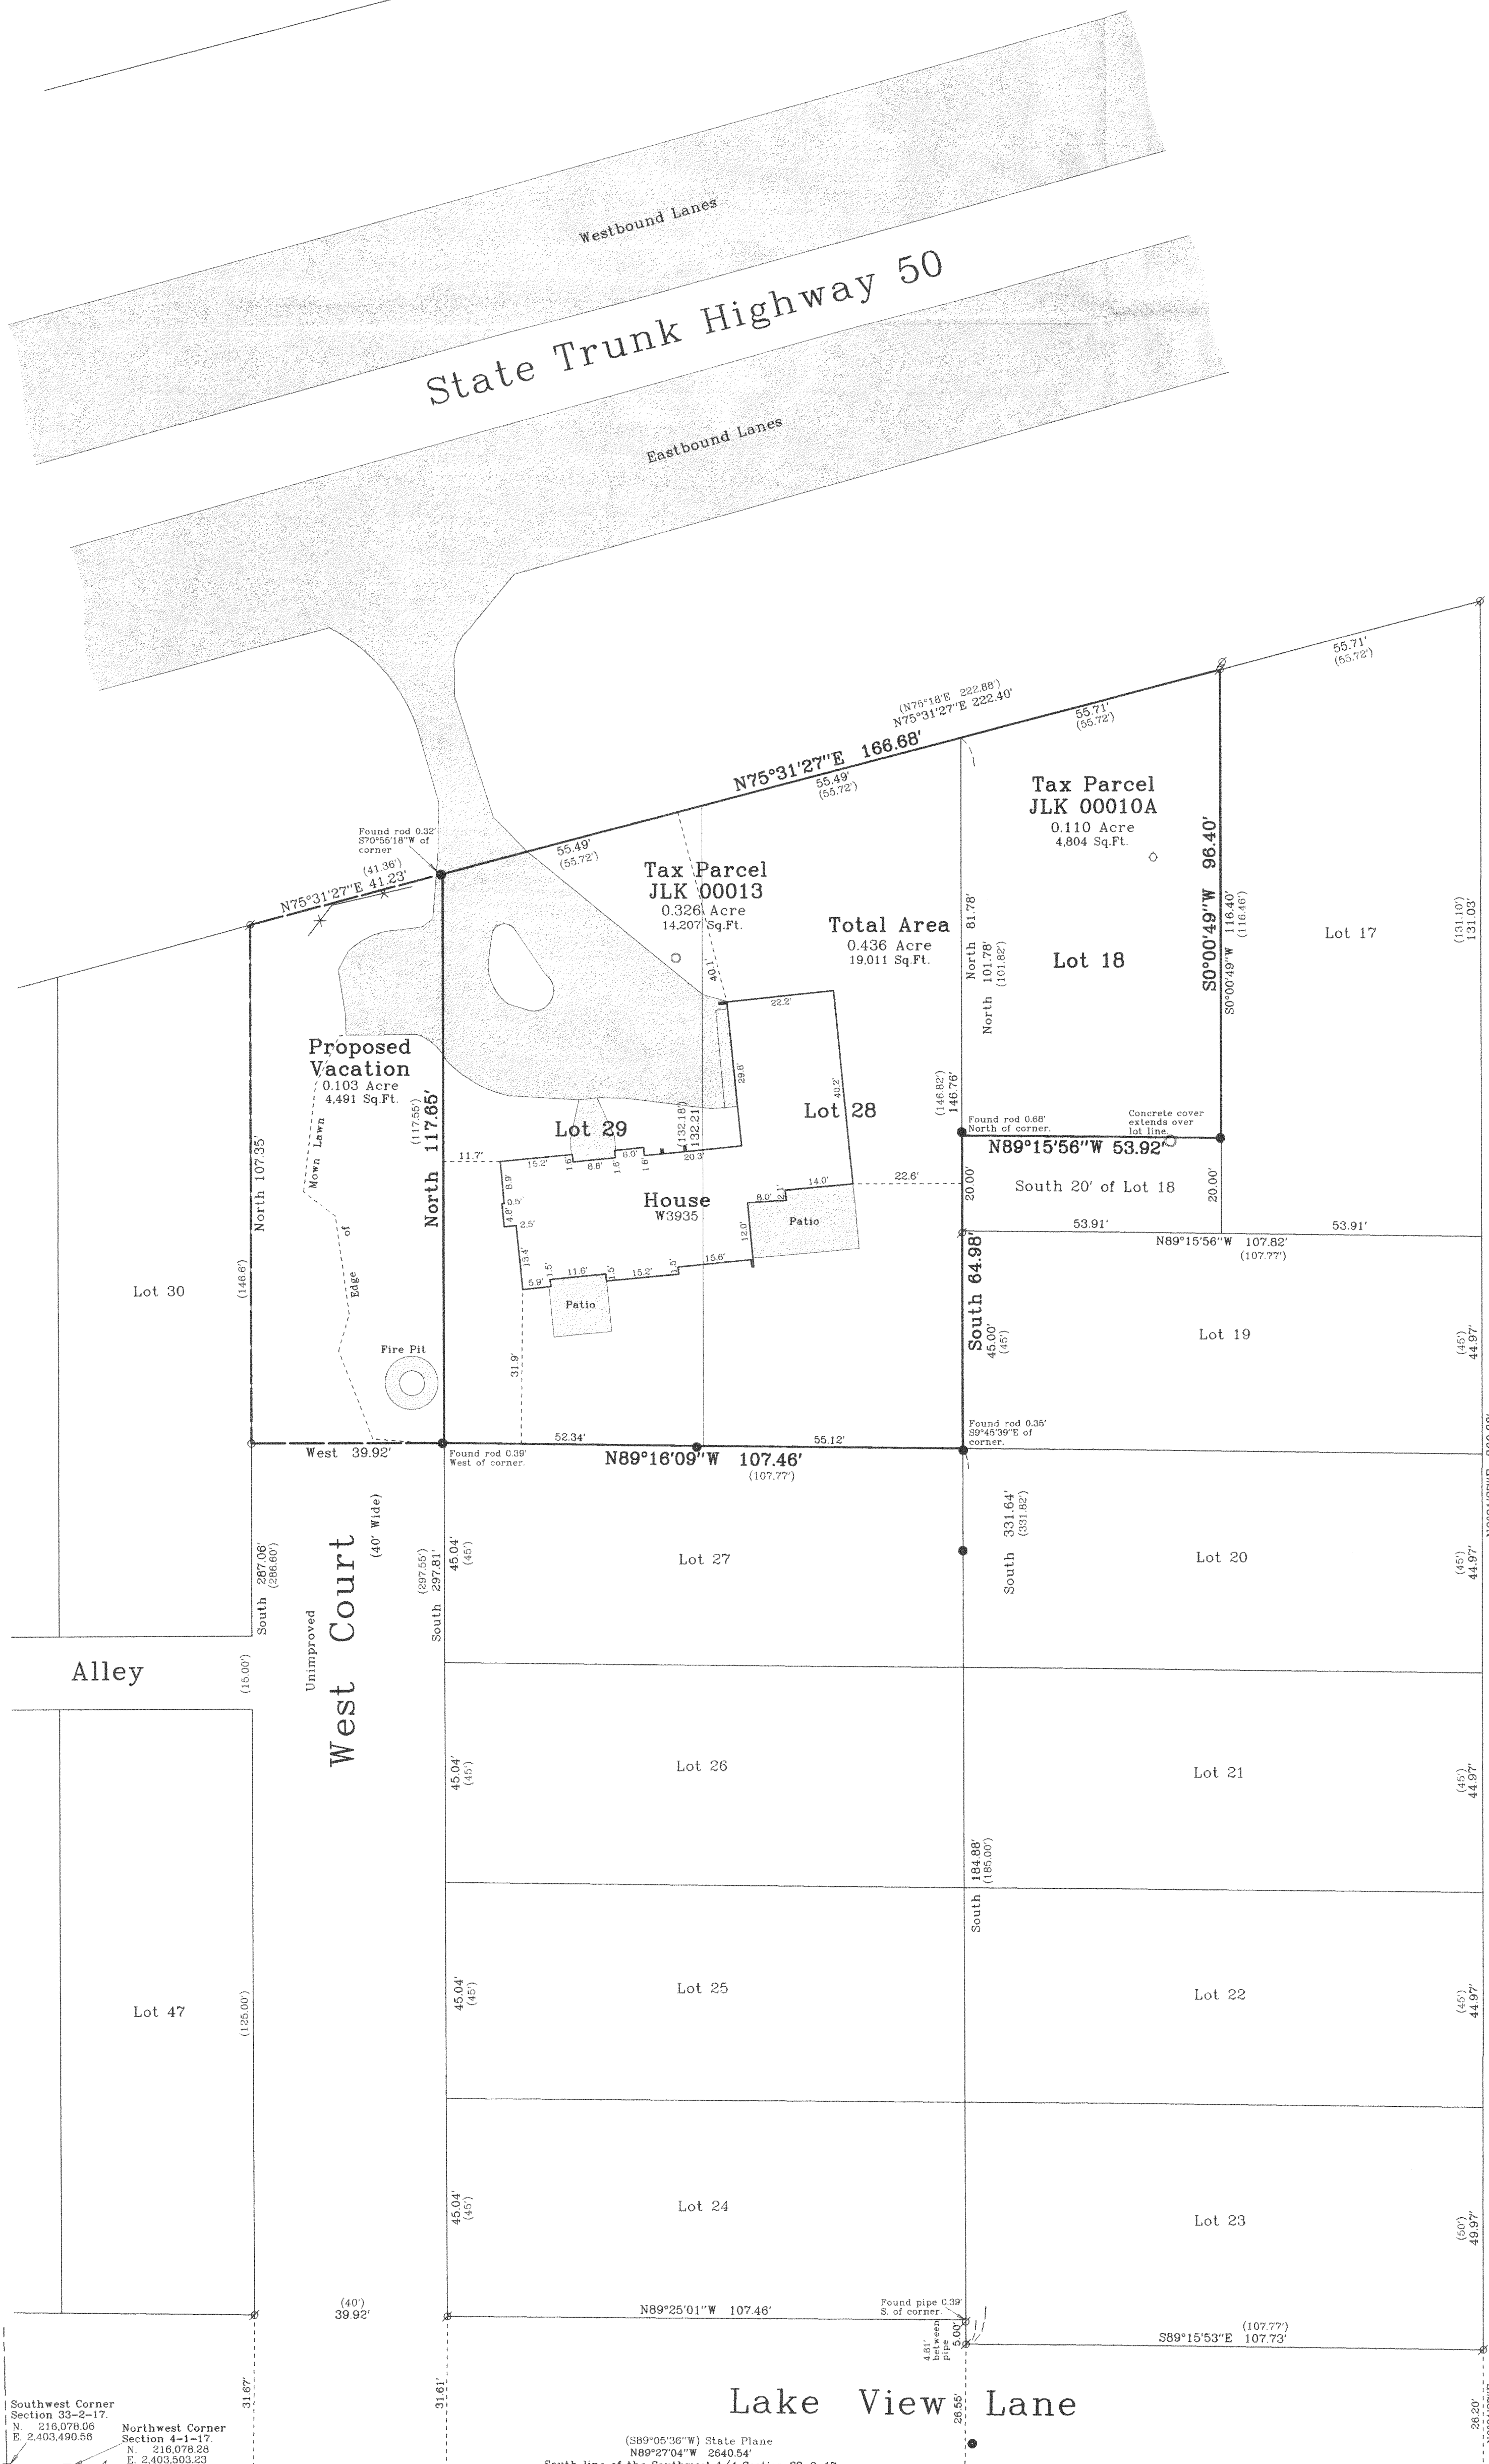

Notes: 1) This survey plat is not certified unless signed and sealed in red ink.
2) This survey is subject to Wisconsin lien laws. This Plat of Survey is the notice of intent to file lien. Lien waiver required.

Legal Description of Proposed Vacation
A portion of West Court lying west of Lot 29 of Lake Geneva Knolls, a subdivision located in the Southwest 1/4 of Section 33, Town 2 North, Range 17 East, Town of Geneva, Walworth County, Wisconsin, described as follows: Begin at the Northwest corner of said Lot 29; thence South, along the West line of said Lot 29, 117.65 feet to the Southwest corner of said Lot 29; thence West, 39.92 feet to a point on the East line of Lot 30 of said Lake Geneva Knolls; thence North, along said East line, 107.35 feet to an iron pipe marking the Northeast corner of said Lot 30; thence North 75°31'27" East 41.23 feet to the Point of Beginning.
Said parcel contains 0.103 acre (4,491 sq. ft.) of land, more or less.

Copyright © 2005 by Jensen & Olson Land Surveying, LLC.
All rights reserved. No part of this survey plat may be reproduced or transmitted in any form by any means - graphic, electronic, or mechanical, including photocopying, tracing, or information storage and retrieval systems - without permission in writing from Douglas G. Olson, Jensen & Olson Land Surveying, LLC.

I, Douglas G. Olson, Wisconsin Registered Land Surveyor, do hereby certify that this survey was performed by me or under my direction in full compliance with the owner's/agent's instructions and Chapter A-E 7 of the Wisconsin Administrative Code "Minimum Standards for Property Surveys", and that this map is an accurate representation thereof to the best of my knowledge and belief.

Douglas G. Olson
Wisconsin Registered Land Surveyor - 2093

Sheet 1 of 1 Sheets.	Legend ● Found Iron Pipe ○ Found Iron Rod, 3/4" dia. ○ Set Iron Rod, 3/4" dia. () Recorded Information ○ Concrete Cover ○ Septic Vent — Asphalt Surface — Concrete Surface ■ Found County Section Corner	Jensen & Olson Land Surveying, LLC 45 South Wisconsin Street P.O. Box 322 Elkhorn, Wisconsin. 53121 Telephone: (262) 723-3434 Facsimile: (262) 723-8044	Scale in Feet 1" = 20' 	Survey date: September 20, 2005. Revisions:
Job Reference Number 2005.080				

JLK 00010A
JLK 00013

217-3124