


# AS-BUILT MAPPING PLAT OF SURVEY

UNIT 19-12  
GENEVA NATIONAL CONDOMINIUM  
NO. 19  
LOCATED IN TOWN 2 NORTH, RANGE 17 EAST,  
WALWORTH COUNTY, WISCONSIN

GOLF CLUB GROUNDS

## LEGEND

● = FOUND IRON REBAR STAKE

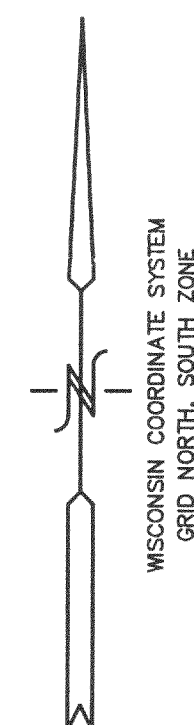

UNIT 19-11

DRAINAGEWAY

SWALE

UNIT 19-12  
45,849 S.F.

SWALE

50' REAR YARD

AS-BUILT  
RESIDENCE  
(FIELD LOCATED 11/4/05)

UNIT 19-13

ST. ANDREWS ROAD  
66' WIDE PRIVATE ROADWAY

BENCH MARK  
NE UPPER FLANGE BOLT  
HYDRANT  
EL. = 1019.15'

NOTE: COPIES OF THIS MAP TO WHICH THE FOLLOWING CERTIFICATE WILL APPLY SHOW THE SURVEYOR'S ORIGINAL SEAL AND SIGNATURE IN RED INK. COPIES BY ANY OTHER MEANS MAY HAVE ALTERATIONS WHICH DO NOT REPRESENT THE SURVEYOR'S WORK PRODUCT.

I HEREBY CERTIFY THAT THE ABOVE DESCRIBED PROPERTY HAS BEEN SURVEYED UNDER MY DIRECTION AND THAT THE ABOVE MAP IS A TRUE REPRESENTATION THEREOF AND SHOWS THE SIZE AND LOCATION OF THE PROPERTY, ITS EXTERIOR BOUNDARIES, THE LOCATION OF ALL VISIBLE STRUCTURES, AND DIMENSIONS OF ALL PRINCIPLE BUILDINGS THEREON, BOUNDARY FENCES, APPARENT EASEMENTS, ROADWAYS, AND VISIBLE ENCROACHMENTS, IF ANY. THIS SURVEY IS MADE FOR THE USE OF THE PRESENT OWNERS OF THE PROPERTY, AND ALSO THOSE WHO PURCHASE, MORTGAGE, OR GUARANTEE THE TITLE THERETO WITHIN ONE YEAR FROM THE DATE HEREOF.

DATED: JUNE 14, 2004

PETER S. GORDON

WORK ORDERED BY:  
CURT LANGILLE - LANCO DEVEL. CO.  
7355 BANNOCKBURN CIRCLE  
LAKEWOOD, IL 60014

FARRIS, HANSEN & ASSOCIATES, INC.  
Engineering, Architecture, Surveying  
7 Ridgway Court P.O. Box 437  
ELKHORN, WISCONSIN 53121  
Office: (262) 723-2098  
Fax: (262) 723-5886

REVISIONS  
03/25/2004  
TO SHOW  
ENCROACHMENT  
04/14/2004  
SHOW TOPO-  
GRAPHICAL  
FEATURES  
06/15/2005  
SITE, GRADING,  
DRAINAGE, &  
EROSION  
CONTROL PLAN  
07/26/2005  
MISC. REVISIONS  
11/05/2005  
TO SHOW SIZE  
AND LOCATION  
OF AS-BUILT  
RESIDENCE

PROJECT NO.  
3269.19-12  
DATE:  
03/25/2004  
SHEET NO.  
1 OF 1

NOV 07 2005

JGN 19-12

217-3150