PREPARED FOR: BASSO BUILDERS 403 SKYLINE DR LAKE GENEVA, WI 53147


PLAT OF SURVEY

PATHFINDER SURVEYING INC. N3705 WILLOW BEND LANE LAKE GENEVA WI. 53147

-OF-

LOTS 2782 THRU 2786, AND LOT 2776 BLOCK 48 OF LAKE COMO BEACH SUBDIVISION, LOCATED IN SECTIONS 22 AND 27, T2N, R17E, WALWORTH COUNTY, WISCONSIN.



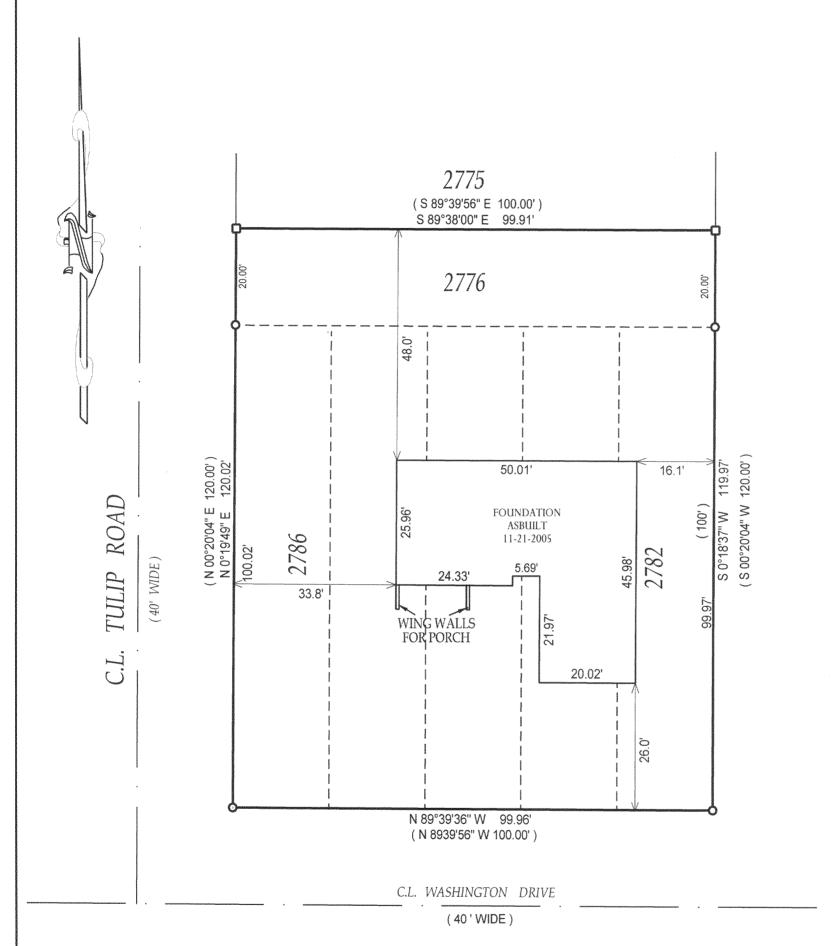

LEGEND

() = recorded as

☐ = found iron bar

O = found iron pipe

= set iron pipe

= set iron bar

SCALE 1" = 20'

JOB# 04-651AB

TAX ID # JLCB 00483

REVISED 11-21-2005, FOUNDATION ASBUILT J.Z.

COMPARE LEGAL DESCRIPTION ABOVE AND DRAWING WITH DEED. FOR BUILDING RESTRICTIONS AND EASEMENTS NOT SHOWN, REFER TO DEED, ABSTRACT SOURCES AND LOCAL MUNICIPAL CODES. NOTIFY THE SURVEYOR IMMEDIATELY OF ANY DISCREPANCY.

"I hereby certify that the above described property was surveyed under my supervision and that the above map is a true representation thereof and shows the size and location of all visible structures, apparent easements and encroachments if any."

This survey is made for the present owners of the property, and those who purchase, mortgage, or guarentee the title thereto, within one year from the date hereof.

REVISED 10-17-2005, MOVED PROPOSED HOUSE REVISED 9-30-05 DATED THIS 10th, DAY OF DECEMBER, 2004



JOHN KROTT S - 2258 Wisconsin Registered Land Surveyor (original if signed in red)