
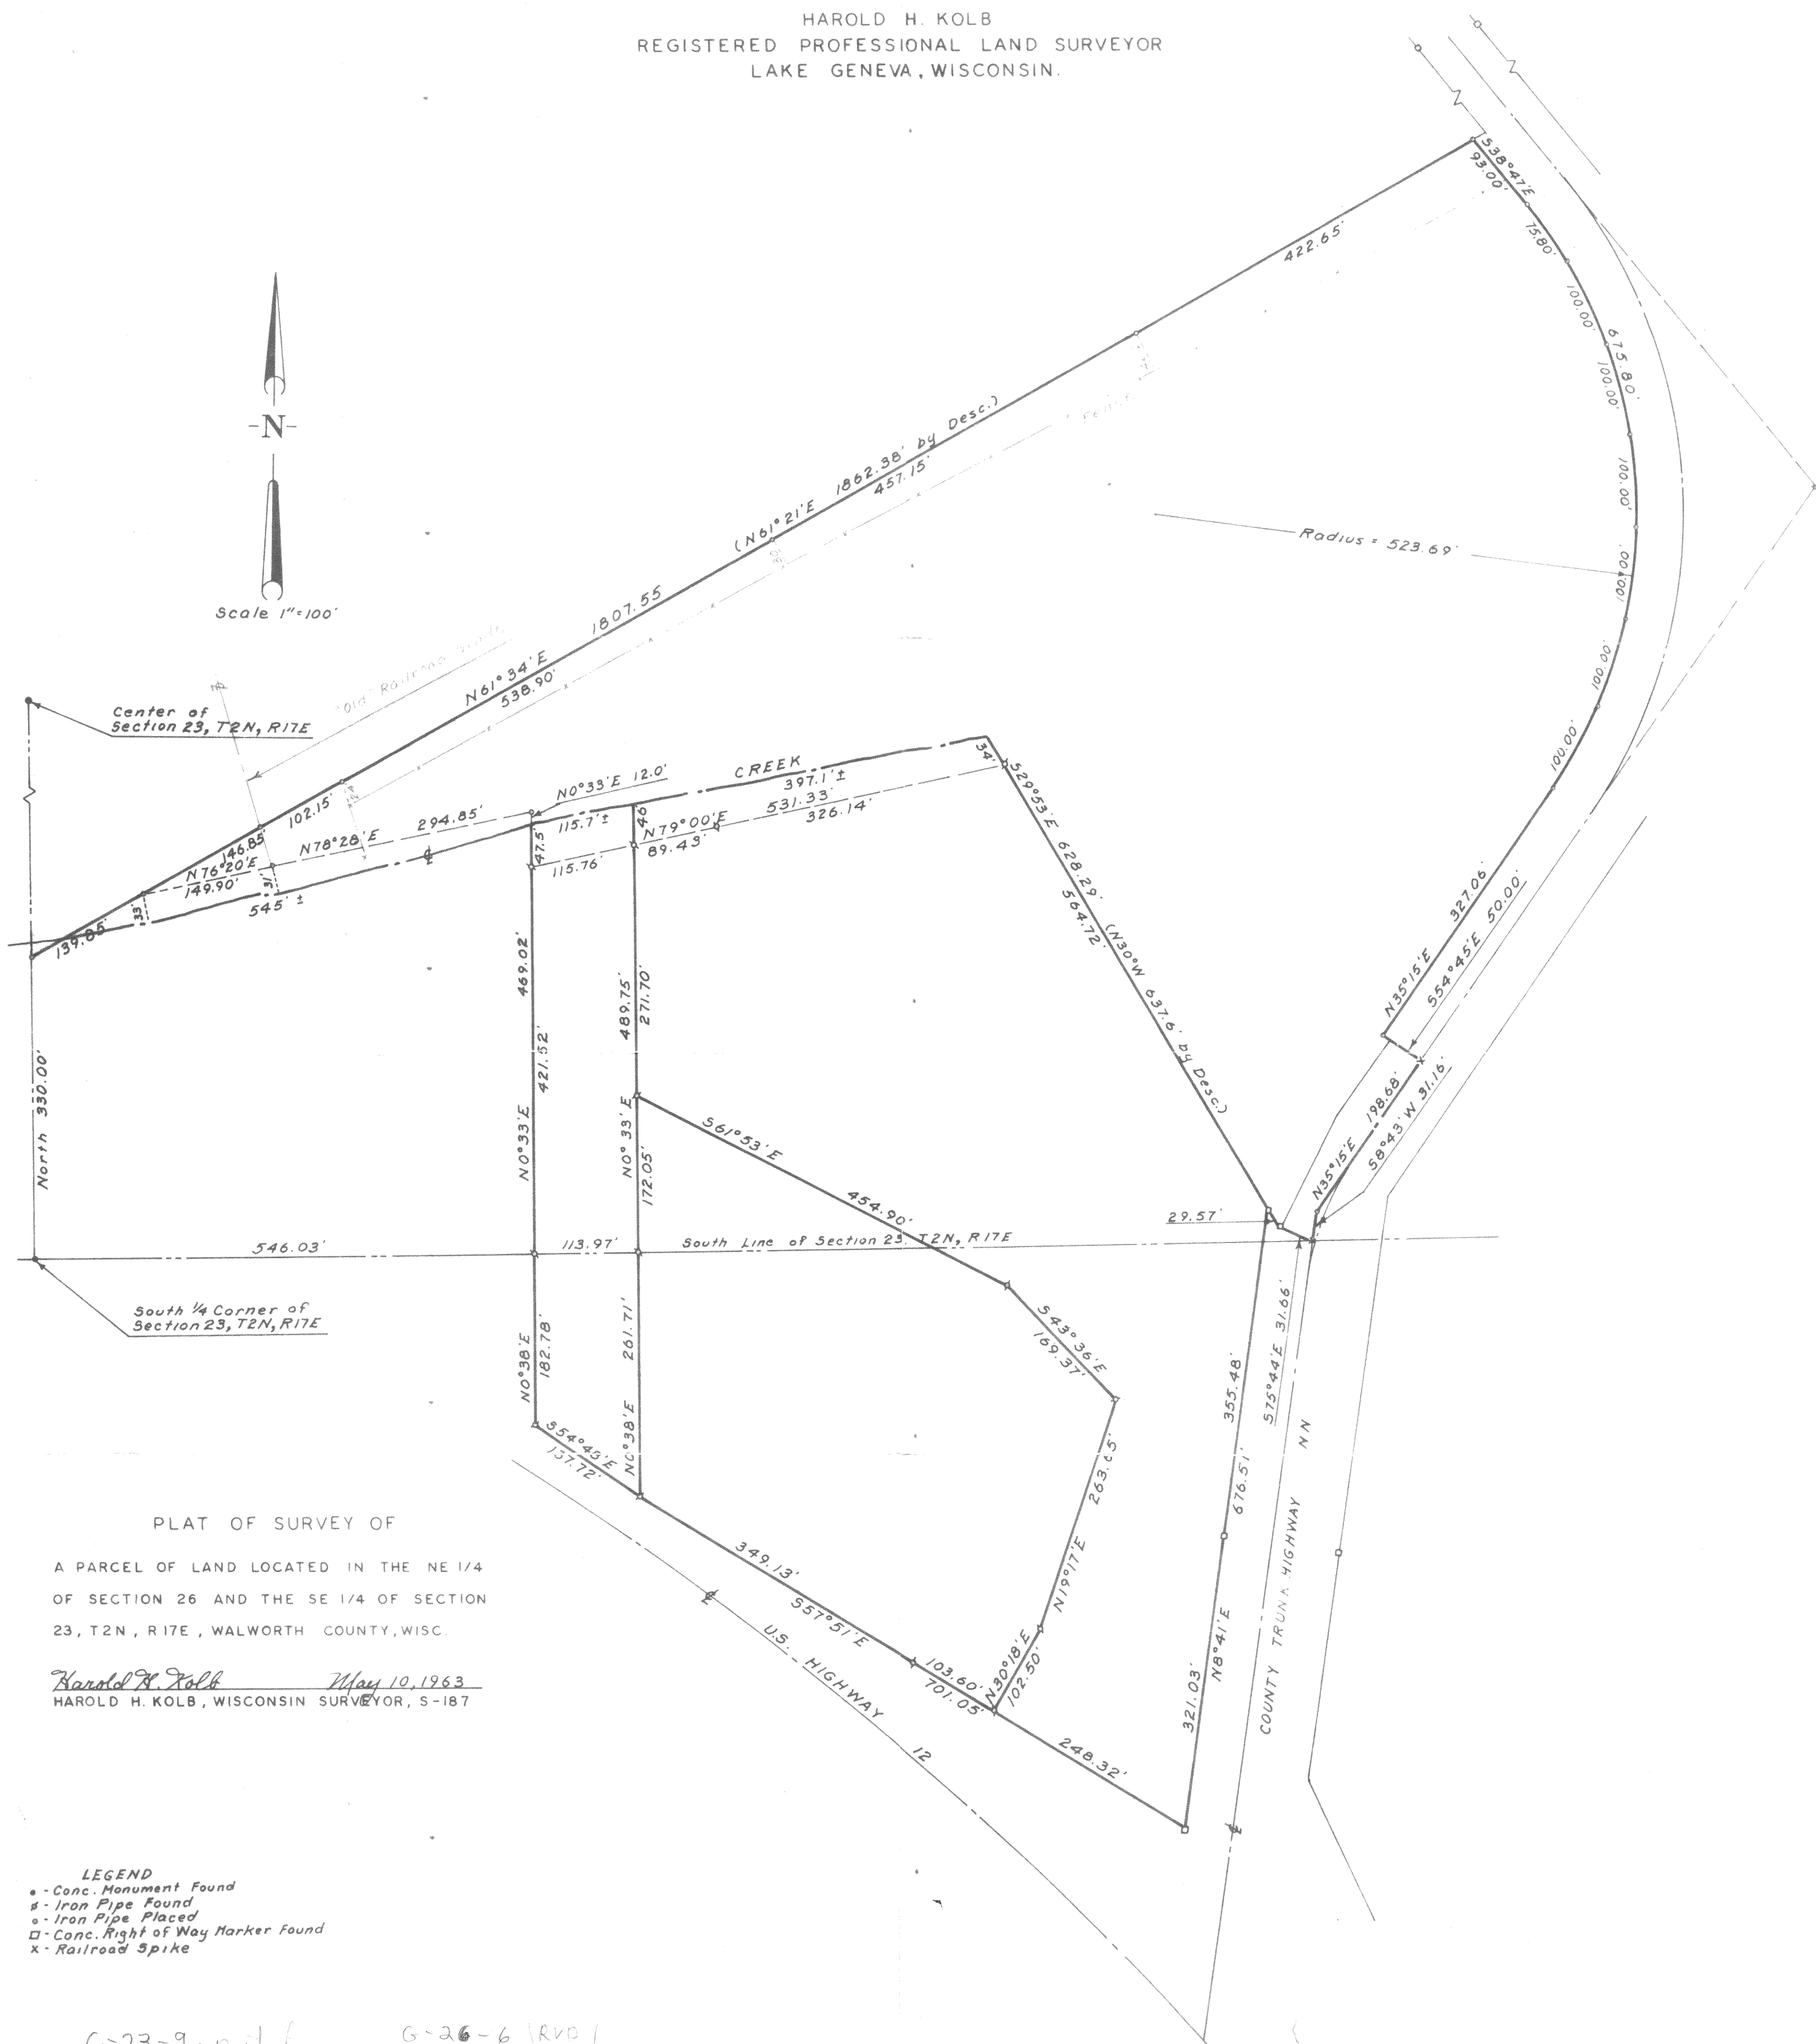


HAROLD H. KOLB
REGISTERED PROFESSIONAL LAND SURVEYOR
LAKE GENEVA, WISCONSIN.

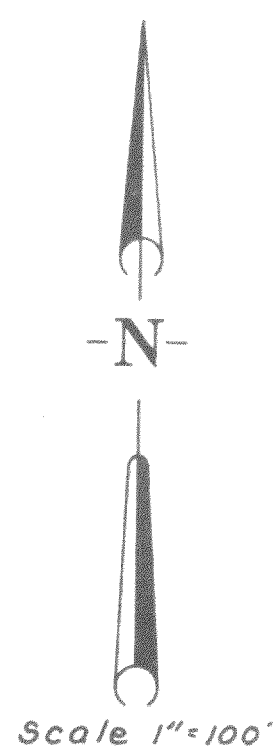

PLAT OF SURVEY OF
A PARCEL OF LAND LOCATED IN THE NE 1/4
OF SECTION 26 AND THE SE 1/4 OF SECTION
23, T2N, R17E, WALWORTH COUNTY, WISC.

Harold H. Kolb May 10, 1963
HAROLD H. KOLB, WISCONSIN SURVEYOR, S-187

G-23-9-part of
G-23-10 and G-23-9A (RVD) G-26-6 (RVD)
G-26-8D (RVD)