



PLAT OF SURVEY



FOR: DANIEL KLODZIN  
DATE: JANUARY 10, 2007

Engineers Land Surveyors Environmental Scientists  
W232 S7530 BIG BEND DR. BIG BEND, WI 53103 (262)662-4292

DESCRIPTION: LOT 18 OF WILDWOOD, A SUBDIVISION LOCATED IN THE  
NORTHWEST 1/4 AND NORTHEAST 1/4 OF SECTION 34, TOWN 2 NORTH,  
RANGE 17 EAST, TOWN OF GENEVA, WALWORTH COUNTY, WISCONSIN.

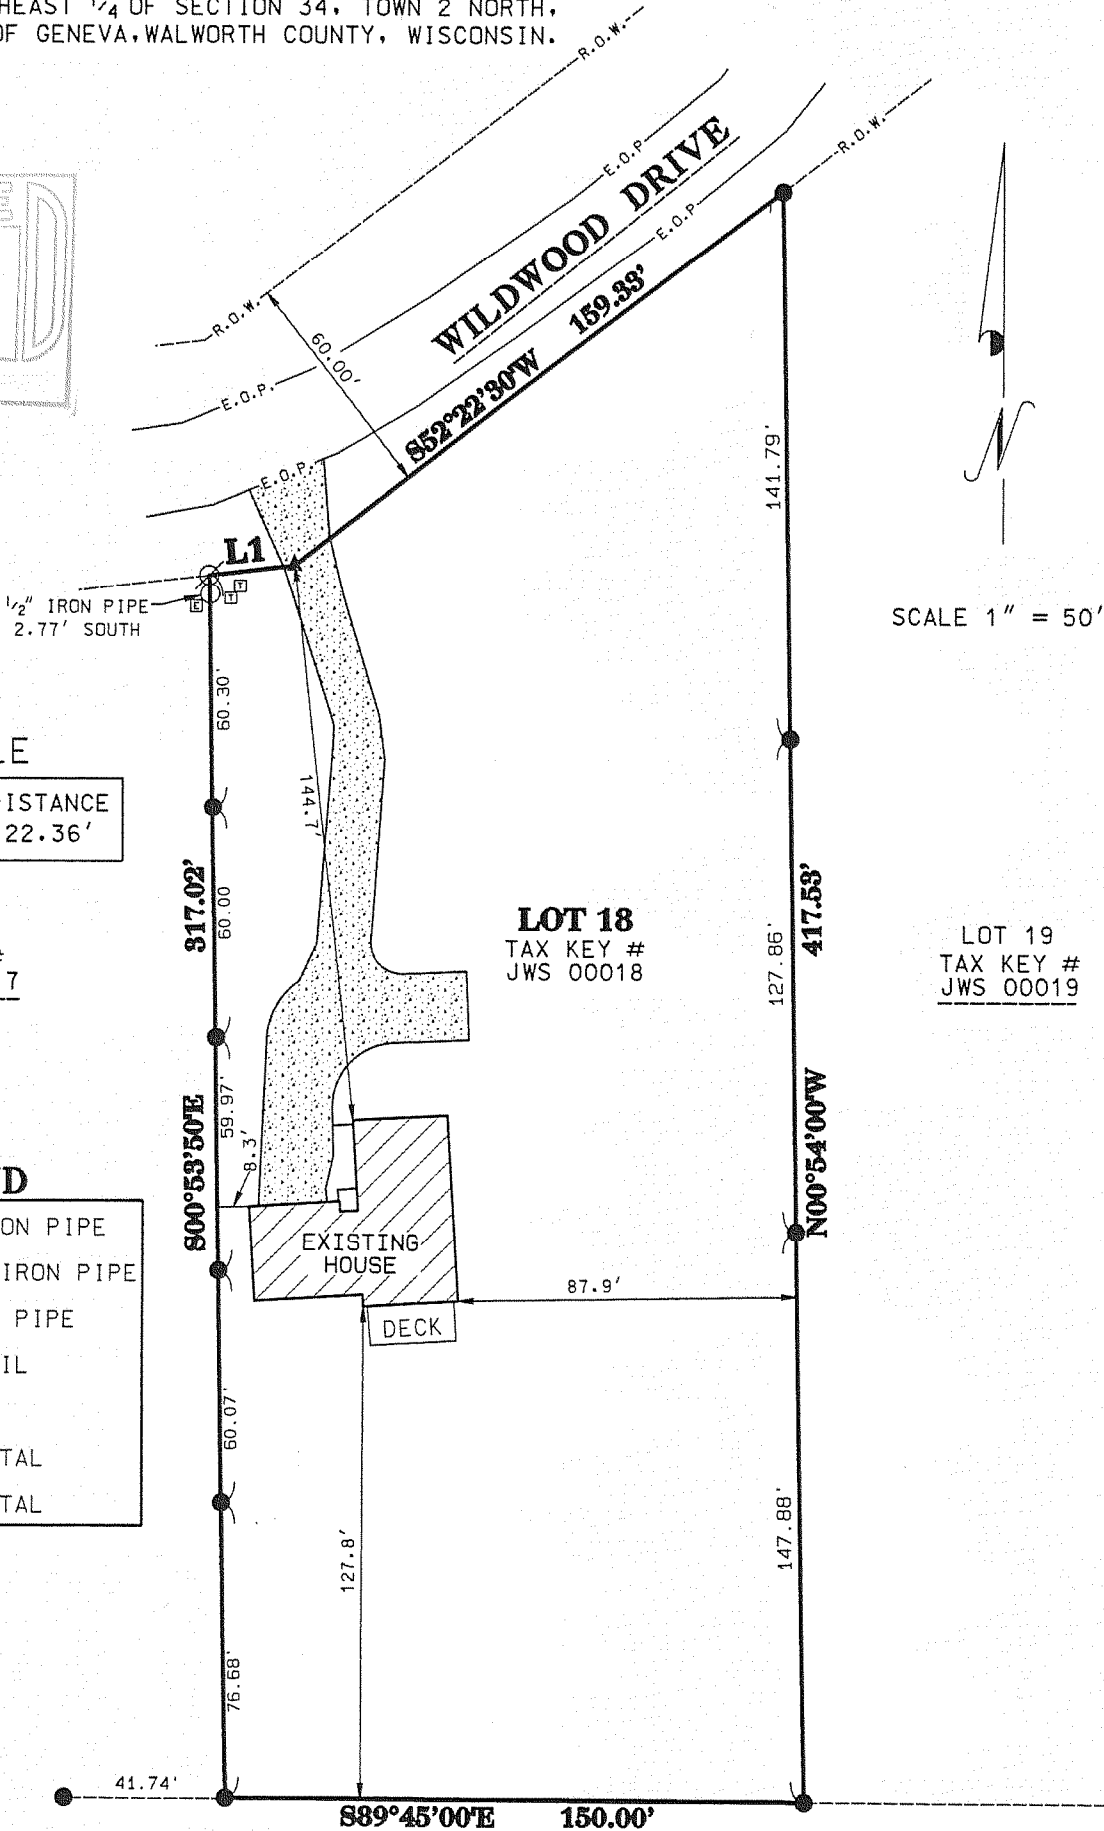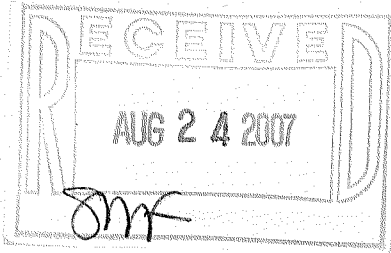

LINE TABLE

| LINE # | BEARING     | DISTANCE |
|--------|-------------|----------|
| L1     | S83°22'30"W | 22.36'   |

LOT 17  
TAX KEY#  
JWS 00017

LOT 18  
TAX KEY #  
JWS 00018

LOT 19  
TAX KEY #  
JWS 00019

LEGEND

- 1" FOUND IRON PIPE
- 0.5" FOUND IRON PIPE
- ⊙ 1" SET IRON PIPE
- ▲ SET "PK" NAIL
- CONCRETE
- ▣ TELE. PEDESTAL
- ▢ ELEC. PEDESTAL

I MICHAEL A. GREESON, R.L.S. # 2770 HEREBY  
CERTIFY THAT THIS SURVEY WAS MADE IN  
ACCORDANCE WITH THE MINIMUM STANDARDS FOR  
PROPERTY SURVEYS (CHAPTER A-E7) STATE OF  
WISCONSIN AND HAS BEEN PREPARED UNDER MY  
DIRECTION AND CONTROL AND IS CORRECT TO THE  
BEST OF MY KNOWLEDGE AND BELIEF.

*Michael A. Greeson*

MICHAEL A. GREESON, R.L.S. # 2770  
RSV# 07006 SURVEY

