



PLAT OF SURVEY

UNIT 3-18
GENEVA NATIONAL CONDOMINIUM
NO. 3



LOCATED IN TOWN 2 NORTH, RANGE 17 EAST
WALWORTH COUNTY, WISCONSIN

WORK ORDERED BY
CURT LANGILLE - LANCO DEVEL. CO.
7355 BANNOCKBURN CIRCLE
LAKEWOOD, IL 60014

FARRIS, HANSEN & ASSOCIATES, INC.
Engineering, Architecture, Surveying
7 Ridgeway Court P.O. Box 437
ELKHORN, WISCONSIN 53121
Office: (262) 723-2098
Fax: (262) 723-5886


REVISIONS
07/24/06
SITE, GRADING,
DRAINAGE, &
EROSION
CONTROL PLAN
4/5/2007-KB
MISC. REVISIONS

PROJECT NO.
3269.03.18
DATE:
04-09-04
SHEET NO.
1 OF 1

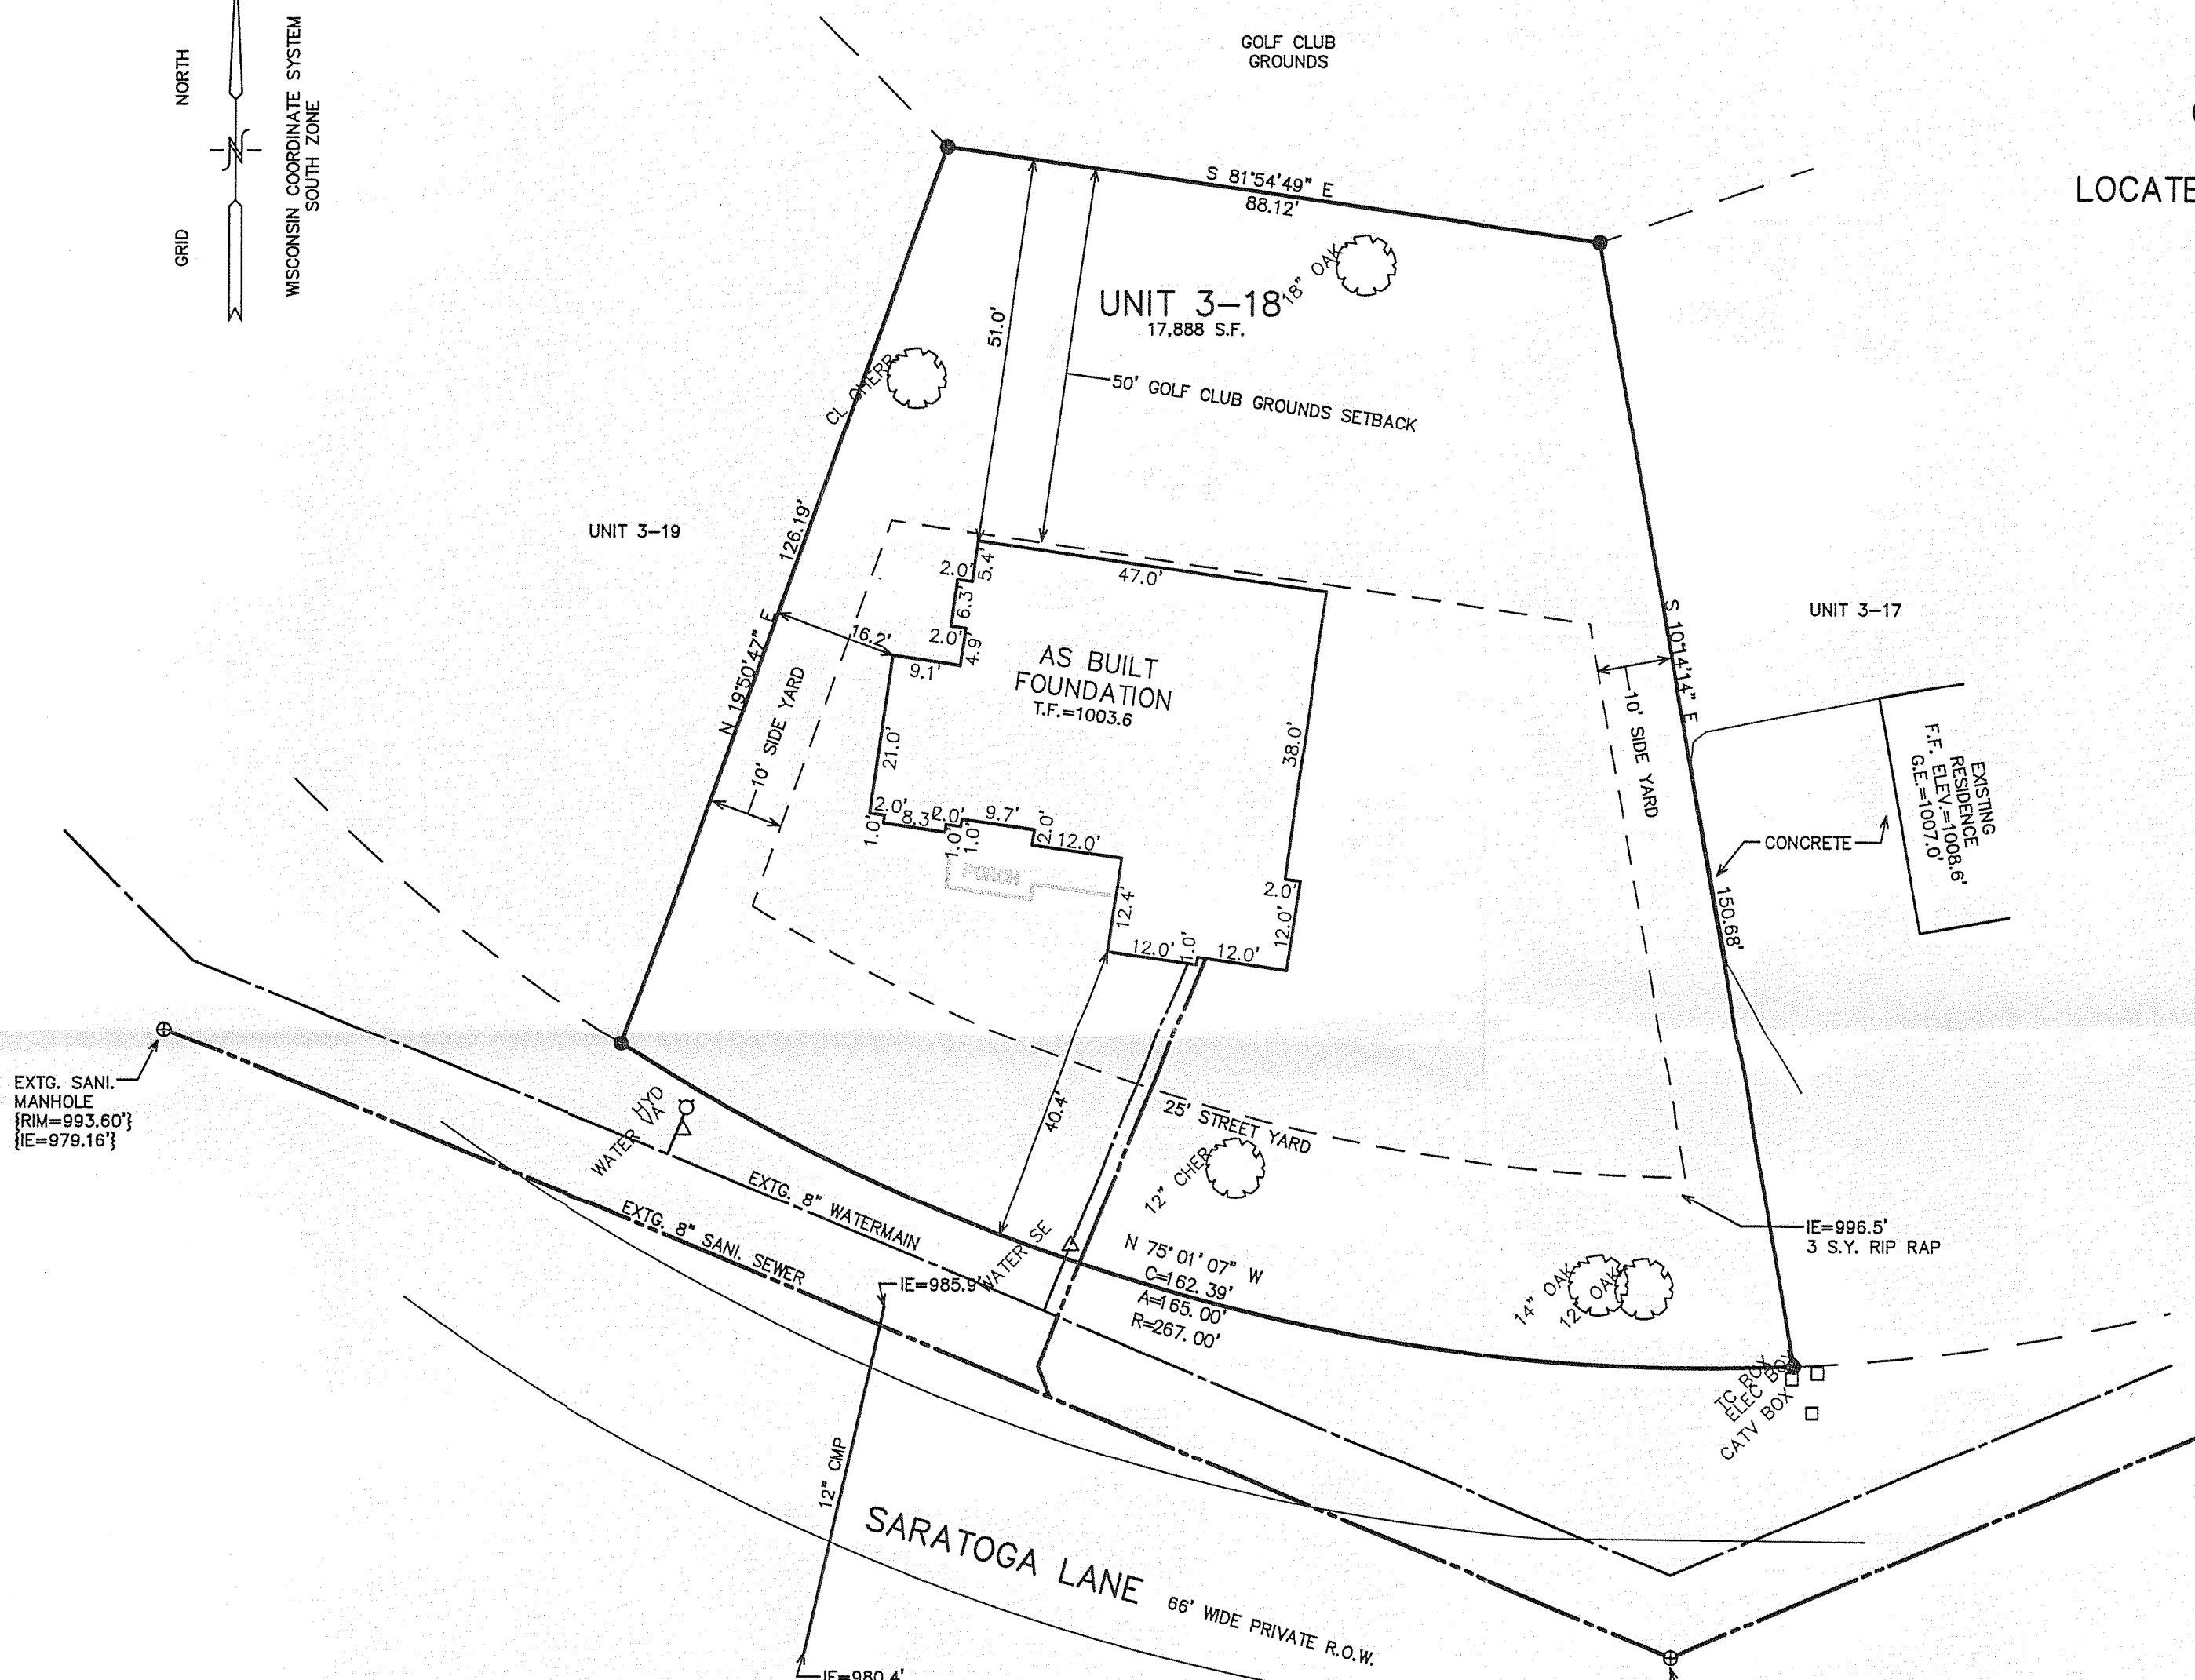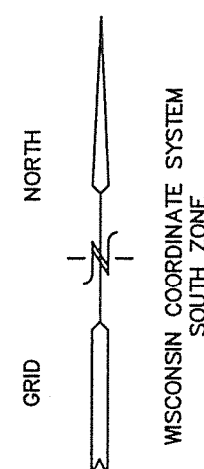

LEGEND


- = FOUND IRON REBAR STAKE
- (xxx) = RECORDED AS

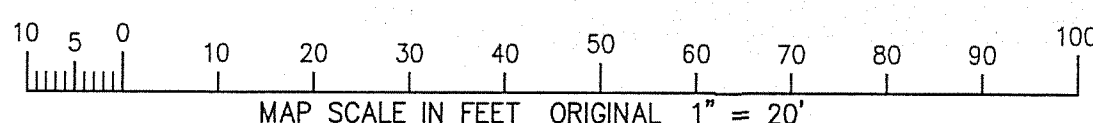

BENCH MARK
RIM SANITARY
MANHOLE
ELEV.=990.63'
{IE=976.08'}

NOTE: COPIES OF THIS MAP TO WHICH THE FOLLOWING CERTIFICATE WILL APPLY SHOW SURVEYOR'S ORIGINAL SEAL AND SIGNATURE IN RED INK. COPIES BY ANY OTHER MEANS MAY HAVE ALTERATIONS WHICH DO NOT REPRESENT THE SURVEYOR'S WORK PRODUCT.


I HEREBY CERTIFY THAT THE ABOVE DESCRIBED PROPERTY HAS BEEN SURVEYED UNDER MY DIRECTION AND THAT THE ABOVE MAP IS A TRUE REPRESENTATION THEREOF AND SHOWS THE SIZE AND LOCATION OF THE PROPERTY, ITS EXTERIOR BOUNDARIES, THE LOCATION OF ALL VISIBLE STRUCTURES, AND DIMENSIONS OF ALL PRINCIPLE BUILDINGS THEREON, BOUNDARY FENCES, APPARENT EASEMENTS, ROADWAYS, AND VISIBLE ENCROACHMENTS, IF ANY. THIS SURVEY IS MADE FOR THE USE OF THE PRESENT OWNERS OF THE PROPERTY, AND ALSO THOSE WHO PURCHASE, MORTGAGE, OR GUARANTEE THE TITLE THERETO WITHIN ONE YEAR FROM THE DATE HEREOF.

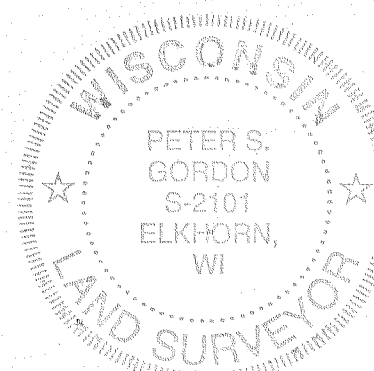

DATED: MAY 11, 2004

Peter S. Gordon
PETER S. GORDON R.L.S. 2101

REVISED 08-23-2007
TO SHOW SIZE & LOCATION OF
AS BUILT FOUNDATION

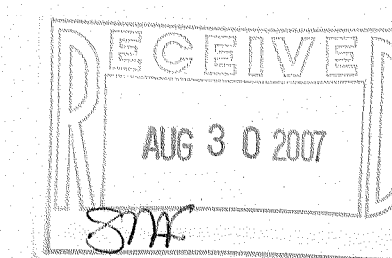

JGN 3-18

217-3432