


PREPARED FOR
RALPH R. & SHARON GRABER
W3246 SPRINGFIELD RD.
LAKE GENEVA, WI 53147

PLAT OF SURVEY

OF

LOT 1 CERTIFIED SURVEY MAP NO. 3915, A PARCEL OF
LAND LOCATED IN THE NORTHEAST 1/4 AND THE
NORTHWEST 1/4 OF THE SOUTHWEST 1/4 OF SECTION 14
, TOWN 2 NORTH, RANGE 17 EAST, TOWN OF GENEVA,
WALWORTH COUNTY, WISCONSIN.

PATHFINDER SURVEYING INC.
UNIT D W2888 KRUGER RD.
LAKE GENEVA WI. 53147

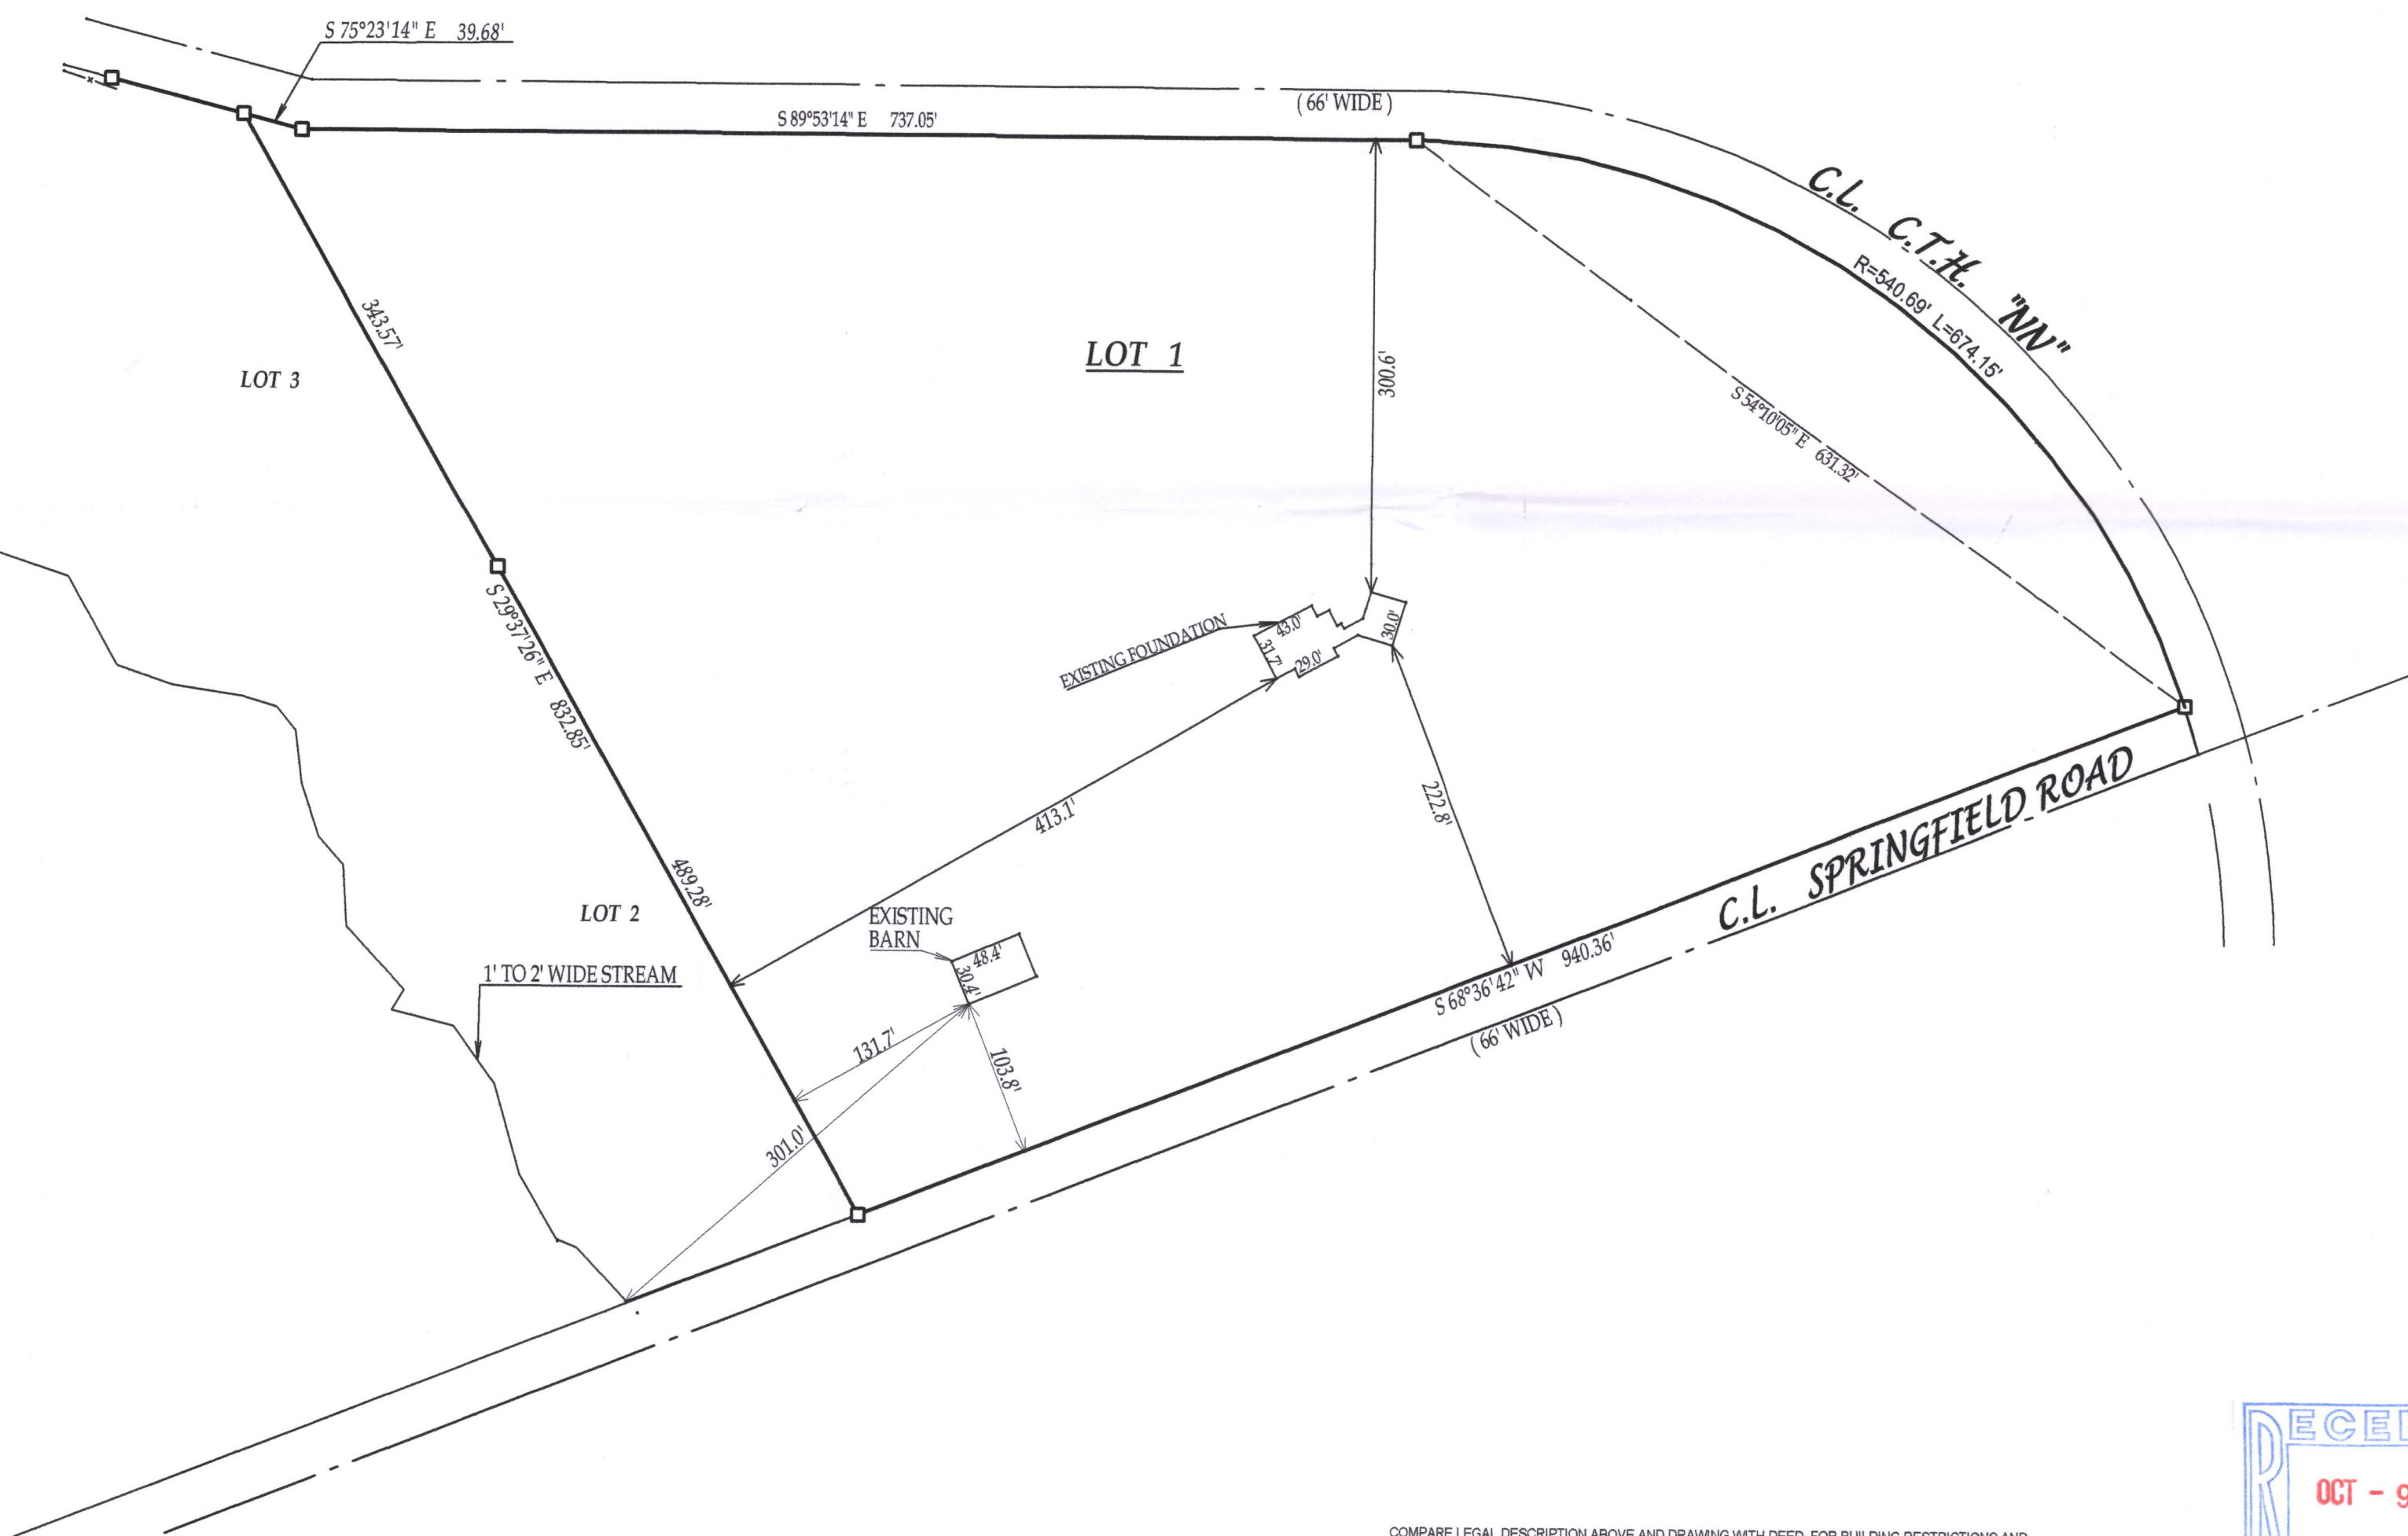

LEGEND
() = recorded as
⊙ = found 6\"/>

COMPARE LEGAL DESCRIPTION ABOVE AND DRAWING WITH DEED. FOR BUILDING RESTRICTIONS AND
EASEMENTS NOT SHOWN, REFER TO DEED, ABSTRACT SOURCES AND LOCAL MUNICIPAL CODES. NOTIFY
THE SURVEYOR IMMEDIATELY OF ANY DISCREPANCY.

"I hereby certify that I have surveyed the above described property and that,
to the best of my knowledge and belief the above map is a true
representation thereof and shows the size and location of all visible
structures, apparent easements and encroachments if any."
This survey is made for the present owners of the property, and those who
purchase, mortgage, or guarantee the title thereto, within one year from the
date hereof.



DATE OF LAST REVISION: 8/16/07

JOHN KROTT S - 2258
Wisconsin Registered Land Surveyor
(original if signed in red)

REVISED: 5 / 23 / 2007
REVISED: 4 / 20 / 2007
DATED THIS THE 13th DAY OF APRIL 2007.

217-3435